

Proj. No.: RA 140 DESIGN, BUILD, COMPLETE AND MAINTAIN SHEIKH JABER AL-AHMAD AL-SABAH CAUSEWAY PROJECT (MAIN LINK)	Employer: STATE OF KUWAIT MINISTRY OF PUBLIC WORKS	Request No. RA140-HDC-22-CBR- DRW-0025-03
Engineer's Representative:  dar al-handasah engineer and partners  SSH  TYLIN INTERNATIONAL	Contractor:  HYUNDAI ENGINEERING & CONSTRUCTION CO. LTD.	Date 13/02/2016

Transmittal of Design Drawing

1. Subject Description

Detailed Design - Main Bridge Pile Cap of Pylon Drawing Package

2. Submittal Details

Item Reference	Rev.	Description	Copies
RA140-22-BRG-CW-DW-32250	B4	Detailed Design - Main Bridge Pile Cap Of Pylon Drawing Package	1

NOTE

- Including Comment & Response Sheet
- Including SYSTRA & HDEC-CGCC Quality Control & Quality Assurance Checklist

These are transmitted for:

- ☐ Your information
 ☒ Approval
 ☐ Checking
 ☐ Review and Comment

We certify that the above drawings have been designed by Systra and consented by AECOM

Submitted by : Chan Soo Park / Project Director

Signature: 

3. Engineer's Approval

Refer to our comments on the attached comments and response sheets.

- ☐ Approved
 ☒ Approved as noted
 ☐ Revise and resubmit
 ☐ Rejected

Engineer's Signature: 

Date 28 / 3 / 2016

Approval shall not relieve Contractor of his liabilities under the Contract or constitute authorization of any change to Contract Documents.

RA140-HDC-22-CBR-DRW-0025-03

Comment & Response Sheet


Document No: RA140-22-BRG-CW-DW-32250-B4-DR4/C

Ref. Transmittal No : RA140-HDC-22-CBR-DRW-0025-00 (Rev. 00); RA140-HDC-22-CBR-DRW-0025-01 (Rev. 01);
 RA140-HDC-22-CBR-DRW-0025-02 (Rev. 02); RA140-HDC-22-CBR-DRW-0025-03 (Rev. 03);
 Ref. Report No & DWG package No : RA140-22-BRG-CW-DW-32250-B4
 Document title : DETAILED DESIGN – MAIN BRIDGE PILE CAP OF PYLON DRAWING PACKAGE
 Comments Issued by & date : T.Y. Lin International (Griffith, Rodriguez) on 21 March, 2016
 Answer Issued by & date :
 Consent Classification : B (A: Consented to, authorized to proceed / B: Consented to, subjected to comments / C: Revise & Resubmit, incorporate comments
 W: Rejected, not consented to, reason Noted)

No.	Rev.	Reference		Comment rev. ²	Comment	Response	Cat. ¹	Status ³
1	A4	32262	Plan View ("3", "4")	1 st comment	Layers 3 through 12 need to include a detailed study of the conflict resolution between the bottom mats of steel and the pile bars. Please add additional details.	The bottom mats of steel (Layer 3~12) will be arranged in order to avoid the clash with the pile bars as shown in the drawing, RA140-22-BRG-CW-DW-32278. Please refer to the Appendix #1. Based on the scheme drawing, we will prepare and submit a construction drawing.	2	
				2 nd comment	The solution of high precision bending of bars to match an as-built condition in the field seems overly optimistic. It is recommended to provide a solution which has a higher degree of tolerance for field adjustments.	As-built condition in the field must be different with the design, so any solutions at design stage may not satisfy the site condition perfectly. We will process rebars with bending machine on site using actually surveyed results.		BB
	B1			3 rd comment	Any significant field modifications to reinforcement steel to resolve conflicts must be reviewed and approved by the Designer for compliance with the design. If modifications result in changes to the design, the changes must also be reviewed and approved by the ICE.	Noted. The change of reinforcement arrangement to resolve conflict or adjust to the field condition, requested by Contractor has been reviewed and approved by Designer and ICE.		BB
				4 th comment	Please provide documentation of the reviews by Designer and ICE.			BB

- 1) Category : Cat 0 = Observation / Note, Cat 1= Information Required Only, Cat 2= Major Comment / Revision Required
 2) Comment Rev.: 1st comment, 2nd comment...
 3) Comment Status after response: AA = Resolved, implemented and closed, BB = Resolved – not yet implemented, CC = Unresolved

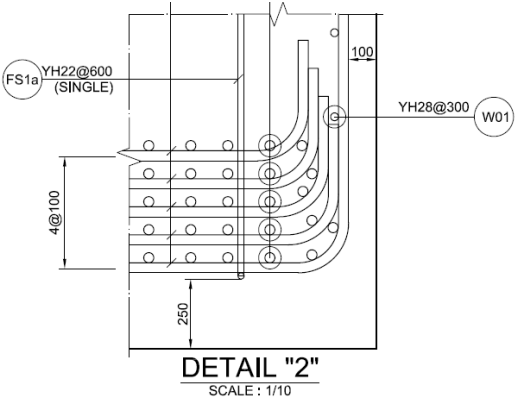

2	A4	32264	Reinforce ment Layer	1 st comment	The bottom mats of steel will become very congested and difficult to place near the hooks at the perimeter of the pile cap. Consider using headed bars for improved performance or provide detailed conflict resolution showing longitudinal transverse and vertical bars.	The detailed view of the conflict resolution showing longitudinal transverse and vertical bars are provided in DETAIL "2" of DW-32269. 	1	
				2 nd comment	The detail is incomplete. The pile cap is circular and as such the transverse bars will not be placed as shown. They will be terminating and bent up along the same face as the longitudinal bars. The resolution must be a 3D solution which resolves conflicts with all the mats of steel.	Please refer to Attachment #1 which is our 3D solution for the hook of bottom reinforcement. This solution will be incorporated in construction drawings.		BB
	B1			3 rd comment	3D views are shown at the edges of the pile cap near the longitudinal and transverse axes, however hooks may create an even more congested situation at a 45-degree axis through the pile cap. Consider using headed bars in one direction to ease congestion. Ensure concrete can be placed properly leaving no voids.	This has been developed in shop drawings.		BB
				4 th comment	Noted, shop drawings to be verified by site management.			BB

1) Category : Cat 0 = Observation / Note, Cat 1= Information Required Only, Cat 2= Major Comment / Revision Required

2) Comment Rev.: 1st comment, 2nd comment...


3) Comment Status after response: AA = Resolved, implemented and closed, BB = Resolved – not yet implemented, CC = Unresolved



3	A4	32268	Section C-C	1 st comment	Layers 3 through 12 are not developed at the face of pile. Add hooks or heads.	Hooks will be added to the Layer 8~12 without hooks at the face of the pile as commented. Please refer to the Appendix #2.	2	
				2 nd comment	The detail is incomplete. The pile cap is circular and as such the transverse bars will not be placed as shown. They will be terminating and bent up along the same face as the longitudinal bars. The resolution must be a 3D solution which resolves conflicts with all the mats of steel.	Please refer to our answer to comment #2.		CC
	B2			3 rd comment	Refer to comment #2.	This has been developed in shop drawings.		AA
4	A4	32276	Section B-B	1 st comment	Include a detailed study of the conflict resolution between the bottom mats of tie beam steel and the pile bars. Please add additional details.	Based on the scheme drawing of RA140-22-BRG-CW-DW-DW-32278, we will prepare and submit a construction drawing.	2	
				2 nd comment	The solution of high precision bending of bars to match an as-built condition in the field seems overly optimistic. It is recommended to provide a solution which has a higher degree of tolerance for field adjustments.	Please refer to our answer to comment #1.		BB
	B2			3 rd comment	Refer to comment #1.	Noted. The change of reinforcement arrangement to resolve conflict or adjust to the field condition, requested by Contractor has been reviewed and approved by Designer and ICE.		AA
5	A4	32282	View-1	1 st comment	Top and bottom tie beam bars are not developed beyond the point where they are no longer needed. Please extend the bars farther into the pile cap section.	The top and the bottom beam bars are extended to secure required development length. Please refer to the Attachment #3.	2	
				2 nd comment	These bars are very long and will require mechanical couplers. Please revise the drawings to show the location of the	The length of the PT bars which conflict with tie beam bars will be reduced to 9.7m from 10.0m to avoid the rebar crash.		CC

- 1) Category : Cat 0 = Observation / Note, Cat 1= Information Required Only, Cat 2= Major Comment / Revision Required
2) Comment Rev.: 1st comment, 2nd comment...
3) Comment Status after response: AA = Resolved, implemented and closed, BB = Resolved – not yet implemented, CC = Unresolved

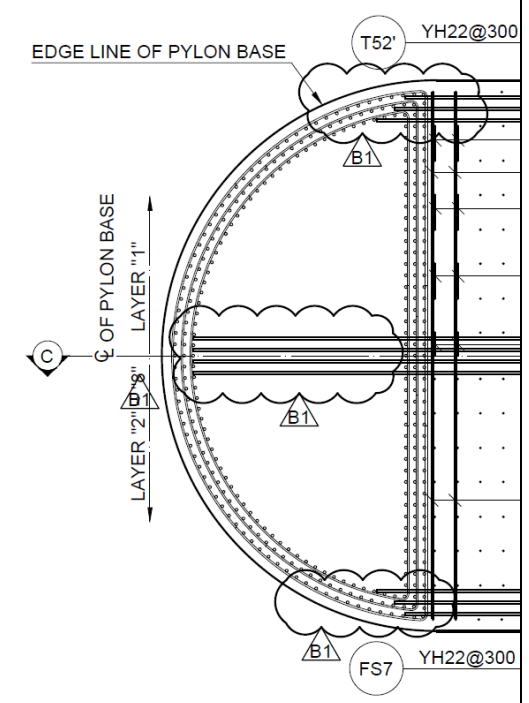

					couplers and the staggering. There are also conflicts apparent between these bars and the PT bars from the back leg anchors. Provide detail of the conflict resolution.	Then, the tie beam bars will not conflict with PT bars from the back leg anchors. The tie beam bars will be extended with lap splices and the locations of lap will be presented in construction drawings.		
	B2			3 rd comment	Noted. Please ensure lap splices are staggered.	This has been developed in shop drawings.		BB
				4 th comment	Noted, shop drawings to be verified by site management.			BB
6	A3	32288	Section B-B (Layer "1" ~ "8" - P3-M Side	1 st comment	Provide detail view showing conflict resolution between pylon bars and upper tie beam bars.	<p>The details of the reinforcement interference have been revised.</p> 	2	
				2 nd comment	The details in the drawing do not match the details in the response. Please update the cad files for consistency.	Drawing will updated as same as details shown on the previous response which demonstrates that the rebar conflicts can		BB


- 1) Category : Cat 0 = Observation / Note, Cat 1= Information Required Only, Cat 2= Major Comment / Revision Required
2) Comment Rev.: 1st comment, 2nd comment...
3) Comment Status after response: AA = Resolved, implemented and closed, BB = Resolved – not yet implemented, CC = Unresolved



					The detail attached in the response shows the bars have been shifted to avoid conflict with the pylon bars but the Attachments to the response indicate the same bars are being shifted to a different configuration and bent to avoid conflict with the pile bars. Please include a complete resolution scheme which addresses both sources of conflict.	be easily resolved. Pile bars will not be extended to that level, so no shift is required to avoid them.		
	B1			3 rd comment	Response is noted.			AA
7	A3	32291		1 st comment	The reinforcement shown is not consistent with the design calcs which show the upper bars being developed completely into the front and back leg of the pylon. Please extend the bars all the way through the compression block of the pylon front and back legs.	Noted. According to the design calculation, the upper bars are extended into the pylon front and back legs. Please refer to the Attachment #3.	2	
				2 nd comment	These bars are very long. Provide details for location and staggering of mechanical couplers.	Please refer to our answer to comment #5.		CC
	B2			3 rd comment	Noted. Please ensure lap splices are staggered.	This has been developed in shop drawings.		BB
				4 th comment	Noted, shop drawings to be verified by site management.			BB
8	A3	32292	Section D-D	1 st comment	Please add a plan view of critical interfaces of vertical and horizontal mats of steel to verify that the bars can be placed consistent with design.	The drawing is about pylon base. The plan view of the circular pilecap reinforcement is provided in DW-32264 and DW- 32265. Please refer to the Attachment #4. The bottom mats of steel (Layer 3~12) will be arranged in order to avoid the clash with the pile bars as shown in the drawing, RA140-22-BRG-CW-DW-DW-32278. Based on the scheme drawing of RA140-22-BRG-CW-DW-DW-32278, we will prepare and submit a construction drawing.	2	


- 1) Category : Cat 0 = Observation / Note, Cat 1= Information Required Only, Cat 2= Major Comment / Revision Required
2) Comment Rev.: 1st comment, 2nd comment...
3) Comment Status after response: AA = Resolved, implemented and closed, BB = Resolved – not yet implemented, CC = Unresolved

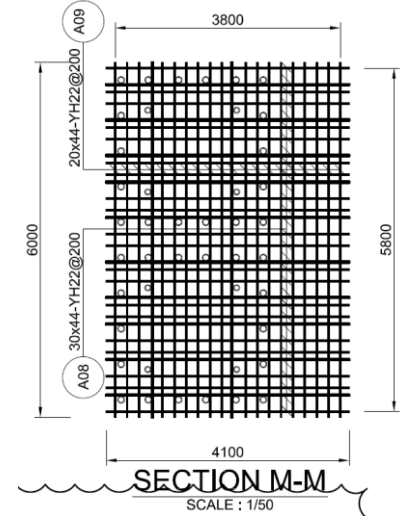

				2 nd comment	Response is noted.	Noted.		BB
9	A3	32295	Bursting Reinforce ment Detail	1 st comment	Provide detailed conflict resolution study for the multiple mats of reinforcement and the PT bars in intersecting orientations.	<p>The PT bars have been rearranged, and the details reflecting conflict resolution have been provided in Section M-M.</p> 	2	
				2 nd comment	The conflict between the PT bars appear to be resolved but the new details have introduced numerous additional conflicts between the reinforcement in the anchorage zones. Please provide the resolution concept.	<p>Spirals for individual PT bars will be removed because a large base plate for the group PT bars will be used instead of individual base plate for each PT bar and bursting reinforcement provided can perform the role of the spirals.</p> <p>Rebar conflicts between PT bars and mat reinforcement can be resolved with small adjustment of reinforcement location.</p> <p>Please refer to the Attachment #2 which is BIM study for this area.</p>		CC
	B2			3 rd comment	Noted. It is unclear how the PT bars and reinforcement are assembled without conflicts and enabling concrete to be placed without voids. Provide details and method statements.	<p>PT bars will be installed with PT bar frame to set them up at their exact position and then, reinforcement will be assembled to avoid PT bar and PT bar frame later. Shop drawing considering this condition will be submitted before construction.</p>		BB

- 1) Category : Cat 0 = Observation / Note, Cat 1= Information Required Only, Cat 2= Major Comment / Revision Required
- 2) Comment Rev.: 1st comment, 2nd comment...
- 3) Comment Status after response: AA = Resolved, implemented and closed, BB = Resolved – not yet implemented, CC = Unresolved

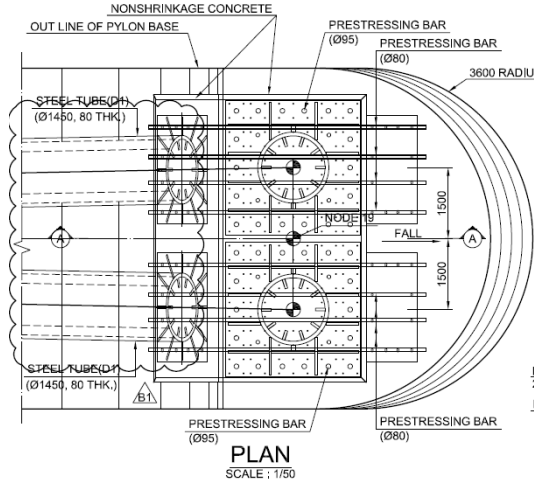

	B4			4 th comment	Noted, shop drawings to be verified by site management.			BB
10	A3	32299	Plan	1 st comment	Multiple conflicts are shown in PT bars. Please provide detailed conflict resolution drawing including the mild reinforcement in the section showing that it is constructible.	Due to the conflict issue among PT bars, they have been rearranged in square as shown below. In addition, conflict resolution will be taken into account in a construction drawing so as to prevent interference between PT bars and reinforcement.	2	
								
				2 nd comment	The conflict between the PT bars appear to be resolved but the new details have introduced numerous additional conflicts between the reinforcement in the anchorage zones. Please provide the resolution concept.	Please refer to our answer to comment #9.		CC
	B2			3 rd comment	Refer to comment #9	Please refer to our answer to comment #9.		AA
11	A3	32299	Section D-D	1 st comment	Please explain the purpose of the rubber ring.	The rubber ring is placed at the nut cap for waterproofing of the PT bars.	1	
				2 nd comment	Please verify the rubber ring can carry the prestressing load. The ring appears to be placed between the nut and the	The rubber ring is only a rubber washer which is a component of nut cap. The rubber ring will not carry the prestressing		CC

- 1) Category : Cat 0 = Observation / Note, Cat 1= Information Required Only, Cat 2= Major Comment / Revision Required
2) Comment Rev.: 1st comment, 2nd comment...
3) Comment Status after response: AA = Resolved, implemented and closed, BB = Resolved – not yet implemented, CC = Unresolved



					bearing plate which requires all the PT load to be carried through the ring. Provide calculations for the system or a reference to the use of the detail in a code certified application by the supplier. The certifications in the attachments 5 and 6 do not appear to cover these items.	load of PT bar. Please be informed that the details shown on the drawing are indicative. The system details and construction method should be provided by a supplier, but he is not yet decided. Construction of PT bars is scheduled at January 2016 and the method statement including supplier's system details and construction method will be submitted to ER one month or earlier before commencement of construction.		
	B2			3 rd comment	Noted, however as shown rubber ring appears to be under the nut in the load path, please clarify. Submit system details and construction method when supplier is selected.	The rubber ring shown on the drawing is indicative only. Selected supplier is Freyssinet and they confirmed that rubber ring wouldn't be required. It will be reflected in the shop drawing.		BB
	B4			4 th comment	Noted, shop drawings to be verified by site management.			BB
12	A3	32299	Section D-D	1 st comment	Clarify protection for durability of the exposed base plate and PT bars.	For such protection, grouting and nut cap are applied to the PT bars and painting is applied to the base plate.	2	
				2 nd comment	Response is noted. Please confirm that the general notes sheets that cover these drawings include the specific materials and coatings for these items or add specific notes to the sheet.	Please be informed that all materials used in the project should be approved by ER before its application. Notes for specific materials and coatings will be added in construction drawing as well as method statement after a system supplier is selected.		BB
	B2			3 rd comment	Provide materials and coatings data as well as method statement when system supplier is selected.	Selected supplier is Freyssinet. Please refer to the attached the technical sheet from Freyssinet. Method statement will be submitted soon.		BB
	B4			4 th comment	The plans should define the corrosion protection requirements the supplier shall comply with. Please indicate the drawings where corrosion protection is defined in response to this comment.			BB


- 1) Category : Cat 0 = Observation / Note, Cat 1= Information Required Only, Cat 2= Major Comment / Revision Required
2) Comment Rev.: 1st comment, 2nd comment...
3) Comment Status after response: AA = Resolved, implemented and closed, BB = Resolved – not yet implemented, CC = Unresolved



13	A3	32299	Section D-D	1 st comment	Provide details on how the PT bars are installed and stressed. Provide grout inlet tube and vent tube for the sleeves and system of drainage from the sleeve. Provide specification for filling cement mortar and sleeve.	The PT bars are pre-assembled with temporary fixing structures, inside of the sleeve for grouting. Detailed installation procedure will be included in the corresponding construction method statement. For the filling cement mortar and sleeve, the materials which ER approved for tendon will be used. Please refer to the Attachment #5 and #6.	2	
				2 nd comment	The specific installation of these items needs to be included on the drawings to ensure they are correctly placed in the field.	Noted.		BB
	B4			3 rd comment	Please update the drawings accordingly and note in response to this comment which drawings include the information requested.			BB
14	A3	32299	Section D-D	1 st comment	Please explain the purpose of the bar coupler	Since bar couplers are unnecessary for the PT Bar installation, they have been deleted from the drawing.	1	
				2 nd comment	Response is noted.			AA
15	A3	32299	Section A-A	1 st comment	How is the bar threaded in the bottom nut after concrete casting? Please clarify.	The PT bars are to be pre-assembled with temporary fixing structures, such as steel frames, to secure precise location of the PT bars during installation and construction. Accordingly, threading of the PT bars is to be done prior to the concrete casting at the factory or site yard. (Detailed installation procedure will be included in the corresponding construction method statement.) Thus, no threading issue into the bottom nut is foreseen.	1	
				2 nd comment	Please provide at least a draft version of the method statement which includes the details from comments 9 to 15. The response indicates the PT bars will be	Please refer to our answer to comment #11. For your reference, outline of work sequence of PT bar installation has been		CC

- 1) Category : Cat 0 = Observation / Note, Cat 1= Information Required Only, Cat 2= Major Comment / Revision Required
2) Comment Rev.: 1st comment, 2nd comment...
3) Comment Status after response: AA = Resolved, implemented and closed, BB = Resolved – not yet implemented, CC = Unresolved




					<p> tied into the rebar cage inside the ducts during placement of the rebar cage. Provide an estimated duration that the ungrouted bars will be on site inside the ducts where they cannot be inspected or cleaned of rust prior to concrete placement. A comprehensive durability strategy needs to be presented to address both the construction stages as well as service life. </p>	<p>presented in Attachment #3.</p> <p>Regarding durability issue, corrosion protection measure like lamellar zinc coating will be applied to PT bars. In addition, HDPE duct will be sealed with cap or tape as a picture below.</p>  <p> All details for corrosion protection also will be included in the method statement to be submitted later. But, you should note that galvanized PT bars have been used without additional protection in many other projects. </p>		
	B2			3 rd comment	Noted. Provide details and method statements.	<p>Please refer to our answer to comment #12. For corrosion protection, epoxy coating instead of galvanizing, cement grouting inside PP duct and sealing cap will be used. Method statement will be submitted soon.</p>		BB
	B4			4 th comment	The plans should include the required corrosion protection. Please indicate which plan sheets include this information.			BB
16	B4	32295	Section N-N	1 st comment	Please provide dimensions for the proposed hole in the anchor plate.		1	

- 1) Category : Cat 0 = Observation / Note, Cat 1= Information Required Only, Cat 2= Major Comment / Revision Required
- 2) Comment Rev.: 1st comment, 2nd comment...
- 3) Comment Status after response: AA = Resolved, implemented and closed, BB = Resolved – not yet implemented, CC = Unresolved



SYSTRA – QUALITY CONTROL & QUALITY ASSURANCE CHECKLIST											
Reference	RA140-QFM-06067/2016-02-12-HSH										
PACKAGE :	34k	MAIN BRIDGE - SUBSTRUCTURE									
Document reference	Revision	Title 1	Title 2	Title 3	Required Action by ER		Basic Design Comments Integrated	Detailed Design Comments Integrated	ICE Comment Sheets Included	ICE Reports included	Status (Consented by ER)
		MAIN BRIDGE	SUBSTRUCTURE		For Review	For Information					
RA140-22-BRG-CW-TR-32853	B2	MAIN BRIDGE - SUBSTRUCTURE	STEEL-CONCRETE CONNECTION DESIGN AT PYLON BASE	Technical Report	✓		✓	✓	N/A	N/A	
RA140-22-BRG-CW-DW-32250	B4	MAIN BRIDGE - SUBSTRUCTURE	PILE CAP OF PYLON DRAWING PACKAGE	Drawing Package	✓		✓	✓	✓ (on A4)	✓ (on A4)	✓
Reference of ER comments integrated this submission (Comment and Response Sheets Included) :			RA140-HDC-22-CBR-TCR-0095-02 RA140-HDC-22-CBR-DRW-0025-02 								
Sysyra hereby certifies that this submission fulfil Sysyra quality control requirements and procedures :			Drawings and reports/calculations have been compared and are consistent	✓							
			Drawings filled properly	✓							
			Drawings checked for technical adequacy, legibility, mathematical and drafting accuracy	✓							
			Drawings are in agreement with other disciplines	✓							
			Conformance with Design Basis and applicable design specification	✓							
			Revisions have been clouded	✓							
			Drawings were properly checked using color codes (Red, Green, Yellow).	✓							
			Dimensions and units correct and consistent	✓							
REMARKS											

DATE	12/02/2015
NAME	Hyun-Seok Hong
SIGNATURE	

HDEC & CGCC - Quality Control and Assurance Checklist for RA140 Project

HDEC & CGCC certifies that this submission is properly reviewed by quality control process

SYSTRA QFM are properly filled	√
Consistency of the drawings and reports	√
Composition of the document and typographical error are properly reviewed	√
Drawing list and revision are properly checked	√

Completeness of the package

Related Document

Document No.	Rev.	Title	Transmittal No.	Submission Date
RA140-22-BRG-CW-DW-32250	B4	Detailed Design – Main Bridge Pile Cap Of Pylon Drawing Package	RA140-HDC-22-CBR-DRW-0025-03	14-Feb-16
RA140-22-BRG-CW-DW-32853	B2	Steel - Concrete Connection Design at Pylon Base P3'-M	RA140-HDC-22-CBR-TCR-0095-04	14-Feb-16

REMARKS

DateQC EngineerSignature

13-Feb-16YOO DONG YUN





Contract RA-140 - Sheikh Jaber Al-Ahmad Al-Sabah Causeway Project – Main Link

Submission Ref. No.	RA140-TRS-1510	Title: Main Bridge Pile Cap of Pylon (RA140-22-BRG-CW-DW-32250-A4)
Response Ref. No.	EKHC:AKML:60290056/8.2-2015005390T	

Response:	No adverse comment	<input checked="" type="checkbox"/>
	Agree in Principle with minor Comments	<input type="checkbox"/>
	Insufficient Information to proceed with Review	<input type="checkbox"/>
	Major non-conformity found	<input type="checkbox"/>

Remarks:

For detail please refer to the attached ICE report.

Exclusion:

- All construction information such as bar bending schedules, taking off information, locations of couplers/lapping and etc are all excluded in the review.

From : AECOM

Name : Edward K.H. Chan

Signature : 

Date : 22-Jun-15

The Design, Build, Completion and Maintain

Sheikh Jaber Al-Ahmad Al-Sabah Causeway Project (Main Link) Contract No. RA140

Kuwait

ICE Check Report for Detailed Design Stage

TRS-1510 Main Bridge Pile Cap of Pylon Drawing Package



Contents

1. List of Documents Checked	3
2. Contract Documents used in the Checking	3
3. Frozen Scheme Reference in Basic Design Stage	3
4. Standards and Codes of Practice used in the Checking	3
5. List of Non-Conformance Findings	3

Appendices

Appendix A List of Non-conformance

1. List of Documents Checked

	Transmittal Number/Document No.	Title
Design Package	TRS-1510	Main Bridge Pile Cap of Pylon
Drawings Package	Drawing package No.: RA140-22-BRG-CW-DW-32250-A4	Detailed Design –Main Bridge Pile Cap of Pylon Drawing Package A1

2. Contract Documents used in the Checking

a) Document III.1: General Specifications

- MPW, Roads Administration: General Specifications for Kuwait Motorway/Expressway System, August 2004 and amendments until Tender closing date.
- AASHTO LRFD Bridge Construction Specifications, 2nd Edition 2004, including 2009 Interim Revisions
- General Specifications for Buildings and Engineering Works for Ministry of Public Works year 1990 and amendments until Tender closing date.

b) Document III.2: Particular Specifications Revision 2M

c) Document III.3: Design Criteria Revision 2M

d) Geotechnical Factual Report: Soil Investigation for Port Interchange (PI) Port Bridge (PB) Ghazali Transition (GT)

3. Frozen Scheme Reference in Basic Design Stage

Package/Document No.	Package / Document Title
RA140-22-BRG-CW-DW-32300-A3	Main Bridge Pier
RA140-22-BRG-CW-DW-32250-A4	Main Bridge Pile Cap of Pylon
RA140-10-BRG-CW-TR-00814-B3	Design Basis-Bridge
RA140-10-BRG-CW-TR-00807-A5	Durability Study Plan
RA140-10-BRG-CW-TR-00808-B1	Durability Study

4. Standards and Codes of Practice used in the Checking

AASHTO LRFD Design Specifications SI Units 4th Edition 2007

5. List of Non-Conformance Findings

See Appendix A

Appendix A

List of Non-conformance

ICE Check Report – List of Comments or Non-conformances


Document No : RA140-22-BRG-CW-DW-32250-A4-ICE41C

Ref. Transmittal No	: TRS-1510
Ref. Report No & DWG package No	: RA140-22-BRG-CW-DW-32250-A4
Document title	: Detailed Design –Main Bridge Pile Cap of Pylon Drawing Package
Comments Issued by & date	: Commented by Guoxiong Yu on 19 th May 2015, 2 nd comment on 2 nd June 2015, 3 rd comment on 16 nd June 2015, 4 th comment on 19 nd June 2015
Answer Issued by & date	:
Consent Classification	: A (A: No adverse comments / B: Agree in Principle with minor comments / C: Insufficient Information to proceed with review / W: Major Non-conformity found, revision required)

No.	Rev.	Reference	Comment rev.	Comment or Non-Conformance	Response	Cat. ¹
1	A1	P3-M pile cap Structural nominal resistance of a tension tie (N)	1 st	<p>From the STM checking result, it is found that at the bottom of the P3-M pile cap under the Extreme limit state, longitudinal tie-reinforcement of Y36@150mm with 7 layers in the center zone cannot satisfy the nominal resistance of a tension tie (N) according to AASHTO 5.6.3.</p> <p style="text-align: center;">Tension force = 68799.8 kN > P_r = 66463 MPa ∴ N.G</p>	The longitudinal tie reinforcements with 8 layers were arranged in the zone. However, a total of 10 layers of reinforcements (2 layers added) are arranged considering ICE's comment.	2
	A2		2 nd	No further comment.	Noted.	A

¹)Category : Cat A = Agreed with response, Cat 0 = Observation / Note Cat 1 = Minor Comment Cat 2 = Major Comment / To be resolved


²)Comment Rev. : 1st comment, 2nd comment ...

Verified by: 

ICE Check Report – List of Comments or Non-conformances

Document No : RA140-22-BRG-CW-DW-32250-A4-ICE4IC

Ref. Transmittal No	: TRS-1510
Ref. Report No & DWG package No	: RA140-22-BRG-CW-DW-32250-A4
Document title	: Detailed Design –Main Bridge Pile Cap of Pylon Drawing Package
Comments Issued by & date	: Commented by Guoxiong Yu on 19 th May 2015, 2 nd comment on 2 nd June 2015, 3 rd comment on 16 nd June 2015, 4 th comment on 19 nd June 2015
Answer Issued by & date	:
Consent Classification	: A (A: No adverse comments / B: Agree in Principle with minor comments / C: Insufficient Information to proceed with review / W: Major Non-conformity found, revision required)

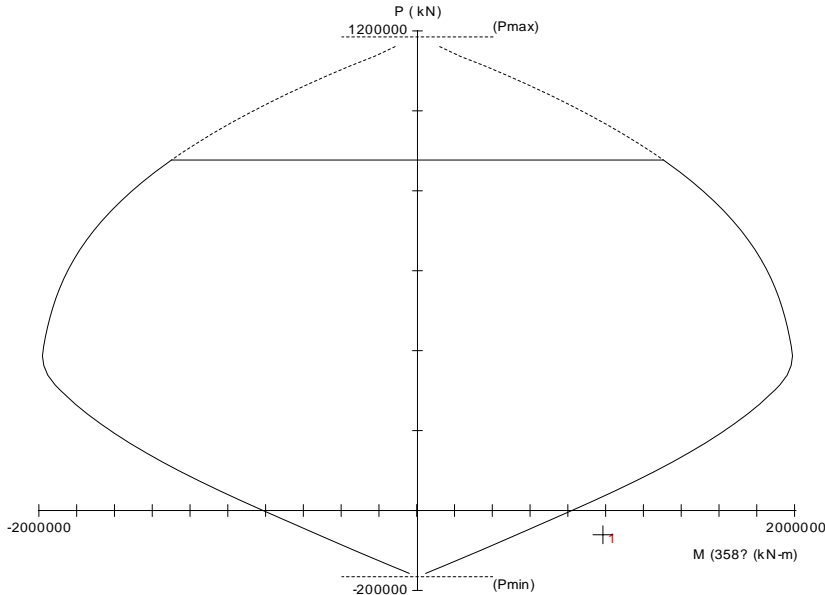No.	Rev.	Reference	Comment rev.	Comment or Non-Conformance	Response	Cat. ¹
2	A1	Tie-beam Structural bending and axial capacity	1 st	<p>In the Tie-beam of pylon, summary of the biaxial bending and axial force checking can be shown by the M-N diagrams below, the structural biaxial bending and axial capacity of tie-beam of pylon cannot satisfy requirement under Extreme event state. Please clarify.</p> <p>- Section A-A (case-1 : Extreme Event- Longitudinal Earthquake) : N.G</p> 	<p>A total of 8 layers and 5 layers of reinforcements were arranged at the top and the bottom of section A-A, respectively, considering ICE's comment.</p>	2

¹)Category : Cat A = Agreed with response, Cat 0 = Observation / Note Cat 1 = Minor Comment Cat 2 = Major Comment / To be resolved


²)Comment Rev. : 1st comment, 2nd comment ...

Verified by: 

ICE Check Report – List of Comments or Non-conformances

Document No : RA140-22-BRG-CW-DW-32250-A4-ICE4IC


Ref.Transmittal No	: TRS-1510
Ref. Report No & DWG package No	: RA140-22-BRG-CW-DW-32250-A4
Document title	: Detailed Design –Main Bridge Pile Cap of Pylon Drawing Package
Comments Issued by & date	: Commented by Guoxiong Yu on 19 th May 2015, 2 nd comment on 2 nd June 2015, 3 rd comment on 16 nd June 2015, 4 th comment on 19 nd June 2015
Answer Issued by & date	:
Consent Classification	: A (A: No adverse comments / B: Agree in Principle with minor comments / C: Insufficient Information to proceed with review / W: Major Non-conformity found, revision required)

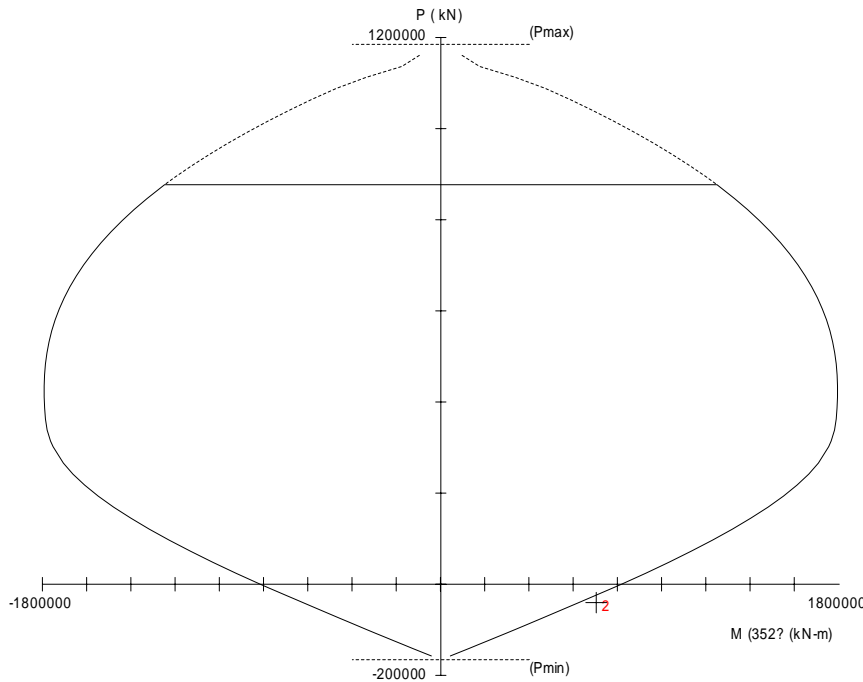No.	Rev.	Reference	Comment rev.	Comment or Non-Conformance	Response	Cat. ¹
				<div>- Section A-A (case-2 : Extreme Event- Transverse Earthquake) : N.G</div> <div></div>		2

ICE Check Report – List of Comments or Non-conformances

Document No : RA140-22-BRG-CW-DW-32250-A4-ICE41C

Ref. Transmittal No	: TRS-1510
Ref. Report No & DWG package No	: RA140-22-BRG-CW-DW-32250-A4
Document title	: Detailed Design –Main Bridge Pile Cap of Pylon Drawing Package
Comments Issued by & date	: Commented by Guoxiong Yu on 19 th May 2015, 2 nd comment on 2 nd June 2015, 3 rd comment on 16 th June 2015, 4 th comment on 19 th June 2015
Answer Issued by & date	:
Consent Classification	: A (A: No adverse comments / B: Agree in Principle with minor comments / C: Insufficient Information to proceed with review / W: Major Non-conformity found, revision required)

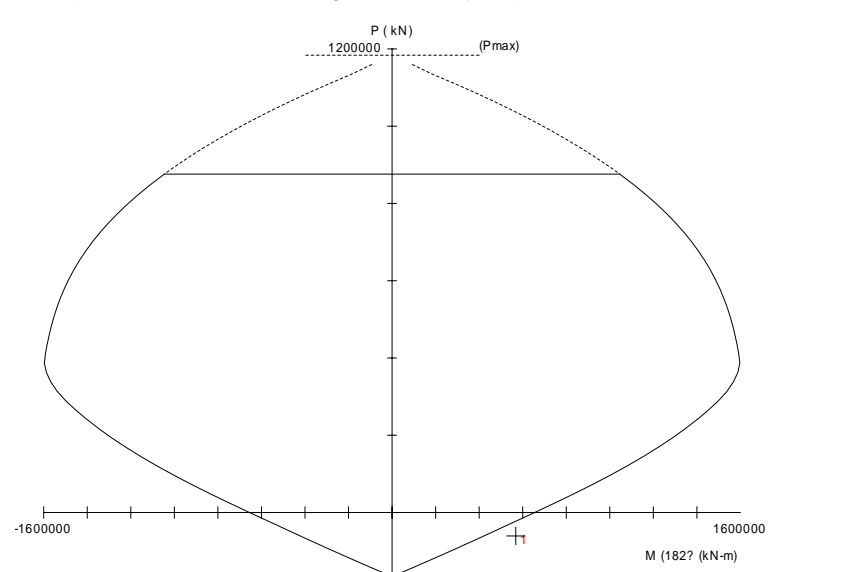No.	Rev.	Reference	Comment rev.	Comment or Non-Conformance	Response	Cat. ¹
				<p>- Section B-B (case-1 : Extreme Event- Longitudinal Earthquake) : N.G</p> 		2
	A2		2 nd	No further comment.	Noted.	A

¹)Category : Cat A = Agreed with response, Cat 0 = Observation / Note Cat 1 = Minor Comment Cat 2 = Major Comment / To be resolved

²)Comment Rev. : 1st comment, 2nd comment ...

Verified by: 

ICE Check Report – List of Comments or Non-conformances


Document No : RA140-22-BRG-CW-DW-32250-A4-ICE4IC

Ref. Transmittal No	: TRS-1510
Ref. Report No & DWG package No	: RA140-22-BRG-CW-DW-32250-A4
Document title	: Detailed Design –Main Bridge Pile Cap of Pylon Drawing Package
Comments Issued by & date	: Commented by Guoxiong Yu on 19 th May 2015, 2 nd comment on 2 nd June 2015, 3 rd comment on 16 nd June 2015, 4 th comment on 19 nd June 2015
Answer Issued by & date	:
Consent Classification	: A (A: No adverse comments / B: Agree in Principle with minor comments / C: Insufficient Information to proceed with review / W: Major Non-conformity found, revision required)

No.	Rev.	Reference	Comment rev.	Comment or Non-Conformance	Response	Cat. ¹
3	A1	DW - 32268 DW - 32276 DW - 32283	1 st	Please provide reinforcement spacing details between layers with cover.	The reinforcement spacing details between layers were provided in DW32269, DW32276, and DW32283, respectively.	2
	A2		2 nd	No further comment.	Noted.	A

¹)Category : Cat A = Agreed with response, Cat 0 = Observation / Note Cat 1 = Minor Comment Cat 2 = Major Comment / To be resolved


²)Comment Rev. : 1st comment, 2nd comment ...

Verified by: 

ICE Check Report – List of Comments or Non-conformances

Document No : RA140-22-BRG-CW-DW-32250-A4-ICE41C

Ref. Transmittal No	: TRS-1510
Ref. Report No & DWG package No	: RA140-22-BRG-CW-DW-32250-A4
Document title	: Detailed Design –Main Bridge Pile Cap of Pylon Drawing Package
Comments Issued by & date	: Commented by Guoxiong Yu on 19 th May 2015, 2 nd comment on 2 nd June 2015, 3 rd comment on 16 nd June 2015, 4 th comment on 19 nd June 2015
Answer Issued by & date	:
Consent Classification	: A (A: No adverse comments / B: Agree in Principle with minor comments / C: Insufficient Information to proceed with review / W: Major Non-conformity found, revision required)

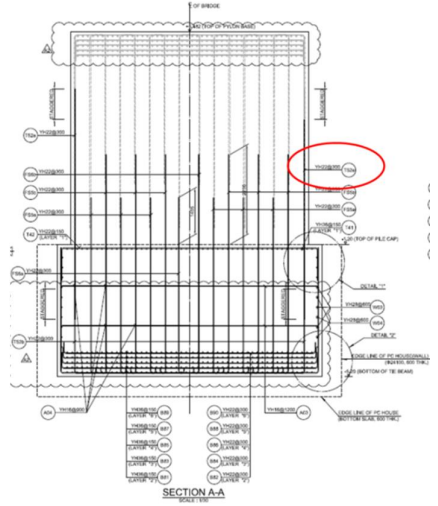No.	Rev.	Reference	Comment rev.	Comment or Non-Conformance	Response	Cat. ¹
4	A1	DW-32283	1 st	The transverse torsion reinforcement shall use closed stirrups to the tie beam according to AASHTO 5.11.2.6.4.	<p>The closed stirrups were arranged as the following figure. Please refer to the rebar no. T52a in drawing, RA140-22-BRG-CW-DW-32283-A2.</p> 	2
	A2		2 nd	The transverse torsion reinforcement shall be anchored by 135° standard hook around longitudinal reinforcement according to AASHTO 5.11.2.6.4. Please review.	Noted. The transverse torsion reinforcement was revised to have a 135° standard hook.	2
	A3		3 rd	No further comment.	Noted.	A

¹)Category : Cat A = Agreed with response, Cat 0 = Observation / Note Cat 1 = Minor Comment Cat 2 = Major Comment / To be resolved

²)Comment Rev. : 1st comment, 2nd comment ...

Verified by: 

ICE Check Report – List of Comments or Non-conformances

Document No : RA140-22-BRG-CW-DW-32250-A4-ICE41C

Ref. Transmittal No	: TRS-1510
Ref. Report No & DWG package No	: RA140-22-BRG-CW-DW-32250-A4
Document title	: Detailed Design –Main Bridge Pile Cap of Pylon Drawing Package
Comments Issued by & date	: Commented by Guoxiong Yu on 19 th May 2015, 2 nd comment on 2 nd June 2015, 3 rd comment on 16 th June 2015, 4 th comment on 19 th June 2015
Answer Issued by & date	:
Consent Classification	: A (A: No adverse comments / B: Agree in Principle with minor comments / C: Insufficient Information to proceed with review / W: Major Non-conformity found, revision required)

No.	Rev.	Reference	Comment rev.	Comment or Non-Conformance	Response	Cat. ¹
5	A2	Tie-beam Torsion capacity	2 nd	<p>From the torsion capacity checking, it is found that at the tie-beam under the Extreme limit state, transverse torsion reinforcement of Y22@300mm at the outside of tie-beam cannot satisfy the torsion capacity according to AASHTO 5.8.3.61.</p> <p>spacing 300 mm</p> $A_t = \frac{213,527,010,000}{2 \times A_0 \times f_y} \times s = \frac{213,527,010,000}{2 \times 58,437,084} \times \frac{300}{550} = 996.5 \text{ mm}^2$ <p>$A_v = \text{YH } 22 \times 1 \text{ ea} = 3.871 \text{ cm}^2 = 387.1 \text{ mm}^2$ N.G</p>	Noted. The transverse torsional reinforcement was changed to YH 32@150.	2
	A3		3 rd	No further comment.	Noted.	A
6	A2	Rear base of pylon Structural bending and axial capacity	2 nd	In the rear base of pylon (P3-M'), the structural biaxial bending and axial capacity of the section I-I cannot satisfy requirement under Extreme event state (shown by the figure below). Please review.	Noted. The diameter of the longitudinal reinforcement was changed from YH36-3 layers to YH 40-3 layers.	2

¹)Category : Cat A = Agreed with response, Cat 0 = Observation / Note Cat 1 = Minor Comment Cat 2 = Major Comment / To be resolved

²)Comment Rev. : 1st comment, 2nd comment ...

Verified by: 

ICE Check Report – List of Comments or Non-conformances

Document No : RA140-22-BRG-CW-DW-32250-A4-ICE4IC

Ref. Transmittal No	: TRS-1510
Ref. Report No & DWG package No	: RA140-22-BRG-CW-DW-32250-A4
Document title	: Detailed Design –Main Bridge Pile Cap of Pylon Drawing Package
Comments Issued by & date	: Commented by Guoxiong Yu on 19 th May 2015, 2 nd comment on 2 nd June 2015, 3 rd comment on 16 nd June 2015, 4 th comment on 19 nd June 2015
Answer Issued by & date	:
Consent Classification	: A (A: No adverse comments / B: Agree in Principle with minor comments / C: Insufficient Information to proceed with review / W: Major Non-conformity found, revision required)

No.	Rev.	Reference	Comment rev.	Comment or Non-Conformance	Response	Cat. ¹
6				<p>- Section I-I (Case - 1 : Extreme Event- Longitudinal Earthquake) : N.G</p>		2
	A3		3 rd	No further comment.	Noted.	A

¹Category : Cat A = Agreed with response, Cat 0 = Observation / Note Cat 1 = Minor Comment Cat 2 = Major Comment / To be resolved


²Comment Rev. : 1st comment, 2nd comment ...

Verified by:

ICE Check Report – List of Comments or Non-conformances

Document No : RA140-22-BRG-CW-DW-32250-A4-ICE41C

Ref. Transmittal No	: TRS-1510
Ref. Report No & DWG package No	: RA140-22-BRG-CW-DW-32250-A4
Document title	: Detailed Design –Main Bridge Pile Cap of Pylon Drawing Package
Comments Issued by & date	: Commented by Guoxiong Yu on 19 th May 2015, 2 nd comment on 2 nd June 2015, 3 rd comment on 16 nd June 2015, 4 th comment on 19 nd June 2015
Answer Issued by & date	:
Consent Classification	: A (A: No adverse comments / B: Agree in Principle with minor comments / C: Insufficient Information to proceed with review / W: Major Non-conformity found, revision required)

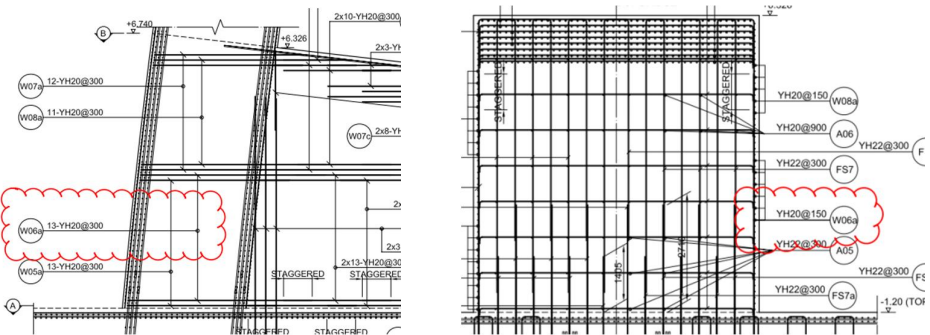No.	Rev.	Reference	Comment rev.	Comment or Non-Conformance	Response	Cat. ¹
7	A2	Rear base of pylon Vertical Bearing capacity	2 nd	Jacking force of pre-stressing bars in the rear base of pylon has not been given in the drawings, please provide.	The jacking force of pre-stressing bars is 0.7Fpu.	2
	A3		3 rd	Please specify this jacking force of pre-stressing bars in drawings.	The jacking force of prestressing bar with dia. 85 mm and dia. 41 mm are 4696 kN and 1096 kN, respectively.	2
	A4		4 th	No further comment.		A
8	A2	DW-32285 & DW-32292	2 nd	<p>The spacing of W06a reinforcements are different between DW-32285 and DW-32292. Please clarify.</p> 	It is a typo. The spacing of W06a reinforcement is revised to 300mm.	2
	A3		3 rd	No further comment.	Noted.	A

¹)Category : Cat A = Agreed with response, Cat 0 = Observation / Note Cat 1 = Minor Comment Cat 2 = Major Comment / To be resolved


²)Comment Rev. : 1st comment, 2nd comment ...

Verified by: 

ICE Check Report – List of Comments or Non-conformances

Document No : RA140-22-BRG-CW-DW-32250-A4-ICE4IC

Ref. Transmittal No	: TRS-1510
Ref. Report No & DWG package No	: RA140-22-BRG-CW-DW-32250-A4
Document title	: Detailed Design –Main Bridge Pile Cap of Pylon Drawing Package
Comments Issued by & date	: Commented by Guoxiong Yu on 19 th May 2015, 2 nd comment on 2 nd June 2015, 3 rd comment on 16 nd June 2015, 4 th comment on 19 th June 2015
Answer Issued by & date	:
Consent Classification	: A (A: No adverse comments / B: Agree in Principle with minor comments / C: Insufficient Information to proceed with review / W: Major Non-conformity found, revision required)

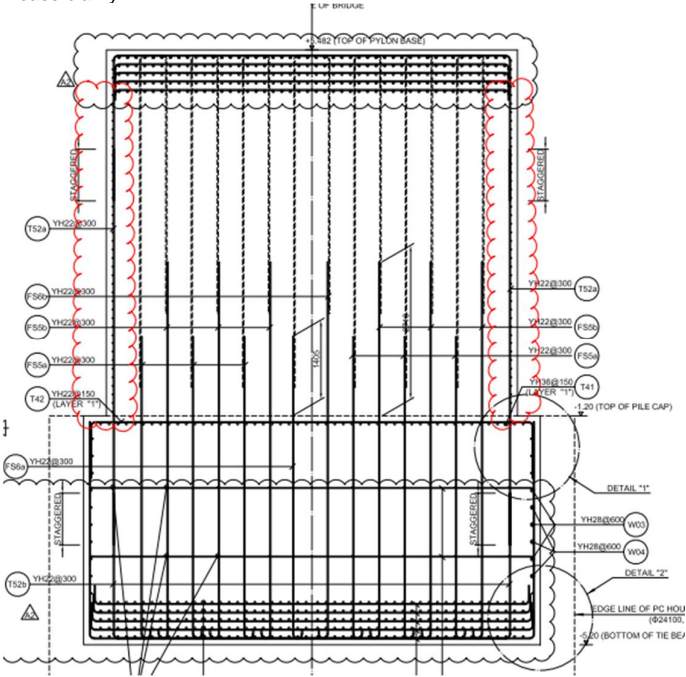No.	Rev.	Reference	Comment rev.	Comment or Non-Conformance	Response	Cat. ¹
9	A2	DW-32283	2 nd	<p>Torsion reinforcement (T52a, shown in the figure below) shall be arranged inside the longitudinal reinforcements, Please clarify.</p> 	<p>Noted.</p> <p>The inside reinforcement at the bottom tension reinforcement was included for the calculation of torsion reinforcement.</p> <p>And the bottom tension reinforcement was changed from 5-layer to 6-layer.</p>	2
	A3		3 rd	No further comment.	Noted.	A

¹)Category : Cat A = Agreed with response, Cat 0 = Observation / Note Cat 1 = Minor Comment Cat 2 = Major Comment / To be resolved


²)Comment Rev. : 1st comment, 2nd comment ...

Verified by: 

ICE Check Report – List of Comments or Non-conformances

Document No : RA140-22-BRG-CW-DW-32250-A4-ICE41C

Ref.Transmittal No	: TRS-1510
Ref. Report No & DWG package No	: RA140-22-BRG-CW-DW-32250-A4
Document title	: Detailed Design –Main Bridge Pile Cap of Pylon Drawing Package
Comments Issued by & date	: Commented by Guoxiong Yu on 19 th May 2015, 2 nd comment on 2 nd June 2015, 3 rd comment on 16 nd June 2015, 4 th comment on 19 nd June 2015
Answer Issued by & date	:
Consent Classification	: A (A: No adverse comments / B: Agree in Principle with minor comments / C: Insufficient Information to proceed with review / W: Major Non-conformity found, revision required)

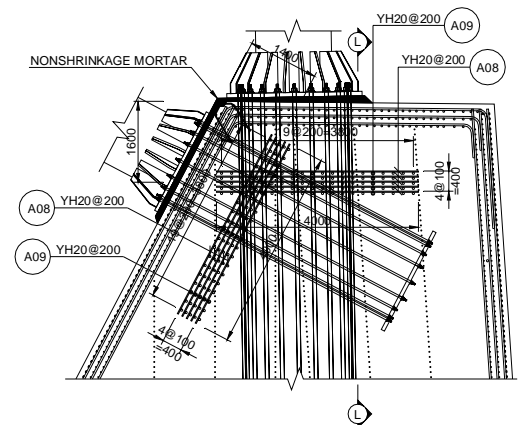No.	Rev.	Reference	Comment rev.	Comment or Non-Conformance	Response	Cat. ¹
10	A2	Rear base of pylon	2 nd	The reinforcements such as bursting reinforcement in the anchorage zone of the prestressing bars shall be provided.	<p>Noted. The bursting reinforcements were added. Please find the drawing, RA140-22-BRG-CW-DW-32295.</p> 	2


¹Category : Cat A = Agreed with response, Cat 0 = Observation / Note Cat 1 = Minor Comment Cat 2 = Major Comment / To be resolved
²Comment Rev. : 1st comment, 2nd comment ...

Verified by: 

ICE Check Report – List of Comments or Non-conformances

Document No : RA140-22-BRG-CW-DW-32250-A4-ICE41C

Ref. Transmittal No	: TRS-1510
Ref. Report No & DWG package No	: RA140-22-BRG-CW-DW-32250-A4
Document title	: Detailed Design –Main Bridge Pile Cap of Pylon Drawing Package
Comments Issued by & date	: Commented by Guoxiong Yu on 19 th May 2015, 2 nd comment on 2 nd June 2015, 3 rd comment on 16 nd June 2015, 4 th comment on 19 nd June 2015
Answer Issued by & date	:
Consent Classification	: A (A: No adverse comments / B: Agree in Principle with minor comments / C: Insufficient Information to proceed with review / W: Major Non-conformity found, revision required)

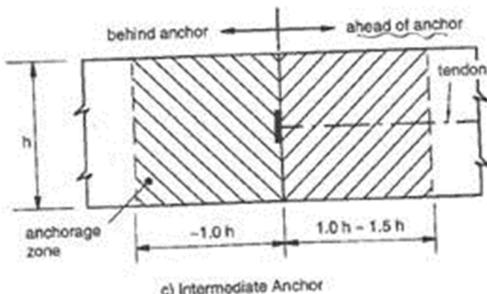No.	Rev.	Reference	Comment rev.	Comment or Non-Conformance	Response	Cat. ¹
	A3		3 rd	<p>The tie-back reinforcement in intermediate anchorages shall be applied according to AASHTO 5.10.9.4.4b.</p>  <p>Fig. VIII-14 Examples of General Zone Dimensions</p>	<p>Noted. The reinforcement number, A21~A28 added around the intermediate anchorages in DW-32295.</p>	2
	A4		4 th	The tie-back reinforcements have been added in DW-32295. No further comment.		A
11	A3	DW-32298	3 rd	This drawing is concrete pylon leg portion, which is not relevant to pile cap, please remove it from pile cap drawing package.	<p>Noted. The drawing, DW-32298 was shifted into the pylon concrete leg drawing package, RA140-22-BRG-CW-DW-32500.</p>	2
	A4		4 th	No further comment.		A

¹)Category : Cat A = Agreed with response, Cat 0 = Observation / Note Cat 1 = Minor Comment Cat 2 = Major Comment / To be resolved

²)Comment Rev. : 1st comment, 2nd comment ...

Verified by: 

Sheikh Jaber Al-Ahmad Al-Sabah Causeway Project
Main Link – Contract RA/140


DETAILED DESIGN –MAIN BRIDGE
PILE CAP OF PYLON DRAWING PACKAGE

Drawing package No.: RA140-22-BRG-CW-DW-32250-B4


Code	Revision	Date	Title 1	Title 2	Title 3	Comment
RA140-22-BRG-CW-DW-32251	A3	17/06/2015	MAIN BRIDGE	PILE CAP OF PYLON	GENERAL LAYOUT 1/4	
RA140-22-BRG-CW-DW-32252	A3	17/06/2015	MAIN BRIDGE	PILE CAP OF PYLON	GENERAL LAYOUT 2/4	
RA140-22-BRG-CW-DW-32253	A3	17/06/2015	MAIN BRIDGE	PILE CAP OF PYLON	GENERAL LAYOUT 3/4	
RA140-22-BRG-CW-DW-32254	A3	17/06/2015	MAIN BRIDGE	PILE CAP OF PYLON	GENERAL LAYOUT 4/4	
RA140-22-BRG-CW-DW-32255	B2	10/09/2015	MAIN BRIDGE	PILE CAP OF PYLON (P3-M, P3'-M)	STAINLESS STEEL ARRANGEMENT 1/4	
RA140-22-BRG-CW-DW-32256	B2	10/09/2015	MAIN BRIDGE	PILE CAP OF PYLON (P3-M, P3'-M)	STAINLESS STEEL ARRANGEMENT 2/4	
RA140-22-BRG-CW-DW-32257	B1	12/08/2015	MAIN BRIDGE	PILE CAP OF PYLON (P3-M, P3'-M)	STAINLESS STEEL ARRANGEMENT 3/4	
RA140-22-BRG-CW-DW-32258	B1	12/08/2015	MAIN BRIDGE	PILE CAP OF PYLON (P3-M, P3'-M)	STAINLESS STEEL ARRANGEMENT 4/4	
RA140-22-BRG-CW-BS-32259	B1	12/08/2015	MAIN BRIDGE	PILE CAP OF PYLON (P3-M, P3'-M)	STAINLESS STEEL BAR LIST	
RA140-22-BRG-CW-DW-32261	B1	10/09/2015	MAIN BRIDGE	PILE CAP OF PYLON (P3-M)	REINFORCEMENT ARRANGEMENT 1/9	
RA140-22-BRG-CW-DW-32262	B1	10/09/2015	MAIN BRIDGE	PILE CAP OF PYLON (P3-M)	REINFORCEMENT ARRANGEMENT 2/9	
RA140-22-BRG-CW-DW-32263	B1	10/09/2015	MAIN BRIDGE	PILE CAP OF PYLON (P3-M)	REINFORCEMENT ARRANGEMENT 3/9	
RA140-22-BRG-CW-DW-32264	B1	10/09/2015	MAIN BRIDGE	PILE CAP OF PYLON (P3-M)	REINFORCEMENT ARRANGEMENT 4/9	
RA140-22-BRG-CW-DW-32265	B1	10/09/2015	MAIN BRIDGE	PILE CAP OF PYLON (P3-M)	REINFORCEMENT ARRANGEMENT 5/9	
RA140-22-BRG-CW-DW-32266	B2	10/09/2015	MAIN BRIDGE	PILE CAP OF PYLON (P3-M)	REINFORCEMENT ARRANGEMENT 6/9	
RA140-22-BRG-CW-DW-32267	B2	10/09/2015	MAIN BRIDGE	PILE CAP OF PYLON (P3-M)	REINFORCEMENT ARRANGEMENT 7/9	
RA140-22-BRG-CW-DW-32268	B2	10/09/2015	MAIN BRIDGE	PILE CAP OF PYLON (P3-M)	REINFORCEMENT ARRANGEMENT 8/9	
RA140-22-BRG-CW-DW-32269	B1	10/09/2015	MAIN BRIDGE	PILE CAP OF PYLON (P3-M)	REINFORCEMENT ARRANGEMENT 9/9	
RA140-22-BRG-CW-BS-32270	B2	10/09/2015	MAIN BRIDGE	PILE CAP OF PYLON (P3-M)	BAR LIST	
RA140-22-BRG-CW-DW-32271	B2	10/09/2015	MAIN BRIDGE	PILE CAP OF PYLON (P3'-M)	REINFORCEMENT ARRANGEMENT 1/7	
RA140-22-BRG-CW-DW-32272	B2	10/09/2015	MAIN BRIDGE	PILE CAP OF PYLON (P3'-M)	REINFORCEMENT ARRANGEMENT 2/7	

Sheikh Jaber Al-Ahmad Al-Sabah Causeway Project
Main Link – Contract RA/140

RA140-22-BRG-CW-DW-32273	B2	10/09/2015	MAIN BRIDGE	PILE CAP OF PYLON (P3'-M)	REINFORCEMENT ARRANGEMENT 3/7	
RA140-22-BRG-CW-DW-32274	B2	10/09/2015	MAIN BRIDGE	PILE CAP OF PYLON (P3'-M)	REINFORCEMENT ARRANGEMENT 4/7	
RA140-22-BRG-CW-DW-32279	B1	10/09/2015	MAIN BRIDGE	PILE CAP OF PYLON (P3'-M)	REINFORCEMENT ARRANGEMENT 5/7	
RA140-22-BRG-CW-DW-32275	B2	10/09/2015	MAIN BRIDGE	PILE CAP OF PYLON (P3'-M)	REINFORCEMENT ARRANGEMENT 6/7	
RA140-22-BRG-CW-DW-32276	B2	10/09/2015	MAIN BRIDGE	PILE CAP OF PYLON (P3'-M)	REINFORCEMENT ARRANGEMENT 7/7	
RA140-22-BRG-CW-BS-32277	B2	10/09/2015	MAIN BRIDGE	PILE CAP OF PYLON (P3'-M)	BAR LIST	
RA140-22-BRG-CW-DW-32278	B1	12/08/2015	MAIN BRIDGE	PILE CAP OF PYLON	SCHEME FOR AVOIDING REBAR CONFLIC	
RA140-22-BRG-CW-DW-32281	B2	10/09/2015	MAIN BRIDGE	PILE CAP OF PYLON (TIE BEAM)	REINFORCEMENT ARRANGEMENT 1/3	
RA140-22-BRG-CW-DW-32282	B2	10/09/2015	MAIN BRIDGE	PILE CAP OF PYLON (TIE BEAM)	REINFORCEMENT ARRANGEMENT 2/3	
RA140-22-BRG-CW-DW-32283	A5	20/07/2015	MAIN BRIDGE	PILE CAP OF PYLON (TIE BEAM)	REINFORCEMENT ARRANGEMENT 3/3	
RA140-22-BRG-CW-BS-32284	B2	10/09/2015	MAIN BRIDGE	PILE CAP OF PYLON (TIE BEAM)	BAR LIST	
RA140-22-BRG-CW-DW-32285	B2	10/09/2015	MAIN BRIDGE	PILE CAP OF PYLON (PYLON BASE)	REINFORCEMENT ARRANGEMENT 1/11	
RA140-22-BRG-CW-DW-32286	B2	10/09/2015	MAIN BRIDGE	PILE CAP OF PYLON (PYLON BASE)	REINFORCEMENT ARRANGEMENT 2/11	
RA140-22-BRG-CW-DW-32287	B1	12/08/2015	MAIN BRIDGE	PILE CAP OF PYLON (PYLON BASE)	REINFORCEMENT ARRANGEMENT 3/11	
RA140-22-BRG-CW-DW-32288	B1	12/08/2015	MAIN BRIDGE	PILE CAP OF PYLON (PYLON BASE)	REINFORCEMENT ARRANGEMENT 4/11	
RA140-22-BRG-CW-DW-32289	B1	12/08/2015	MAIN BRIDGE	PILE CAP OF PYLON (PYLON BASE)	REINFORCEMENT ARRANGEMENT 5/11	
RA140-22-BRG-CW-DW-32299	B4	12/02/2016	MAIN BRIDGE	PILE CAP OF PYLON	ANCHORAGE DETAILS	

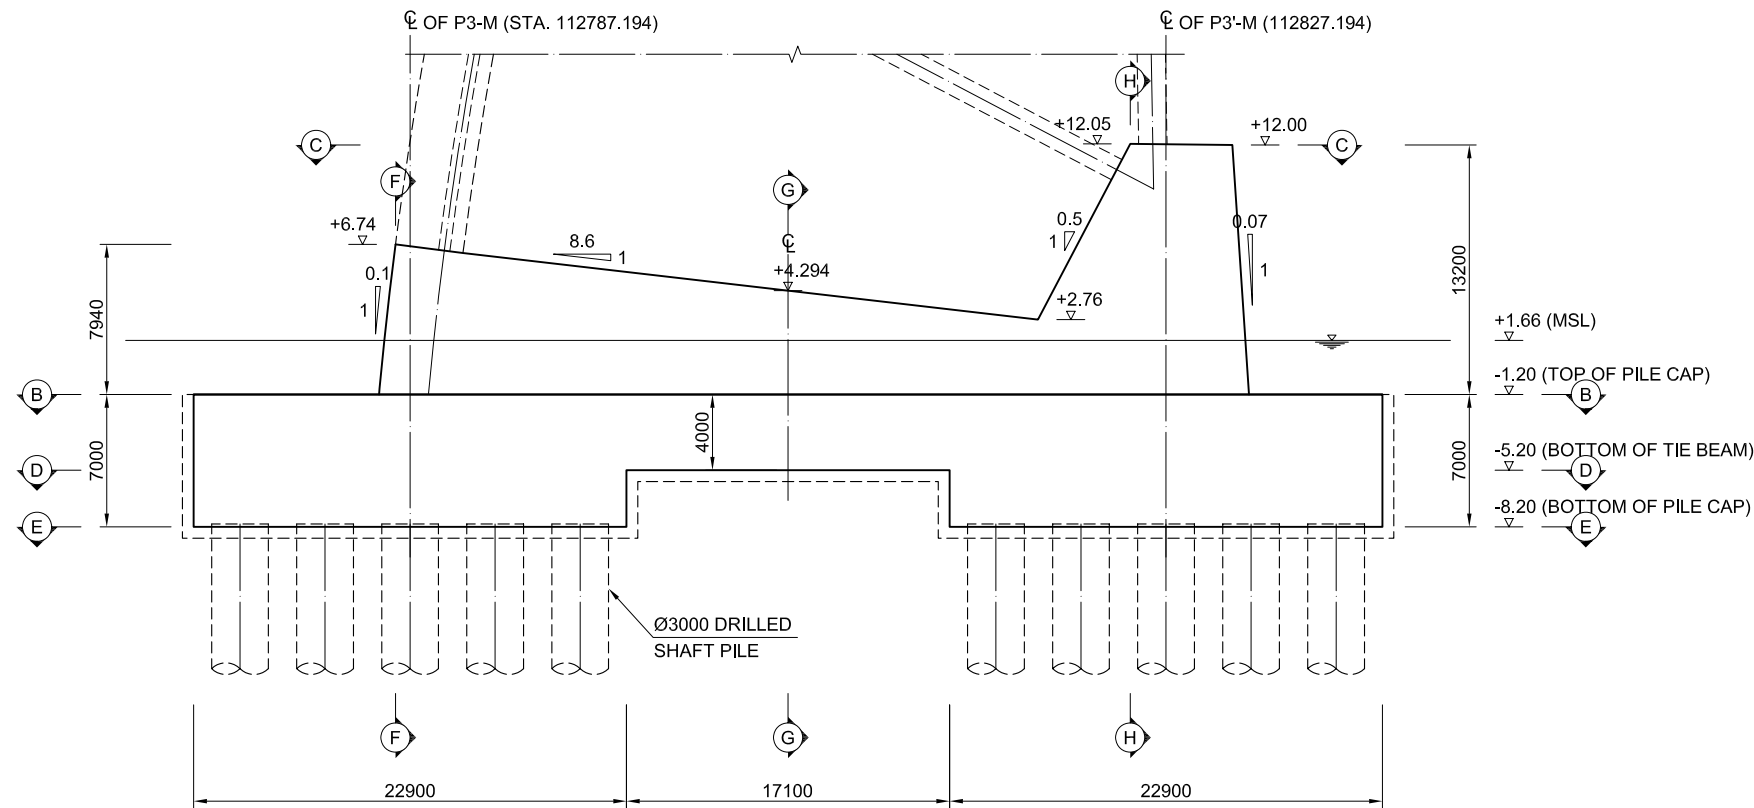

FRONT VIEW
SCALE : 1/200

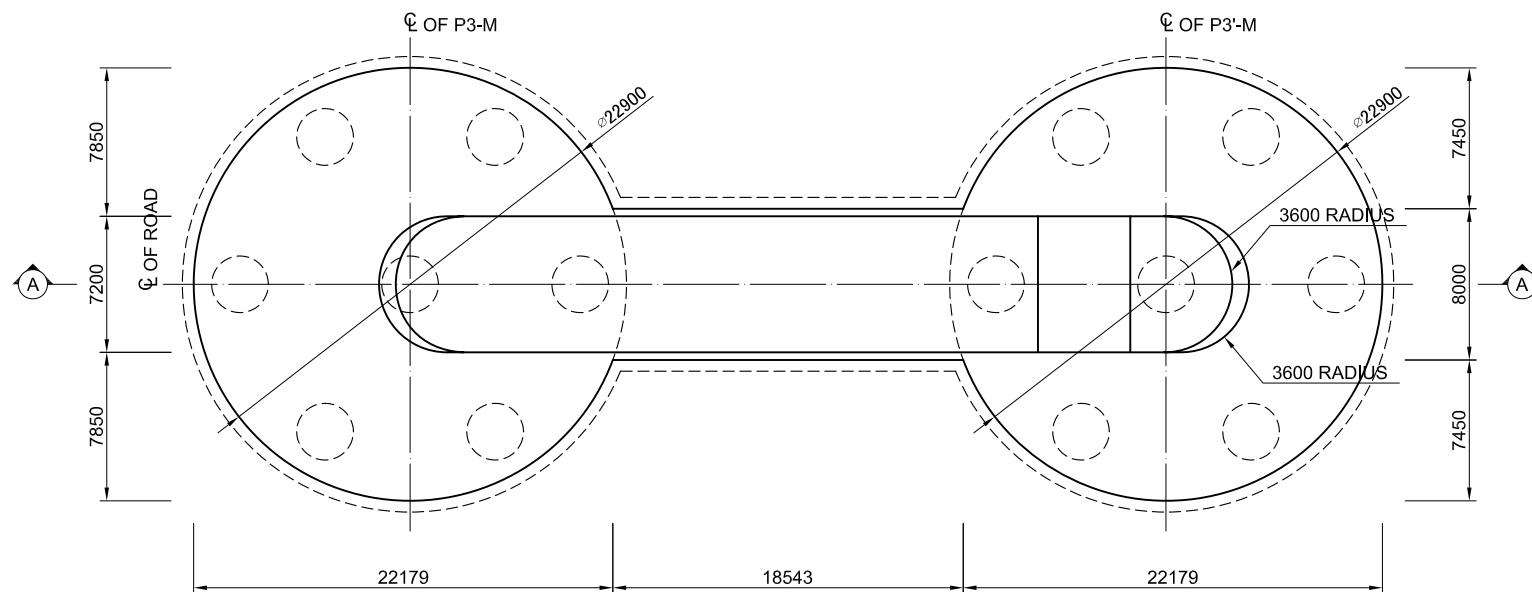


PLAN VIEW
SCALE : 1/200

NOTES:

1. ALL DIMENSIONS ARE IN MILLIMETERS AND ALL ELEVATIONS ARE IN METERS UNLESS OTHERWISE NOTED.
2. CONCRETE SHALL BE DESIGN MIX AND HAVE MINIMUM 28 DAYS CHARACTERISTIC STRENGTH(CYLINDER)
-PYLON PILE CAP : 40MPa
-PYLON BASE : 50MPa
3. REINFORCEMENT REBARS SHALL CONFORM TO ASTM A706 GRADE 80(550 MPa) FOR CARBON REBARS(YH).
4. THE STAINLESS STEEL REINFORCEMENT IS RIBBED BARS.
5. FOR SECTION A-A REFER TO DRAWING NO.RA140-22-BRG-CW-DW-32252.
6. FOR SECTION B-B,C-C REFER TO DRAWING NO.RA140-22-BRG-CW-DW-32253.
7. FOR SECTION D-D,E-E,F-F,G-G,H-H REFER TO DRAWING NO.RA140-22-BRG-CW-DW-32254.

STAINLESS STEEL REINFORCEMENT SHALL AS A MINIMUM COMPLY WITH THE FOLLOWING.

FOR BAR DIAMETER 6~50MM
HOT ROLLED, STEEL GRADE 1.4362 MINIMUM
Rp 0.2=500MPa, ACCORDING TO BS6744
AND DELIVERED WITH A 'CARES' CERTIFICATE CUT AND BEND ACCORDING TO BS8666 WITH A 'CARES' CERTIFICATE (YS).

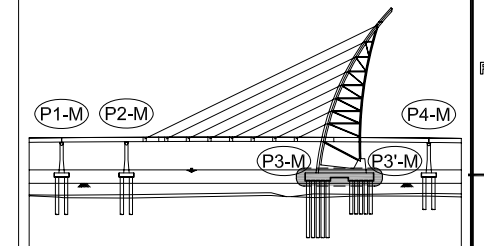

REV.	DATE	DESCRIPTION OF REVISION	DRAWN	CHEC.	APPRO.
A3	17/06/15	Updated As Shown In Clouds	SWK	HSB	DKK
A2	05/06/15	Updated As Shown In Clouds	SWK	HSB	DKK
A1	08/04/15	First Issue	SWK	HSB	DKK

EMPLOYER
STATE OF KUWAIT
MINISTRY OF PUBLIC WORKS
ROADS ADMINISTRATION

PROJECT TITLE
SHEIKH JABER AL AHMAD AL SABAH
CAUSEWAY PROJECT (MAIN LINK)
CONTRACT RA/140

DRAWING TITLE
MAIN BRIDGE
PILE CAP OF PYLON
GENERAL LAYOUT 1/4


SCALE	DRAWN	DESIGNED	CHECKED	APPROVED
AS SHOWN	SWK	DJB	HSB	DKK
DATE ISSUED	08/04/15	08/04/15	08/04/15	08/04/15

CONTRACTOR
HYUNDAI ENGINEERING & CONSTRUCTION
Combined Group Contracting Company

DESIGNER
SYSTRA


DRAWING NO.
RA140-22-BRG-CW-DW-32251

REV.
A3

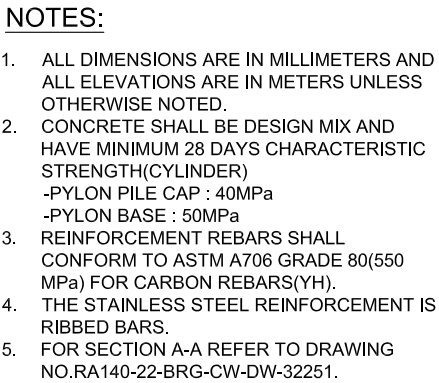

STAINLESS STEEL REINFORCEMENT SHALL AS A MINIMUM COMPLY WITH THE FOLLOWING.

FOR BAR DIAMETER 6-50MM
HOT ROLLED, STEEL GRADE 1.4362 MINIMUM
Rp 0.2=500MPa, ACCORDING TO BS6744
AND DELIVERED WITH A 'CARES' CERTIFICATE
CUT AND BEND ACCORDING TO BS8666 WITH A
'CARES' CERTIFICATE (YS).

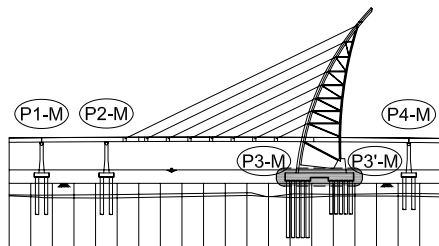

A3	17/06/15	Updated As Shown In Clouds	SWK	HSB	DKK
A2	05/06/15	Updated As Shown In Clouds	SWK	HSB	DKK
A1	08/04/15	Final Issue	SWK	HSB	DKK
REV.	DATE	DESCRIPTION OF REVISION	DRAWN	CHEC.	APPRO.

EMPLOYER

STATE OF KUWAIT
MINISTRY OF PUBLIC WORKS
ROADS ADMINISTRATION



وزارة الأشغال العامة
MINISTRY OF PUBLIC WORKS

PROJECT TITLE

SHEIKH JABER AL AHMAD AL SABAH
CAUSEWAY PROJECT (MAIN LINK)
CONTRACT RA/140

DRAWING TITLE	MAIN BRIDGE PILE CAP OF PYLON GENERAL LAYOUT 2/4
---------------	--

SCALE	DRAWN	DESIGNED	CHECKED	APPROVED
AS SHOWN	SWK	DJB	HSH	DKK
DATE ISSUED				
08/04/15	08/04/15	08/04/15	08/04/15	08/04/15

CONTRACTOR


 **HYUNDAI**
ENGINEERING & CONSTRUCTION

 **Combined Group**
Contracting Company

DESIGNER

SYSTRA

DRAWING NO.	REV.
RA140-22-BRG-CW-DW-32252	A3

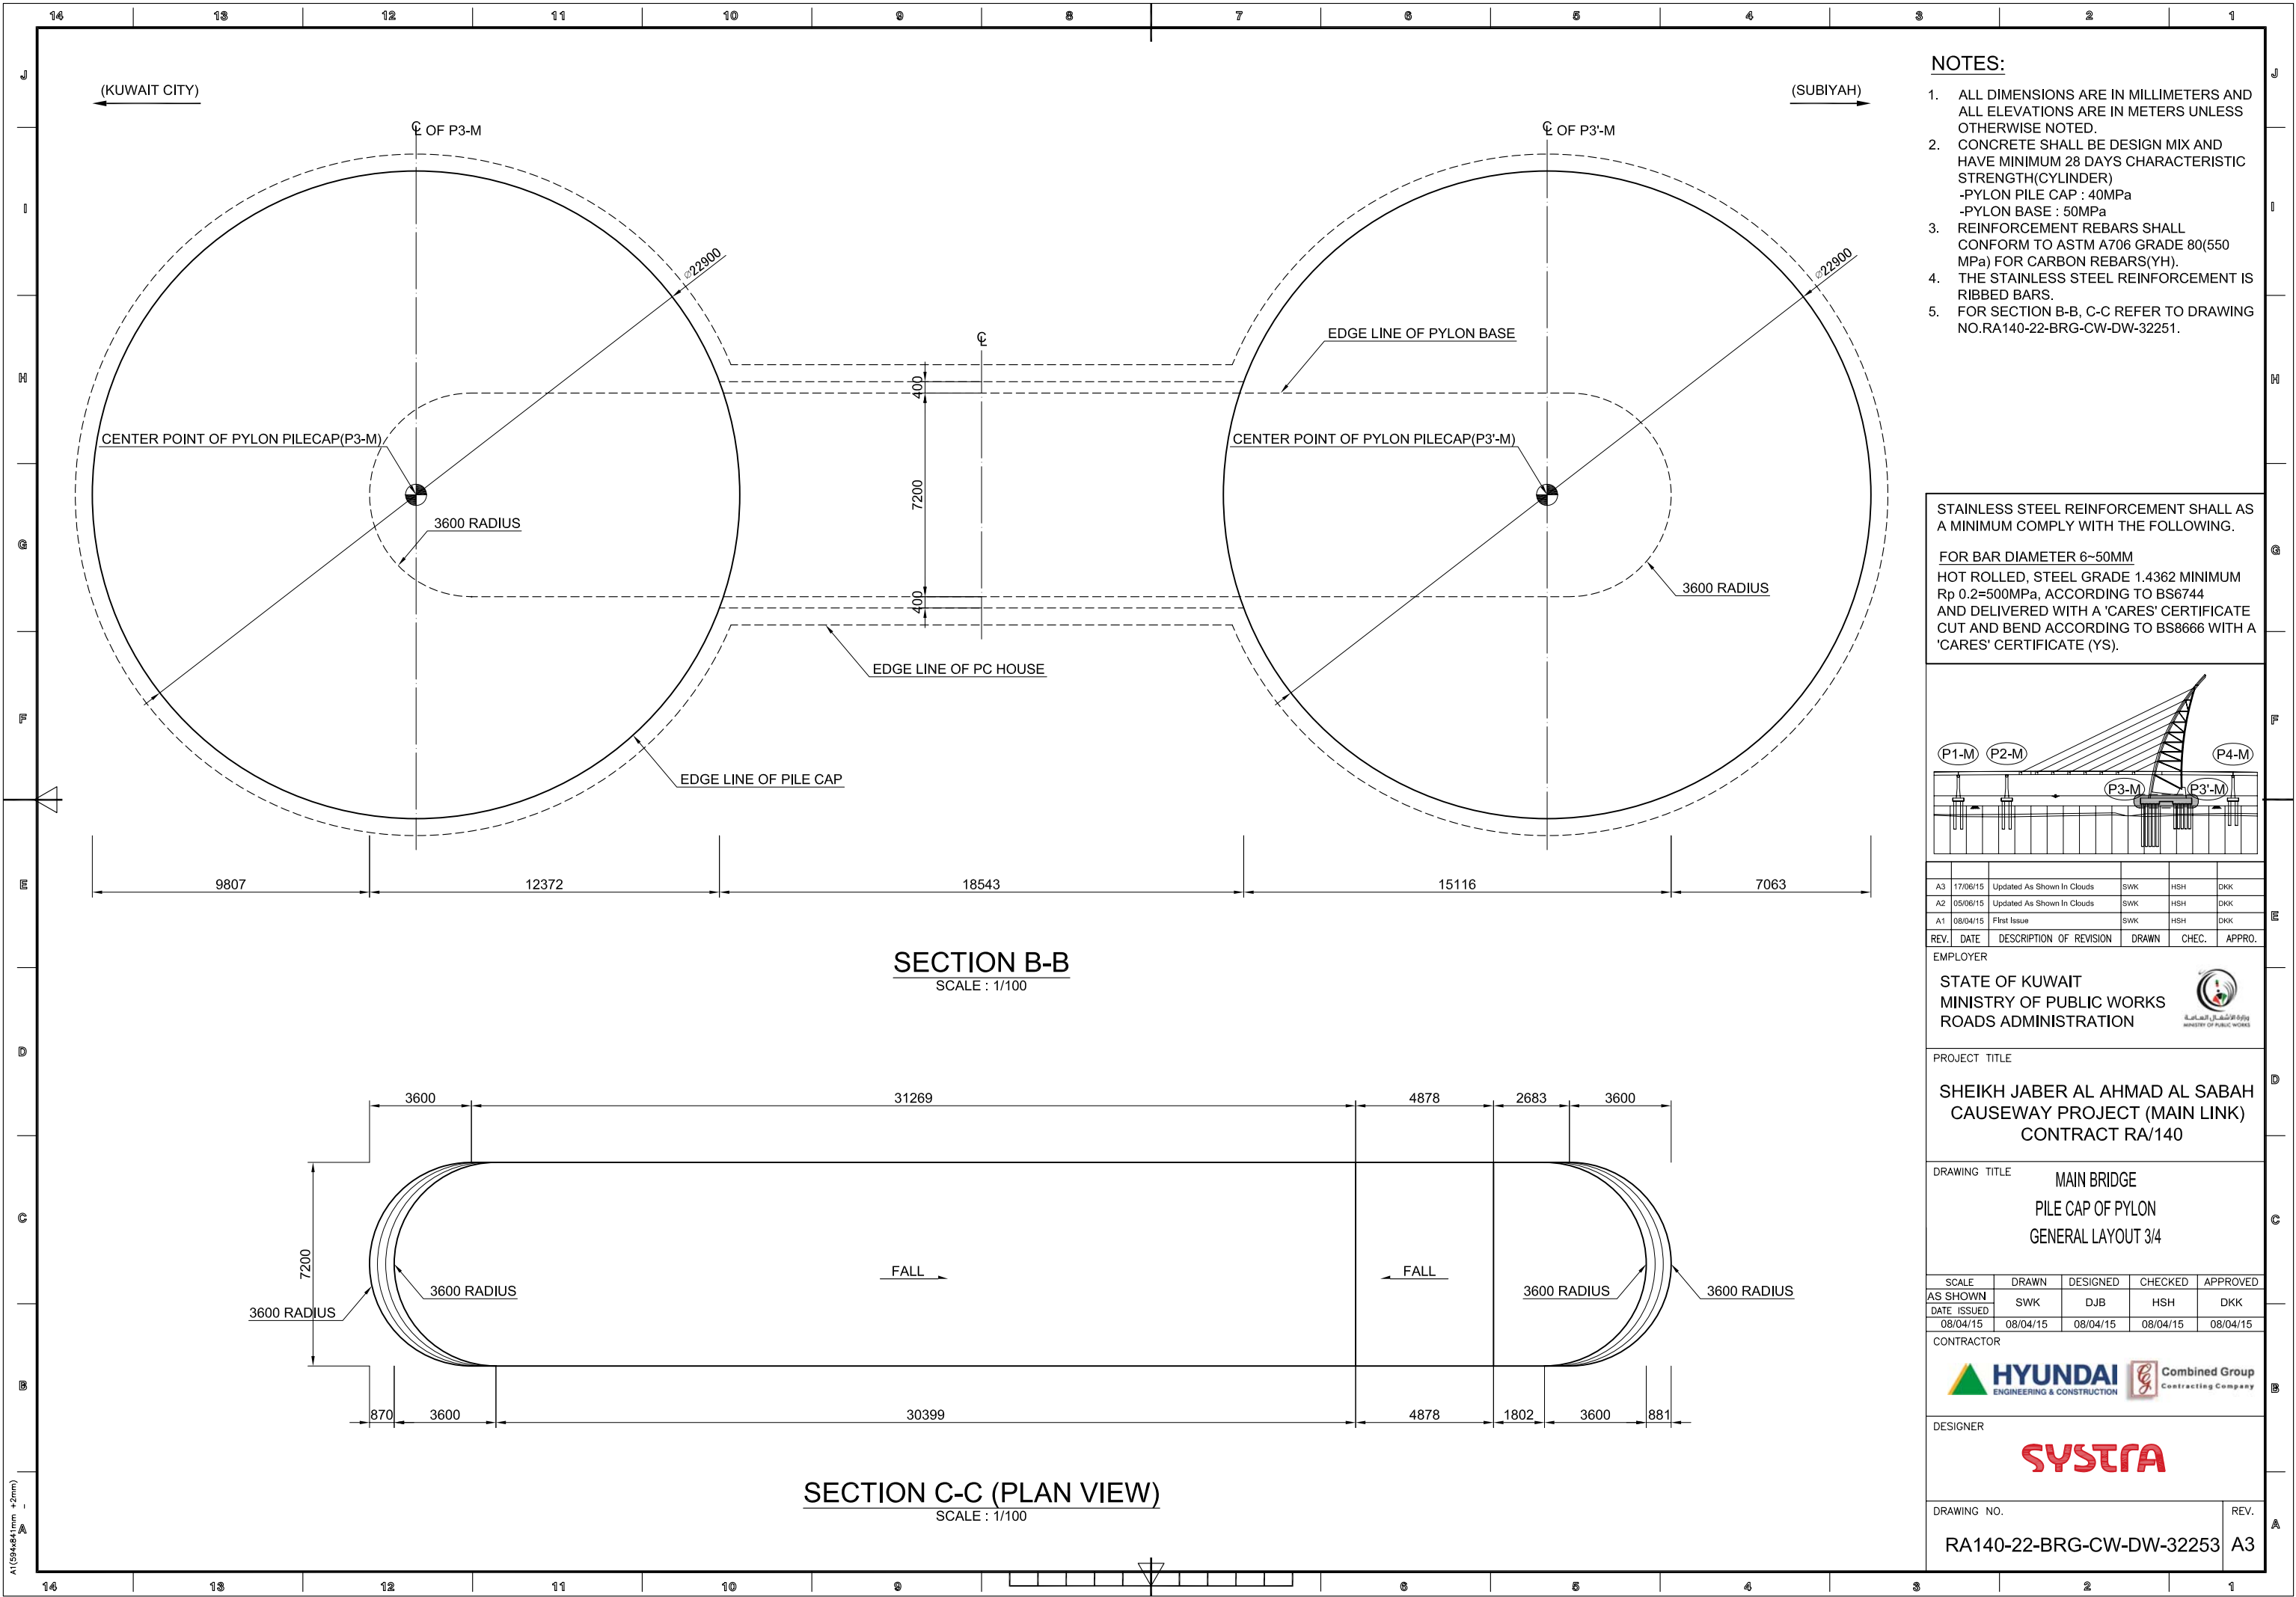


NOTES:

1. ALL DIMENSIONS ARE IN MILLIMETERS AND ALL ELEVATIONS ARE IN METERS UNLESS OTHERWISE NOTED.
2. CONCRETE SHALL BE DESIGN MIX AND HAVE MINIMUM 28 DAYS CHARACTERISTIC STRENGTH(CYLINDER)
-PYLON PILE CAP : 40MPa
-PYLON BASE : 50MPa
3. REINFORCEMENT REBARS SHALL CONFORM TO ASTM A706 GRADE 80(550 MPa) FOR CARBON REBARS(YH).
4. THE STAINLESS STEEL REINFORCEMENT IS RIBBED BARS.
5. FOR SECTION B-B, C-C REFER TO DRAWING NO.RA140-22-BRG-CW-DW-32251.

STAINLESS STEEL REINFORCEMENT SHALL AS A MINIMUM COMPLY WITH THE FOLLOWING.

FOR BAR DIAMETER 6-50MM
HOT ROLLED, STEEL GRADE 1.4362 MINIMUM Rp 0.2=500MPa, ACCORDING TO BS6744 AND DELIVERED WITH A 'CARES' CERTIFICATE CUT AND BEND ACCORDING TO BS8666 WITH A 'CARES' CERTIFICATE (YS).

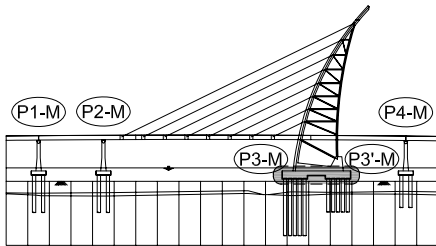

REV.	DATE	DESCRIPTION OF REVISION	DRAWN	CHEC.	APPRO.
A3	17/06/15	Updated As Shown In Clouds	SWK	HSB	DKK
A2	05/06/15	Updated As Shown In Clouds	SWK	HSB	DKK
A1	08/04/15	First Issue	SWK	HSB	DKK

EMPLOYER

STATE OF KUWAIT
MINISTRY OF PUBLIC WORKS
ROADS ADMINISTRATION



PROJECT TITLE

SHEIKH JABER AL AHMAD AL SABAH
CAUSEWAY PROJECT (MAIN LINK)
CONTRACT RA/140

DRAWING TITLE

MAIN BRIDGE
PILE CAP OF PYLON
GENERAL LAYOUT 3/4

SCALE	DRAWN	DESIGNED	CHECKED	APPROVED
AS SHOWN	SWK	DJB	HSB	DKK
DATE ISSUED	08/04/15	08/04/15	08/04/15	08/04/15

CONTRACTOR



DESIGNER


SYSTRA

DRAWING NO.


RA140-22-BRG-CW-DW-32253

REV.

A3

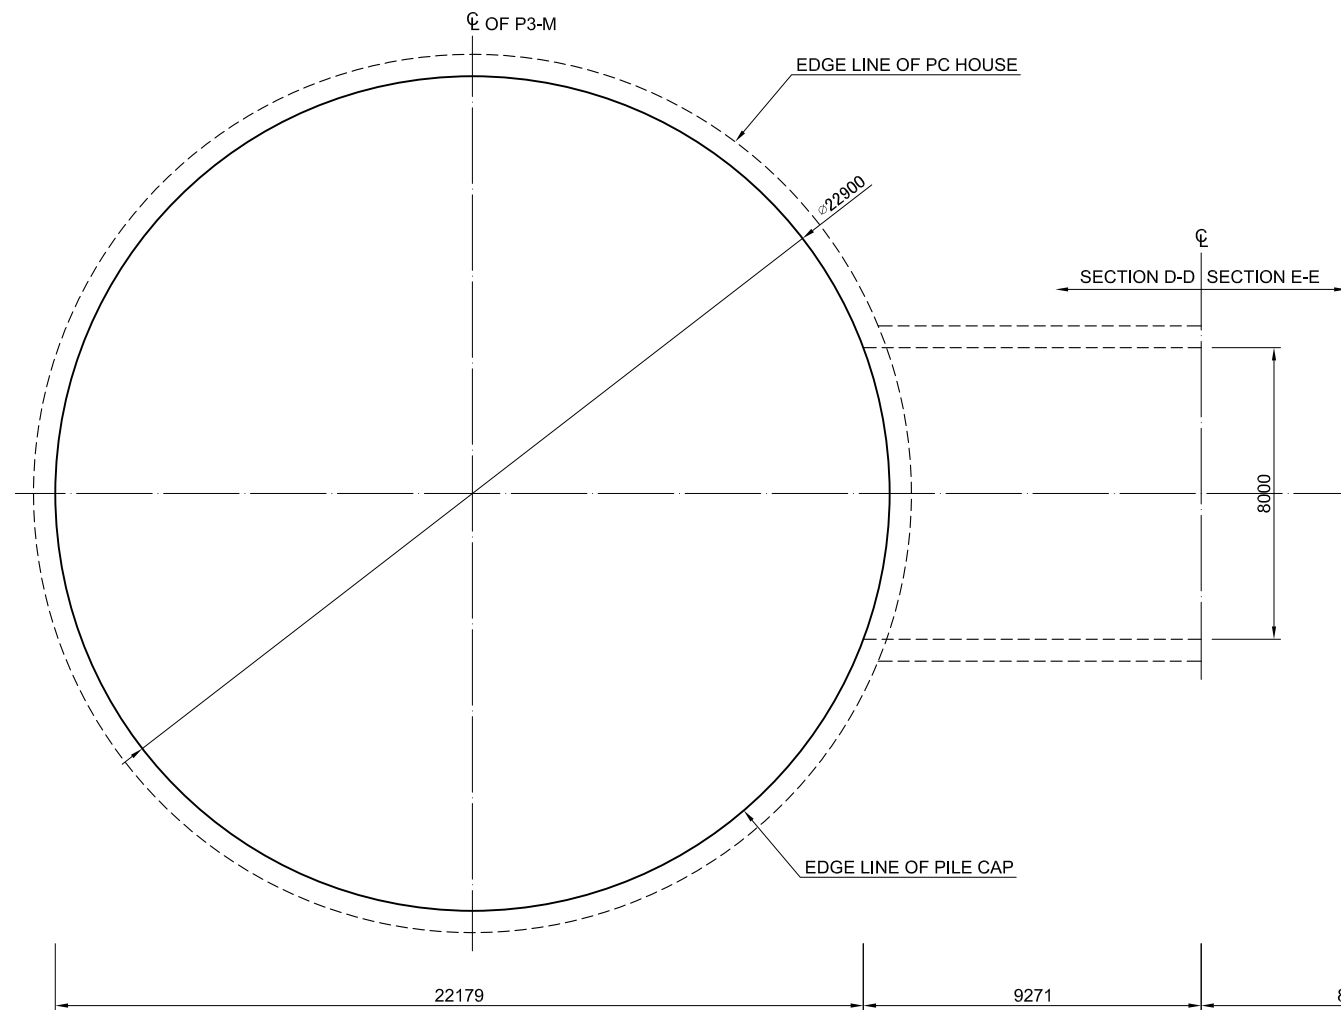


SECTION D-D, E-E
SCALE : 1/100

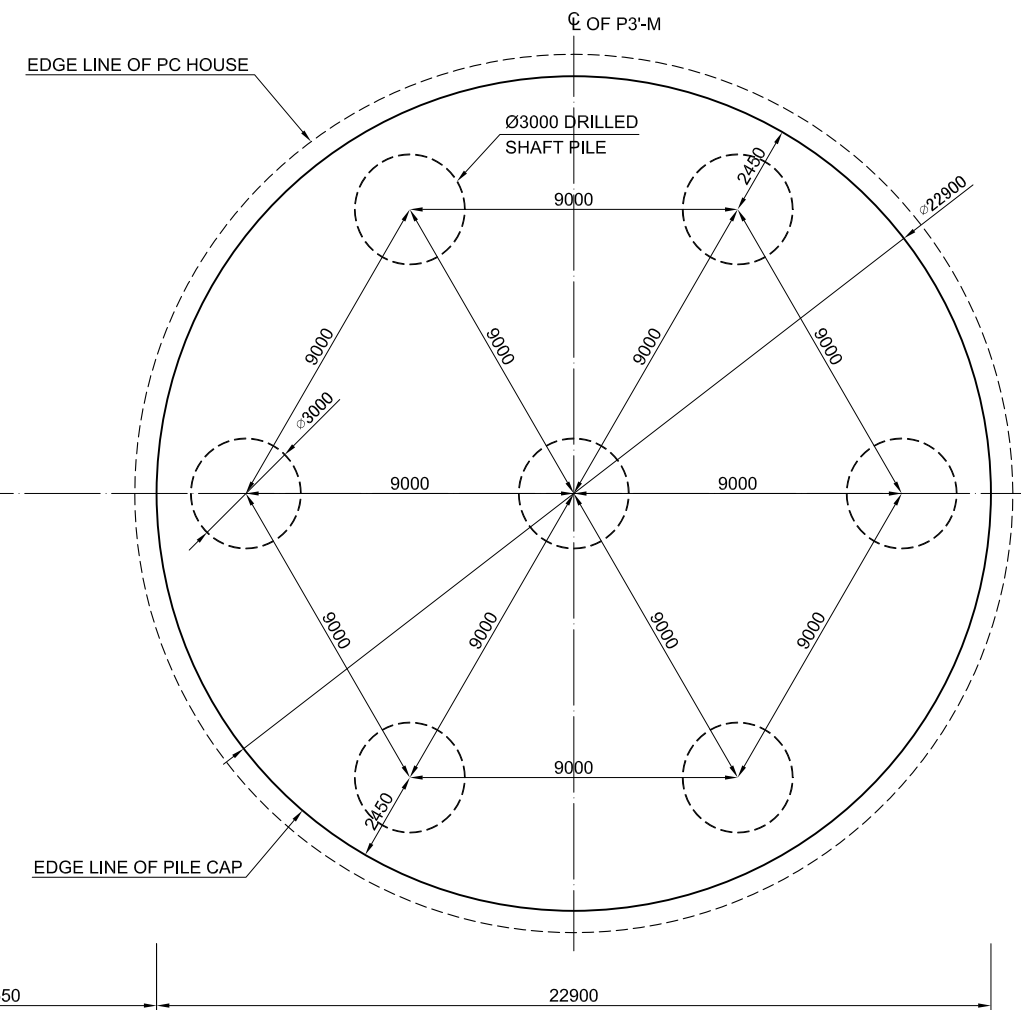

- ## NOTES:
1. ALL DIMENSIONS ARE IN MILLIMETERS AND ALL ELEVATIONS ARE IN METERS UNLESS OTHERWISE NOTED.
 2. CONCRETE SHALL BE DESIGN MIX AND HAVE MINIMUM 28 DAYS CHARACTERISTIC STRENGTH(CYLINDER)
-PYLON PILE CAP : 40MPa
-PYLON BASE : 50MPa
 3. REINFORCEMENT REBARS SHALL CONFORM TO ASTM A706 GRADE 80(550 MPa) FOR CARBON REBARS(YH).
 4. THE STAINLESS STEEL REINFORCEMENT IS RIBBED BARS.
 5. FOR SECTION D-D,E-E,F-F,G-G AND H-H REFER TO DRAWING
NO.RA140-22-BRG-CW-DW-32251.

STAINLESS STEEL REINFORCEMENT SHALL AS A MINIMUM COMPLY WITH THE FOLLOWING.

FOR BAR DIAMETER 6~50MM
HOT ROLLED, STEEL GRADE 1.4362 MINIMUM
Rp 0.2=500MPa, ACCORDING TO BS6744
AND DELIVERED WITH A 'CARES' CERTIFICATE
CUT AND BEND ACCORDING TO BS8666 WITH A
'CARES' CERTIFICATE (YS).

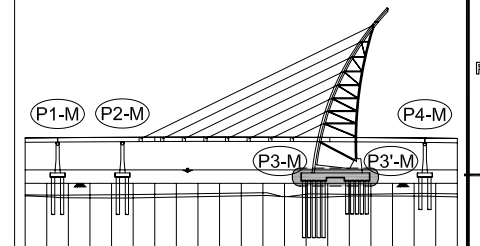

A3	17/06/15	Updated As Shown In Clouds	SWK	HSB	DKK
A2	05/06/15	Updated As Shown In Clouds	SWK	HSB	DKK
A1	08/04/15	First Issue	SWK	HSB	DKK
REV.	DATE	DESCRIPTION OF REVISION	DRAWN	CHEC.	APPRO.

EMPLOYER		
----------	--	--

STATE OF KUWAIT
MINISTRY OF PUBLIC WORKS
ROADS ADMINISTRATION



PROJECT TITLE

SHEIKH JABER AL AHMAD AL SABAH
CAUSEWAY PROJECT (MAIN LINK)
CONTRACT RA/140

DRAWING TITLE	MAIN BRIDGE PILE CAP OF PYLON GENERAL LAYOUT 4/4
---------------	--

SCALE	DRAWN	DESIGNED	CHECKED	APPROVED
AS SHOWN	SWK	DJB	HSH	DKK
DATE ISSUED				
08/04/15	08/04/15	08/04/15	08/04/15	08/04/15

08/04/18	
CONTRACTOR	




DESIGNER

SYSTRA


DRAWING NO.

RA140-22-BRG-CW-DW-32254	A3
--------------------------	----


EV.

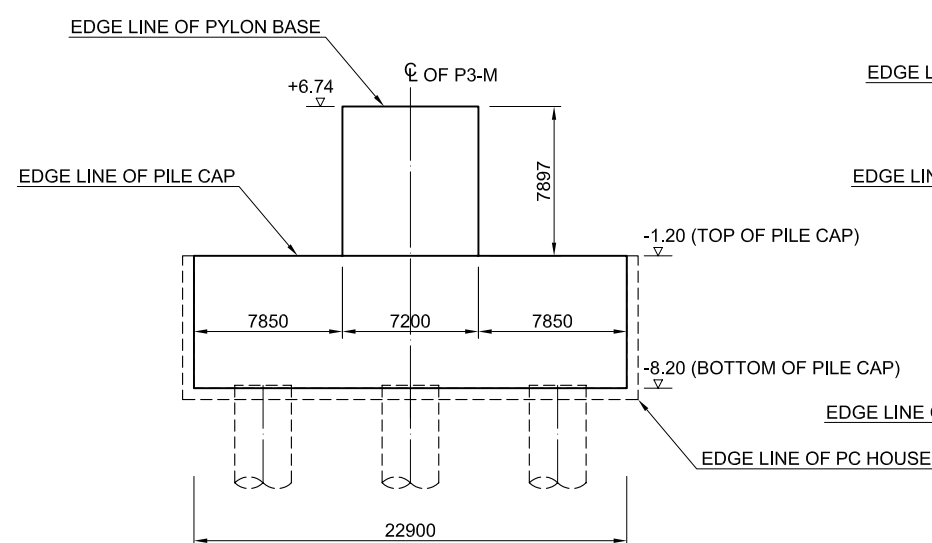


SECTION F-F
SCALE : 1/200

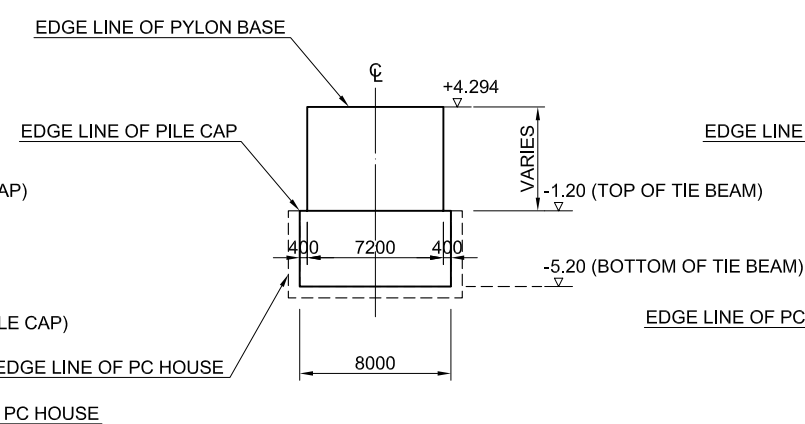

SECTION G-G
SCALE : 1/200

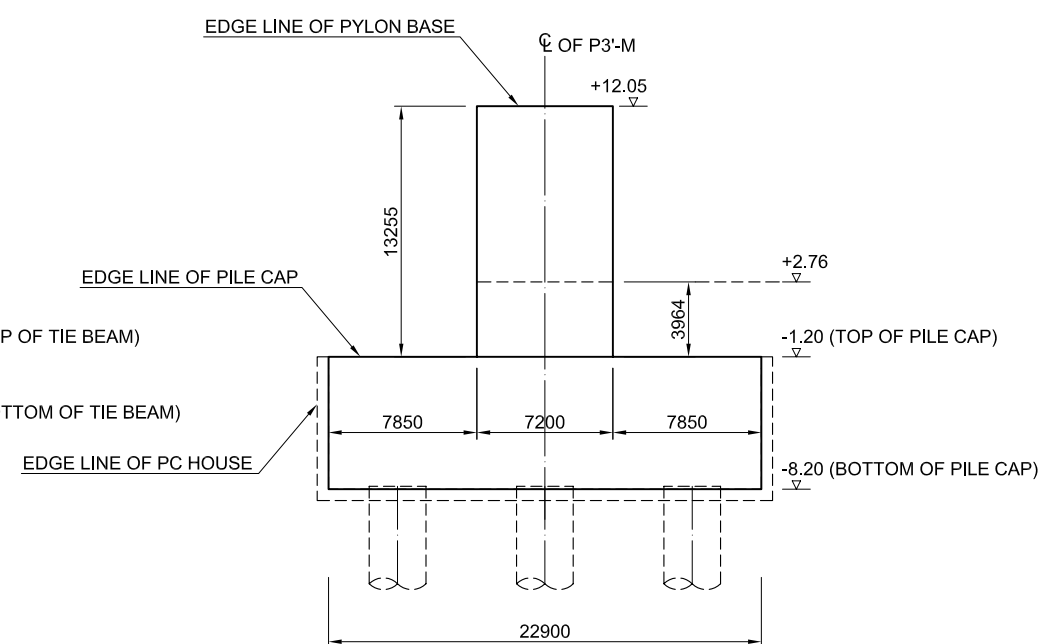



SECTION H-H
SCALE : 1/200

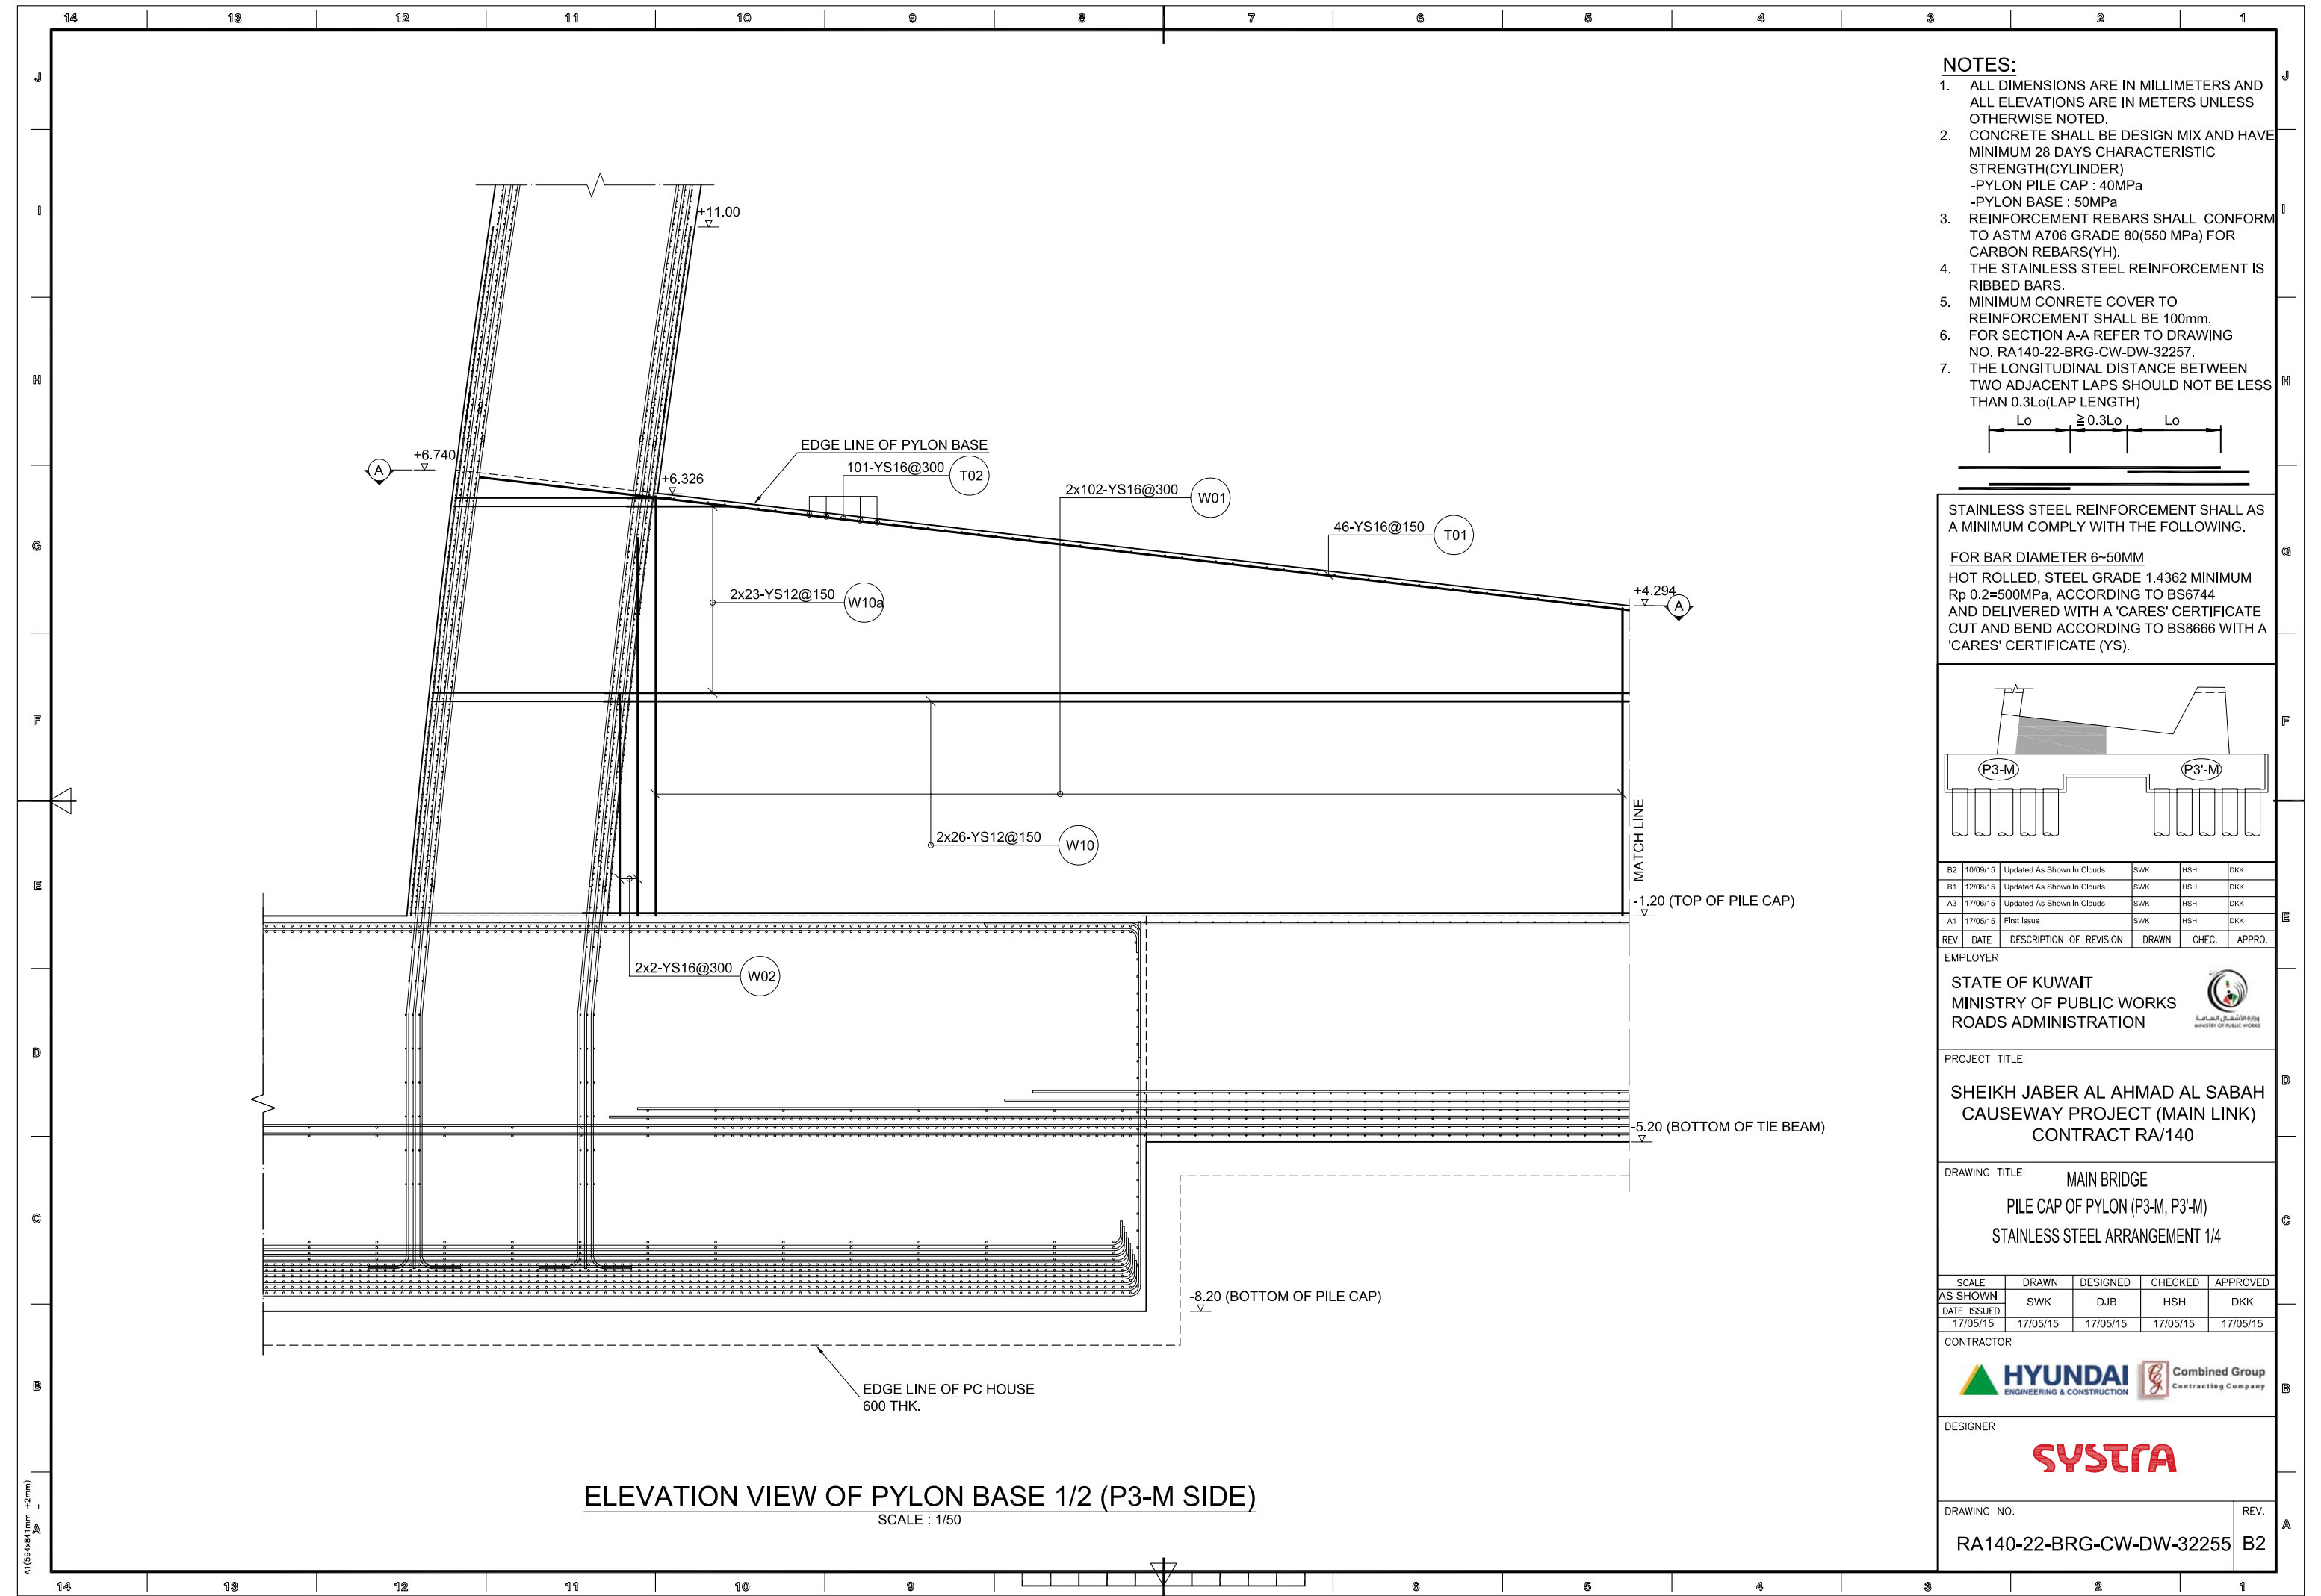





DRAWING NO.	REV.
RA140-22-BRG-CW-DW-32256	B2

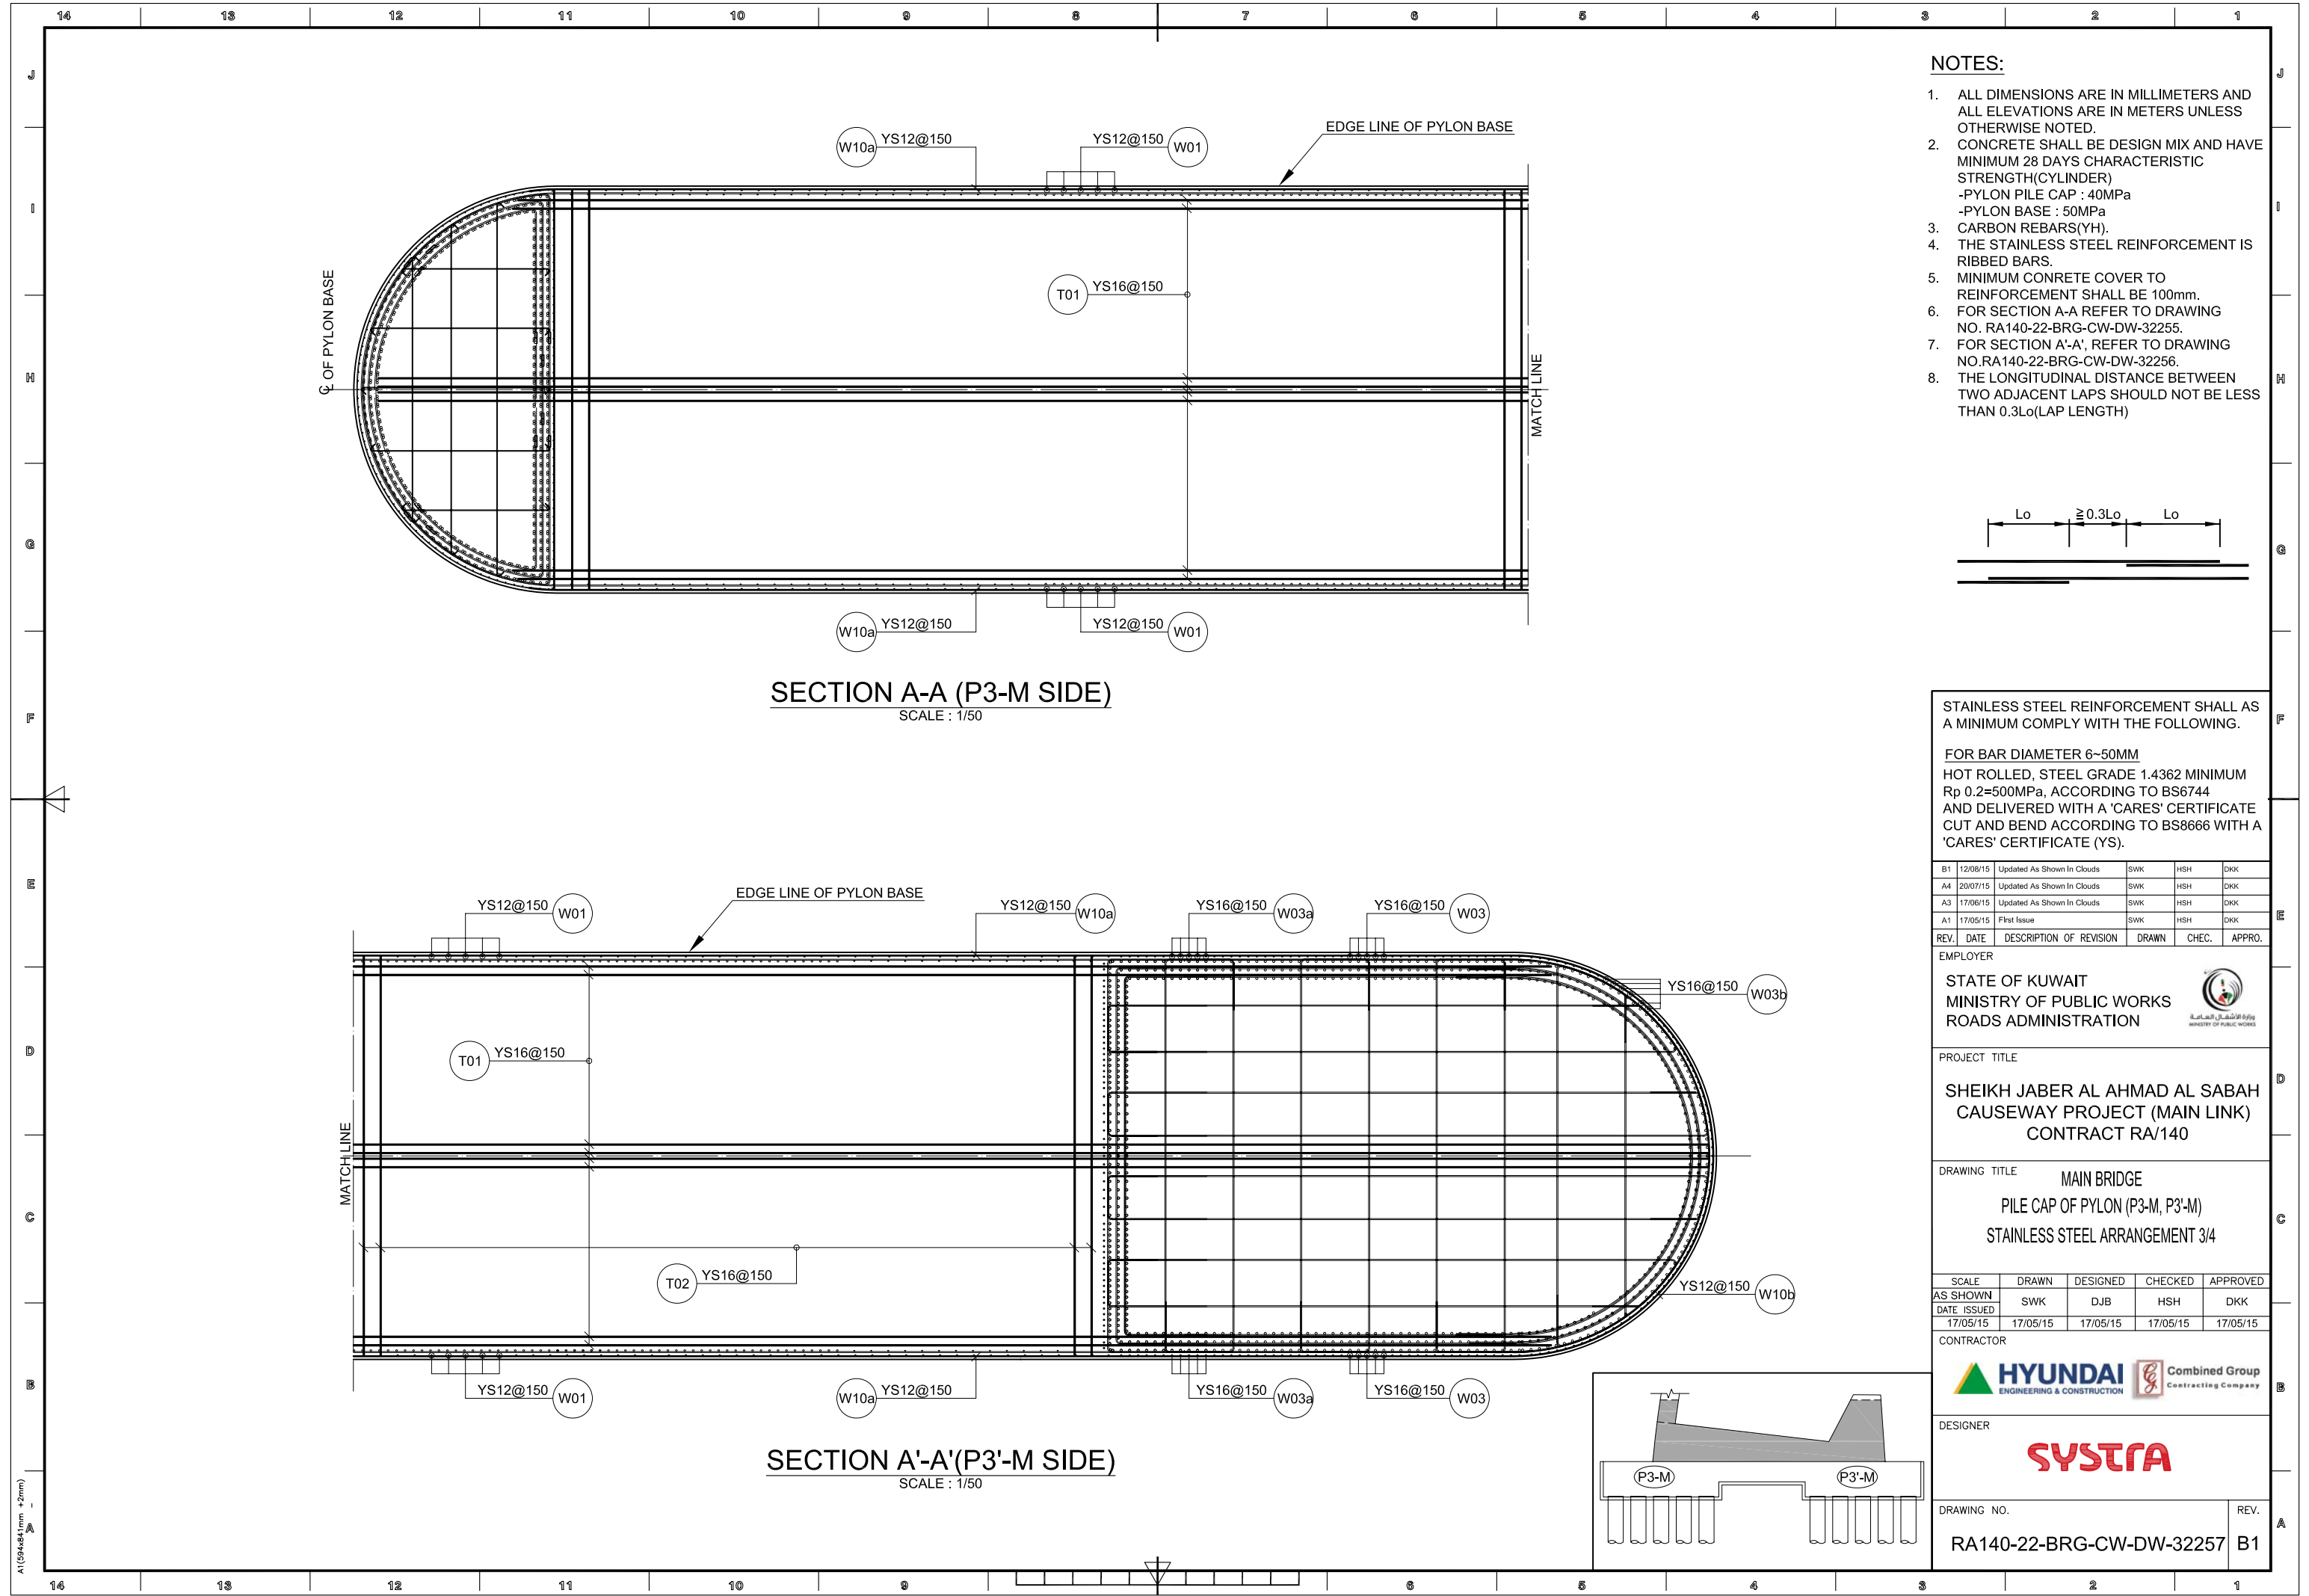

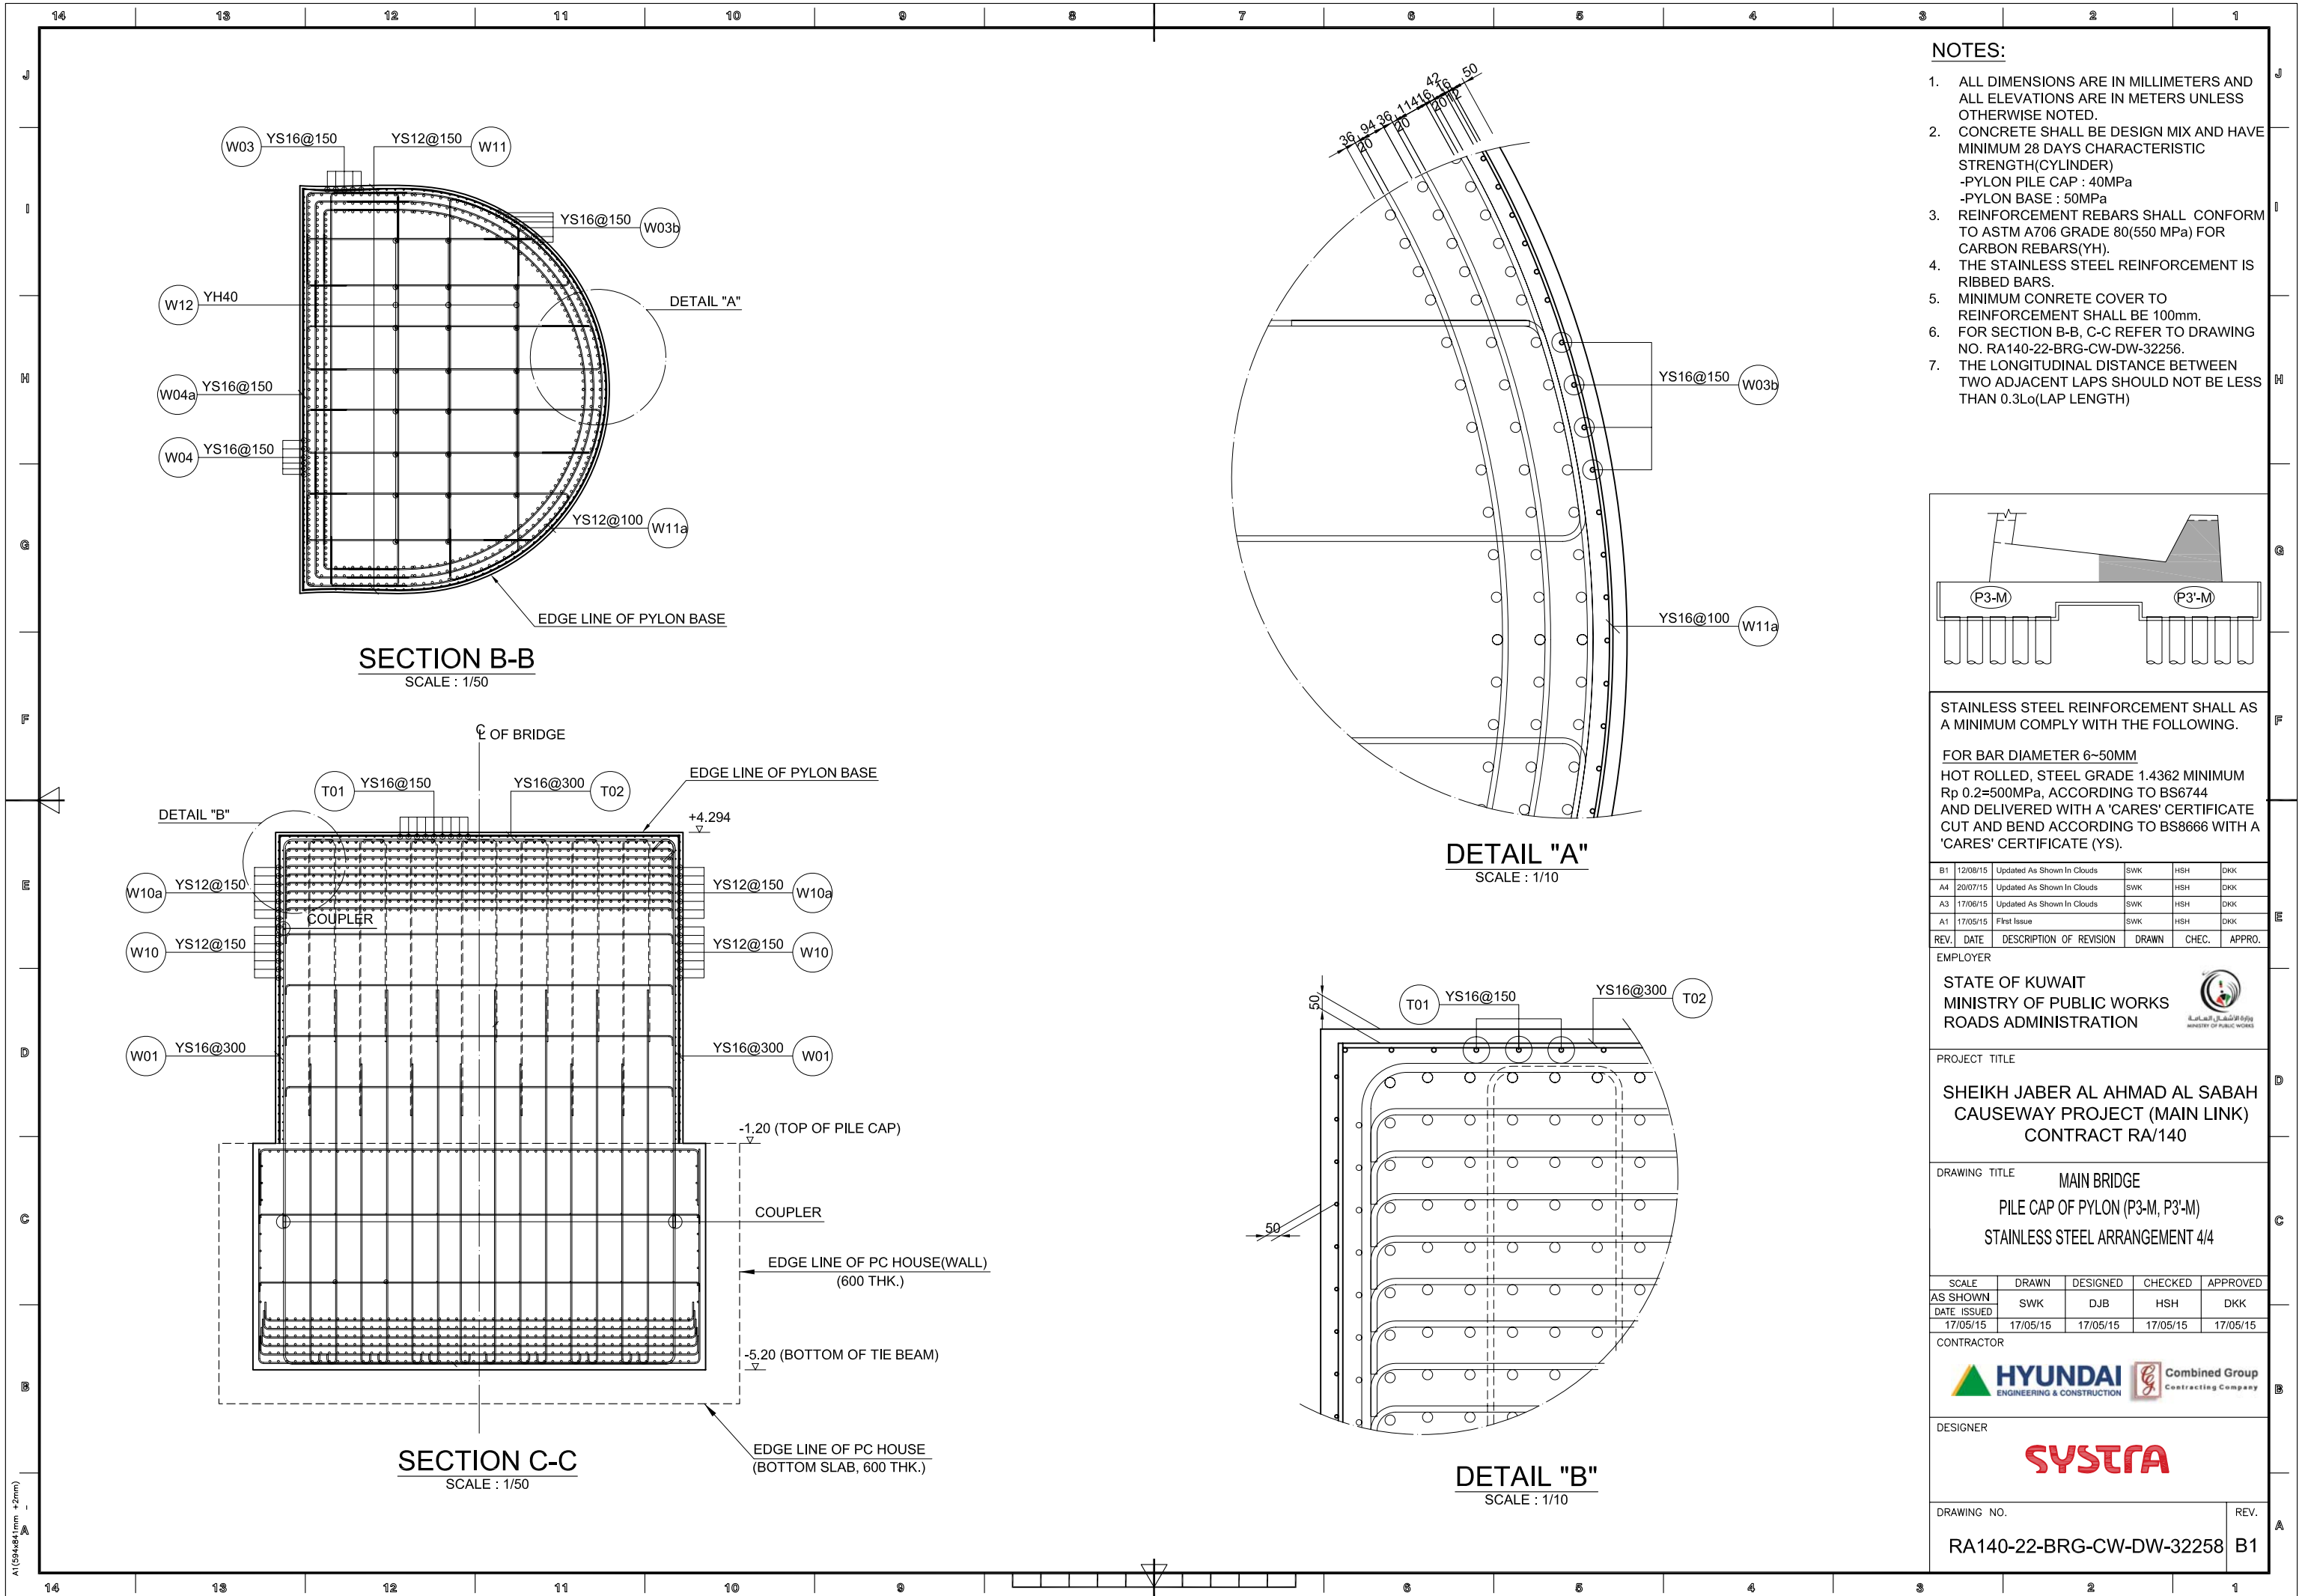

 

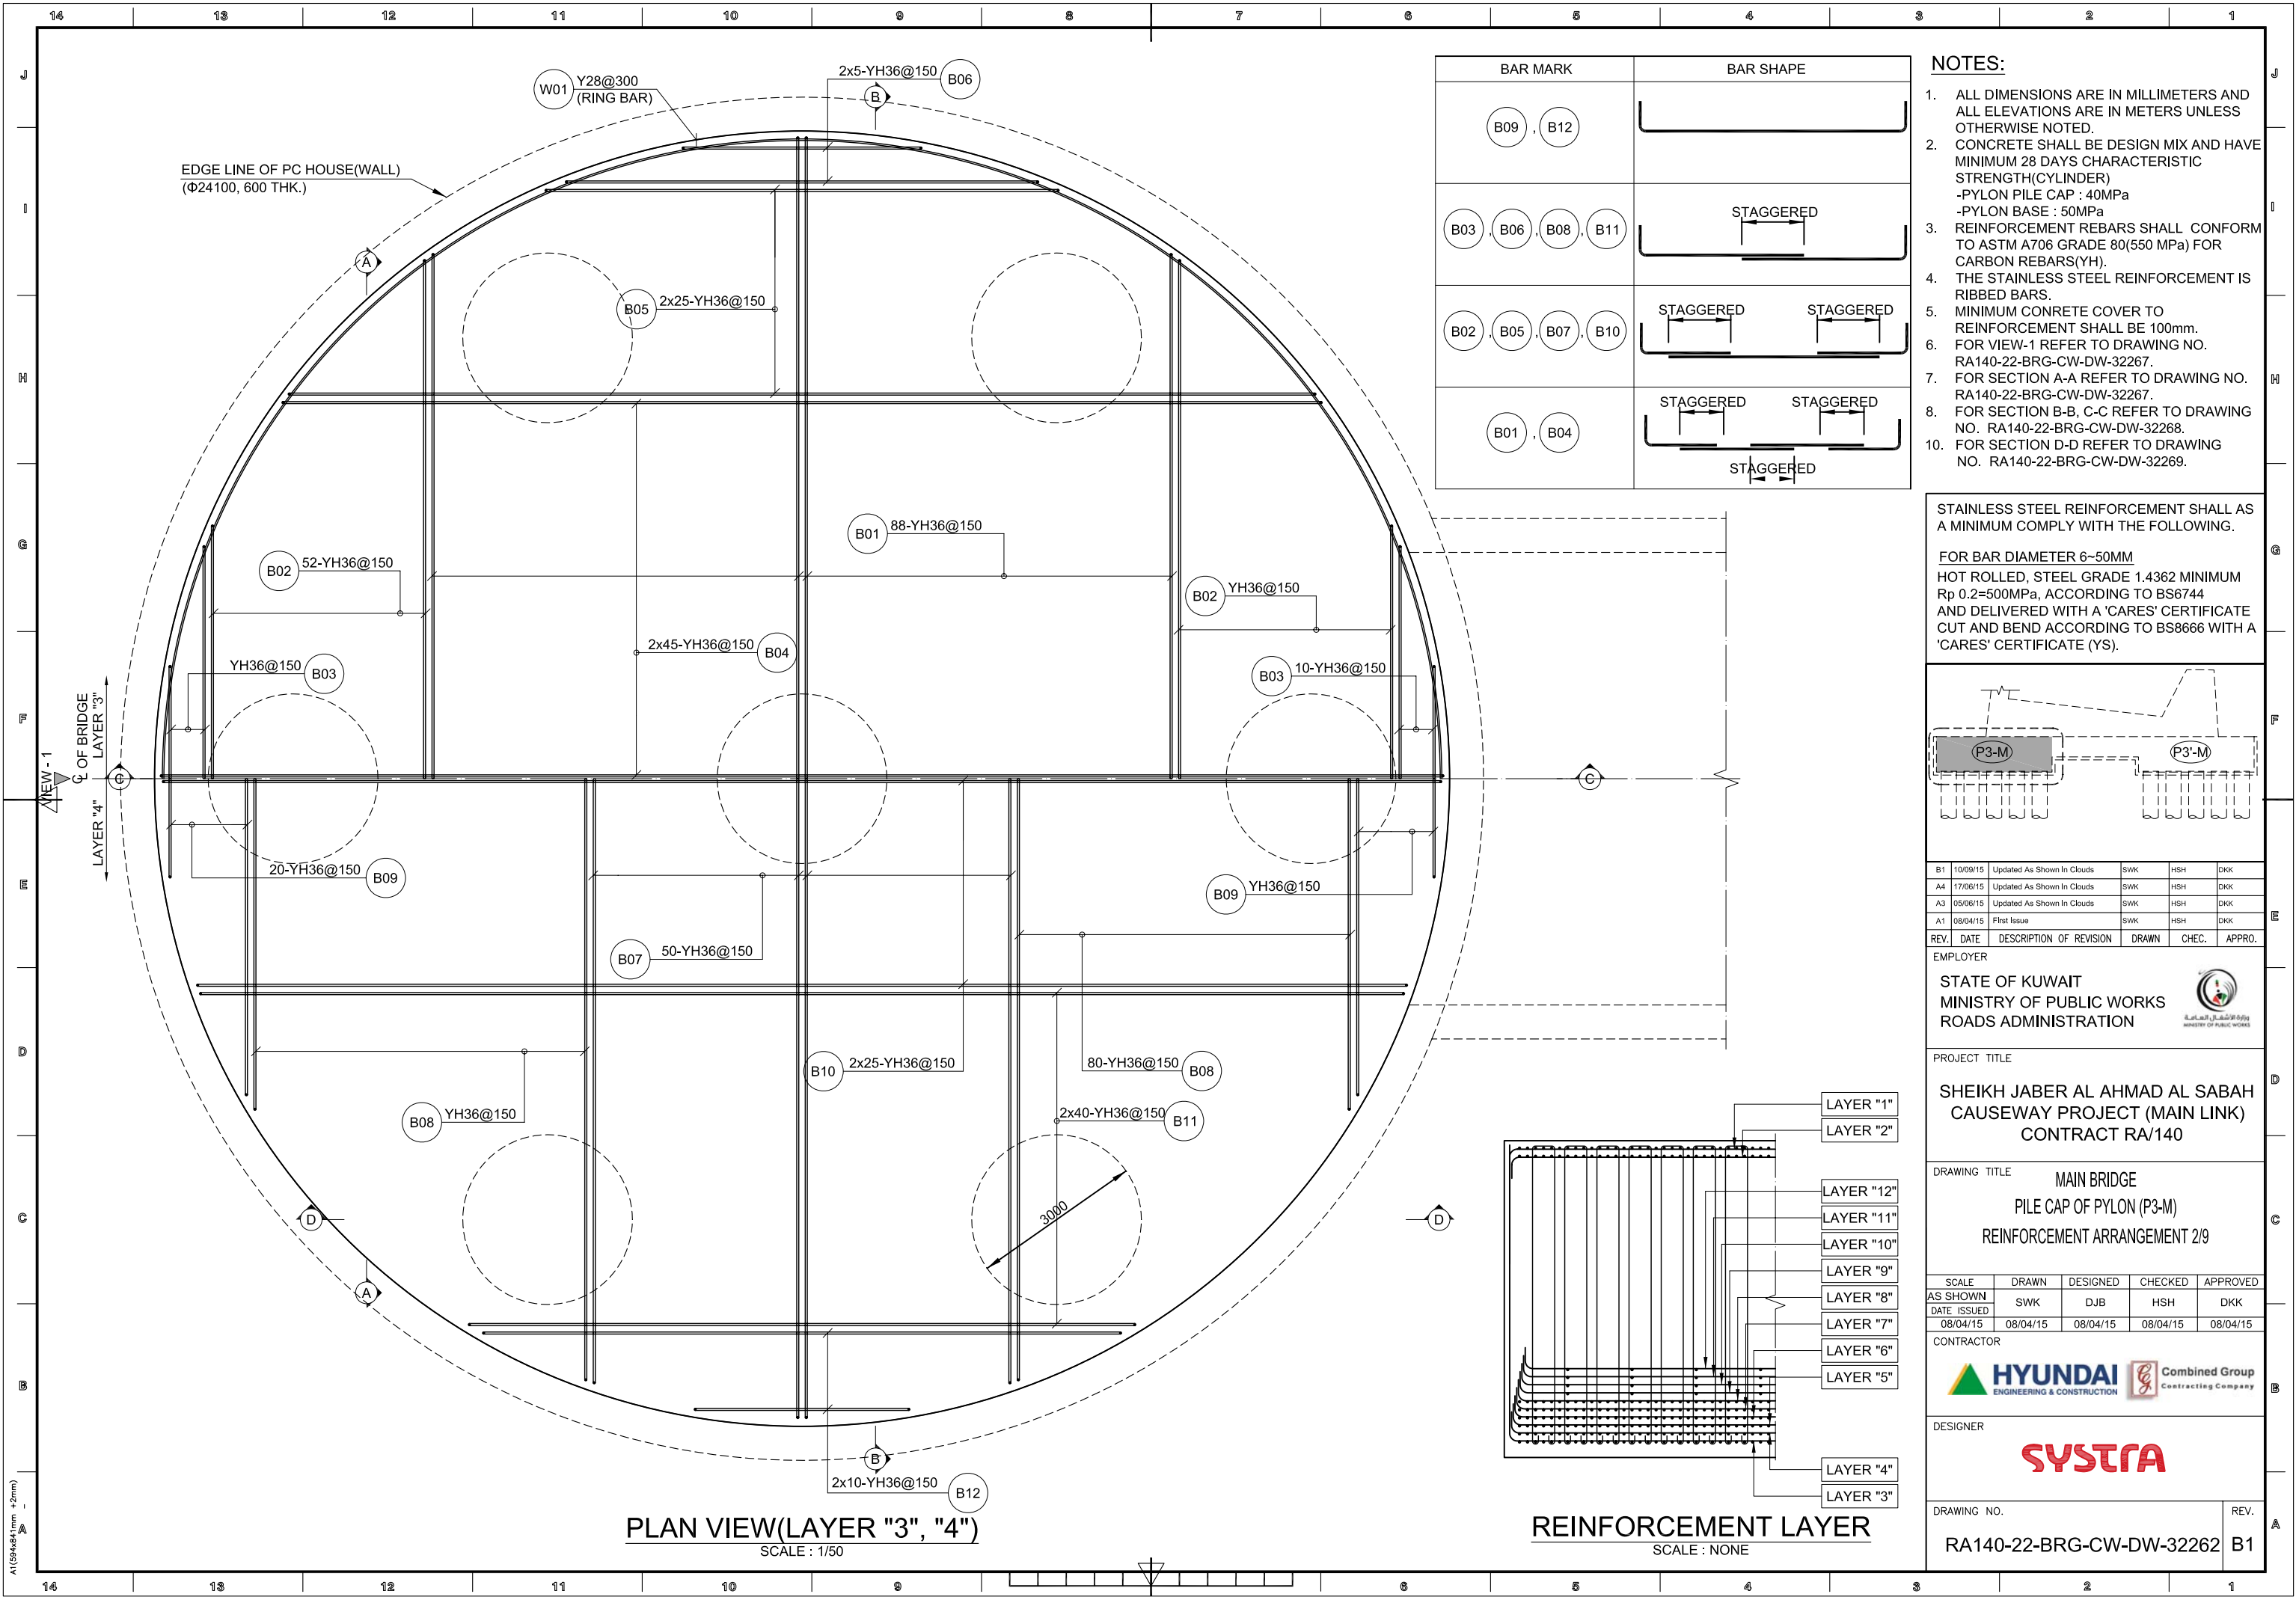


BAR MARK	BAR SHAPE
B09 , B12	
B03 , B06 , B08 , B11	
B02 , B05 , B07 , B10	
B01 , B04	

- NOTES:**
- ALL DIMENSIONS ARE IN MILLIMETERS AND ALL ELEVATIONS ARE IN METERS UNLESS OTHERWISE NOTED.
 - CONCRETE SHALL BE DESIGN MIX AND HAVE MINIMUM 28 DAYS CHARACTERISTIC STRENGTH(CYLINDER)
-PYLON PILE CAP : 40MPa
-PYLON BASE : 50MPa
 - REINFORCEMENT REBARS SHALL CONFORM TO ASTM A706 GRADE 80(550 MPa) FOR CARBON REBARS(YH).
 - THE STAINLESS STEEL REINFORCEMENT IS RIBBED BARS.
 - MINIMUM CONCRETE COVER TO REINFORCEMENT SHALL BE 100mm.
 - FOR VIEW-1 REFER TO DRAWING NO. RA140-22-BRG-CW-DW-32267.
 - FOR SECTION A-A REFER TO DRAWING NO. RA140-22-BRG-CW-DW-32267.
 - FOR SECTION B-B, C-C REFER TO DRAWING NO. RA140-22-BRG-CW-DW-32268.
 - FOR SECTION D-D REFER TO DRAWING NO. RA140-22-BRG-CW-DW-32269.

STAINLESS STEEL REINFORCEMENT SHALL AS A MINIMUM COMPLY WITH THE FOLLOWING.

FOR BAR DIAMETER 6-50MM
HOT ROLLED, STEEL GRADE 1.4362 MINIMUM
Rp 0.2=500MPa, ACCORDING TO BS6744
AND DELIVERED WITH A 'CARES' CERTIFICATE
CUT AND BEND ACCORDING TO BS8666 WITH A
'CARES' CERTIFICATE (YS).

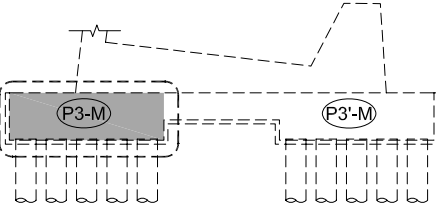

B1	10/09/15	Updated As Shown In Clouds	SWK	HSB	DKK
A4	17/06/15	Updated As Shown In Clouds	SWK	HSB	DKK
A3	05/06/15	Updated As Shown In Clouds	SWK	HSB	DKK
A1	08/04/15	First Issue	SWK	HSB	DKK
REV.	DATE	DESCRIPTION OF REVISION	DRAWN	CHEC.	APPRO.

EMPLOYER
STATE OF KUWAIT
MINISTRY OF PUBLIC WORKS
ROADS ADMINISTRATION

PROJECT TITLE
SHEIKH JABER AL AHMAD AL SABAH
CAUSEWAY PROJECT (MAIN LINK)
CONTRACT RA/140

DRAWING TITLE
MAIN BRIDGE
PILE CAP OF PYLON (P3-M)
REINFORCEMENT ARRANGEMENT 2/9

SCALE	DRAWN	DESIGNED	CHECKED	APPROVED
AS SHOWN	SWK	DJB	HSB	DKK
DATE ISSUED	08/04/15	08/04/15	08/04/15	08/04/15

CONTRACTOR
HYUNDAI ENGINEERING & CONSTRUCTION
Combined Group Contracting Company

DESIGNER
SYSTRA

DRAWING NO.
RA140-22-BRG-CW-DW-32262

REV.
B1

EDGE LINE OF PC HOUSE(WALL)
(Φ24100, 600 THK.)

2x10-YH36@150 B18

B13 50-YH36@150

B14 YH36@150

B16 2x25-YH36@150

80-YH36@150 B14

20-YH36@150 B15

20-YH36@150 B21

B20 YH36@150

B22 2x25-YH36@150

80-YH36@150 B20

2x40-YH36@150 B23

B19 50-YH36@150


2x10-YH36@150 B24

BAR MARK	BAR SHAPE
B15, B18, B21, B24	
B14, B17, B20, B23	
B13, B16, B19, B22	

- NOTES:**
- ALL DIMENSIONS ARE IN MILLIMETERS AND ALL ELEVATIONS ARE IN METERS UNLESS OTHERWISE NOTED.
 - CONCRETE SHALL BE DESIGN MIX AND HAVE MINIMUM 28 DAYS CHARACTERISTIC STRENGTH(CYLINDER)
-PYLON PILE CAP : 40MPa
-PYLON BASE : 50MPa
 - REINFORCEMENT REBARS SHALL CONFORM TO ASTM A706 GRADE 80(550 MPa) FOR CARBON REBARS(YH).
 - THE STAINLESS STEEL REINFORCEMENT IS RIBBED BARS.
 - MINIMUM CONCRETE COVER TO REINFORCEMENT SHALL BE 100mm.
 - FOR VIEW-1 REFER TO DRAWING NO. RA140-22-BRG-CW-DW-32267.
 - FOR SECTION A-A REFER TO DRAWING NO. RA140-22-BRG-CW-DW-32267.
 - FOR SECTION B-B, C-C REFER TO DRAWING NO. RA140-22-BRG-CW-DW-32268.
 - FOR SECTION D-D REFER TO DRAWING NO. RA140-22-BRG-CW-DW-32269.

STAINLESS STEEL REINFORCEMENT SHALL AS A MINIMUM COMPLY WITH THE FOLLOWING.

FOR BAR DIAMETER 6-50MM
HOT ROLLED, STEEL GRADE 1.4362 MINIMUM
Rp 0.2=500MPa, ACCORDING TO BS6744
AND DELIVERED WITH A 'CARES' CERTIFICATE CUT AND BEND ACCORDING TO BS8666 WITH A 'CARES' CERTIFICATE (YS).

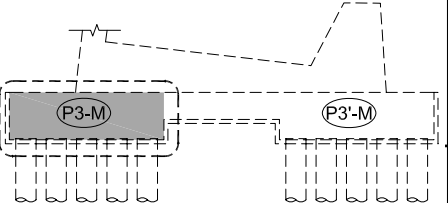

B1	10/09/15	Updated As Shown In Clouds	SWK	HSK	DKK
A4	17/06/15	Updated As Shown In Clouds	SWK	HSK	DKK
A3	05/06/15	Updated As Shown In Clouds	SWK	HSK	DKK
A1	08/04/15	First Issue	SWK	HSK	DKK
REV.	DATE	DESCRIPTION OF REVISION	DRAWN	CHEC.	APPRO.

EMPLOYER
STATE OF KUWAIT
MINISTRY OF PUBLIC WORKS
ROADS ADMINISTRATION

PROJECT TITLE
SHEIKH JABER AL AHMAD AL SABAH CAUSEWAY PROJECT (MAIN LINK)
CONTRACT RA/140

DRAWING TITLE
MAIN BRIDGE
PILE CAP OF PYLON (P3-M)
REINFORCEMENT ARRANGEMENT 3/9

SCALE	DRAWN	DESIGNED	CHECKED	APPROVED
AS SHOWN	SWK	DJB	HSK	DKK
DATE ISSUED	08/04/15	08/04/15	08/04/15	08/04/15

CONTRACTOR
HYUNDAI ENGINEERING & CONSTRUCTION
Combined Group Contracting Company


DESIGNER
SYSTRA


DRAWING NO.
RA140-22-BRG-CW-DW-32263

REV.
B1

PLAN VIEW(LAYER "5", "6")
SCALE : 1/50

REINFORCEMENT LAYER
SCALE : NONE

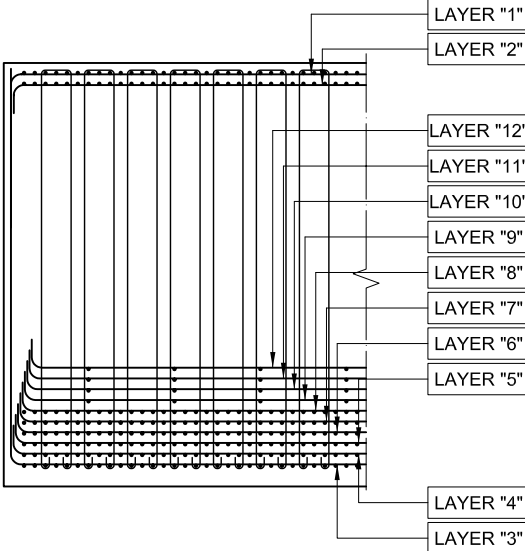

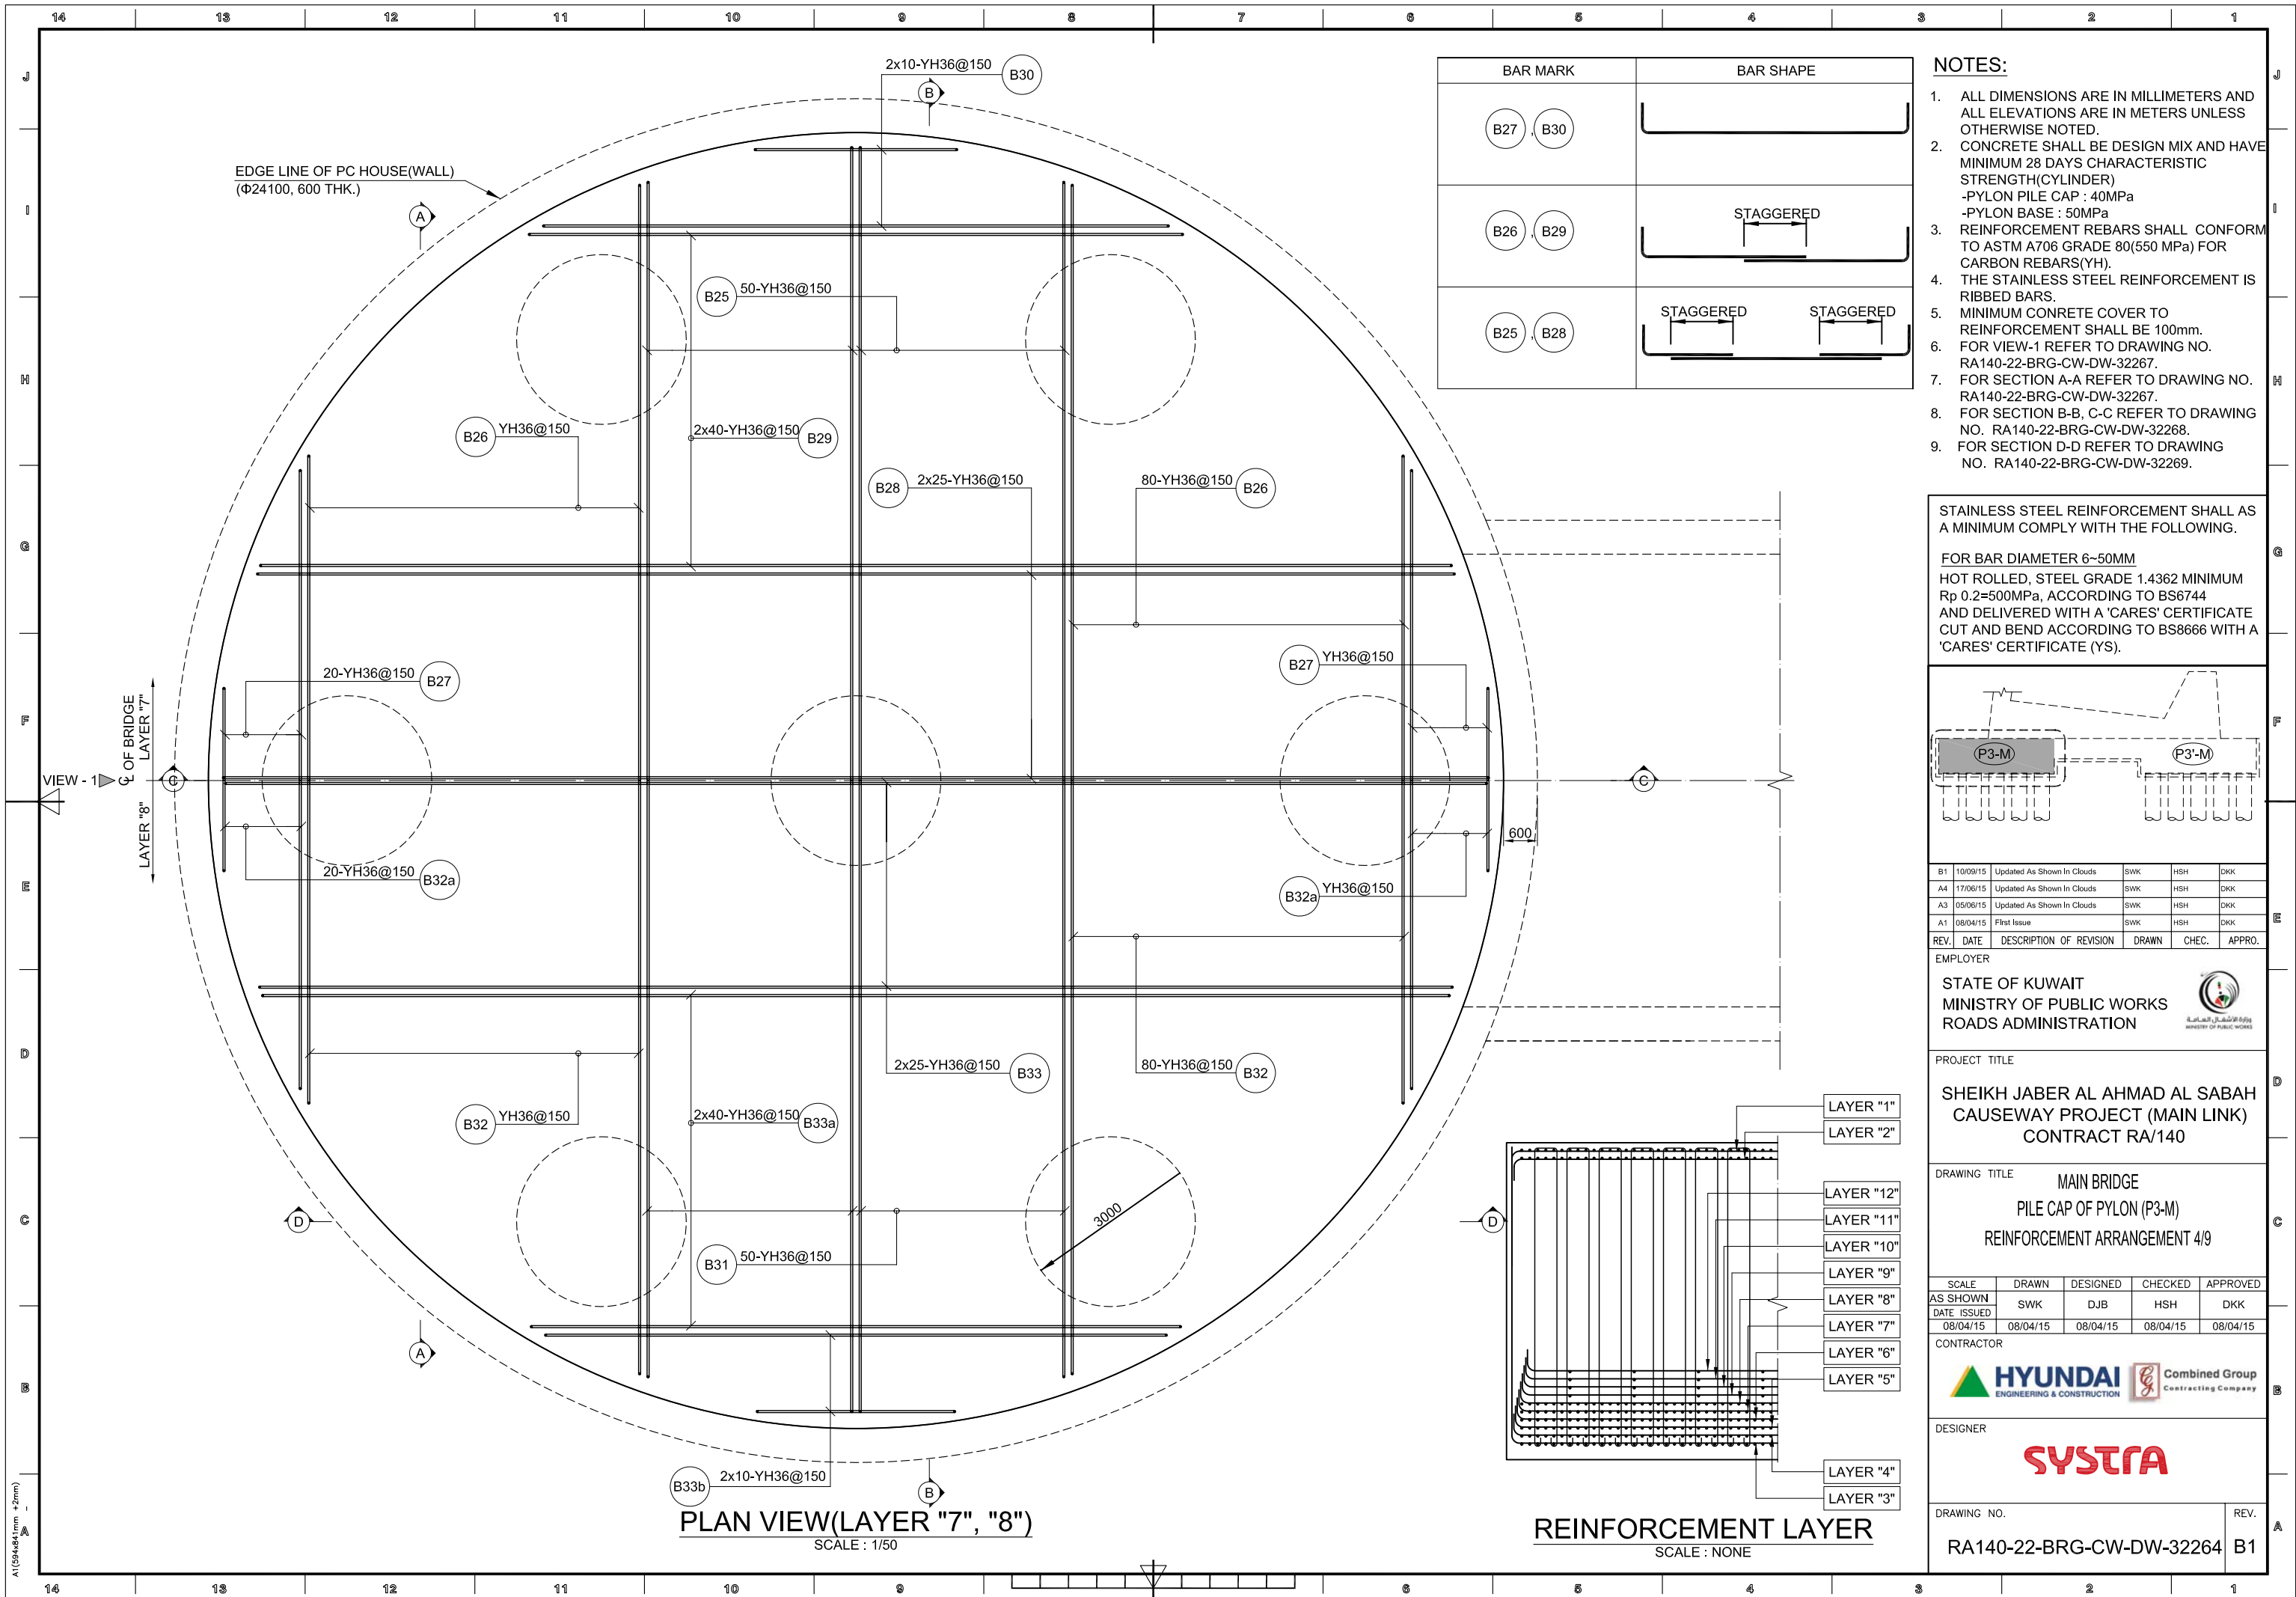


BAR MARK	BAR SHAPE
B27 B30	
B26 B29	
B25 B28	

- NOTES:**
- ALL DIMENSIONS ARE IN MILLIMETERS AND ALL ELEVATIONS ARE IN METERS UNLESS OTHERWISE NOTED.
 - CONCRETE SHALL BE DESIGN MIX AND HAVE MINIMUM 28 DAYS CHARACTERISTIC STRENGTH(CYLINDER)
-PYLON PILE CAP : 40MPa
-PYLON BASE : 50MPa
 - REINFORCEMENT REBARS SHALL CONFORM TO ASTM A706 GRADE 80(550 MPa) FOR CARBON REBARS(YH).
 - THE STAINLESS STEEL REINFORCEMENT IS RIBBED BARS.
 - MINIMUM CONCRETE COVER TO REINFORCEMENT SHALL BE 100mm.
 - FOR VIEW-1 REFER TO DRAWING NO. RA140-22-BRG-CW-DW-32267.
 - FOR SECTION A-A REFER TO DRAWING NO. RA140-22-BRG-CW-DW-32267.
 - FOR SECTION B-B, C-C REFER TO DRAWING NO. RA140-22-BRG-CW-DW-32268.
 - FOR SECTION D-D REFER TO DRAWING NO. RA140-22-BRG-CW-DW-32269.

STAINLESS STEEL REINFORCEMENT SHALL AS A MINIMUM COMPLY WITH THE FOLLOWING.

FOR BAR DIAMETER 6-50MM
HOT ROLLED, STEEL GRADE 1.4362 MINIMUM
Rp 0.2=500MPa, ACCORDING TO BS6744
AND DELIVERED WITH A 'CARES' CERTIFICATE CUT AND BEND ACCORDING TO BS8666 WITH A 'CARES' CERTIFICATE (YS).

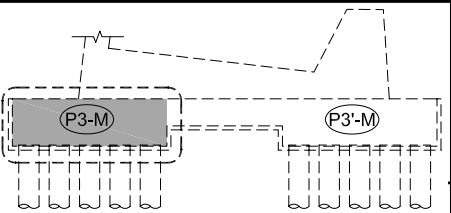

B1	10/09/15	Updated As Shown In Clouds	SWK	HSK	DKK
A4	17/06/15	Updated As Shown In Clouds	SWK	HSK	DKK
A3	05/06/15	Updated As Shown In Clouds	SWK	HSK	DKK
A1	08/04/15	First Issue	SWK	HSK	DKK
REV.	DATE	DESCRIPTION OF REVISION	DRAWN	CHEC.	APPRO.

EMPLOYER

STATE OF KUWAIT
MINISTRY OF PUBLIC WORKS
ROADS ADMINISTRATION

PROJECT TITLE

SHEIKH JABER AL AHMAD AL SABAH
CAUSEWAY PROJECT (MAIN LINK)
CONTRACT RA/140

DRAWING TITLE

MAIN BRIDGE
PILE CAP OF PYLON (P3-M)
REINFORCEMENT ARRANGEMENT 4/9

SCALE	DRAWN	DESIGNED	CHECKED	APPROVED
AS SHOWN	SWK	DJB	HSK	DKK
DATE ISSUED	08/04/15	08/04/15	08/04/15	08/04/15

CONTRACTOR


DESIGNER

DRAWING NO.

RA140-22-BRG-CW-DW-32264

REV.

B1

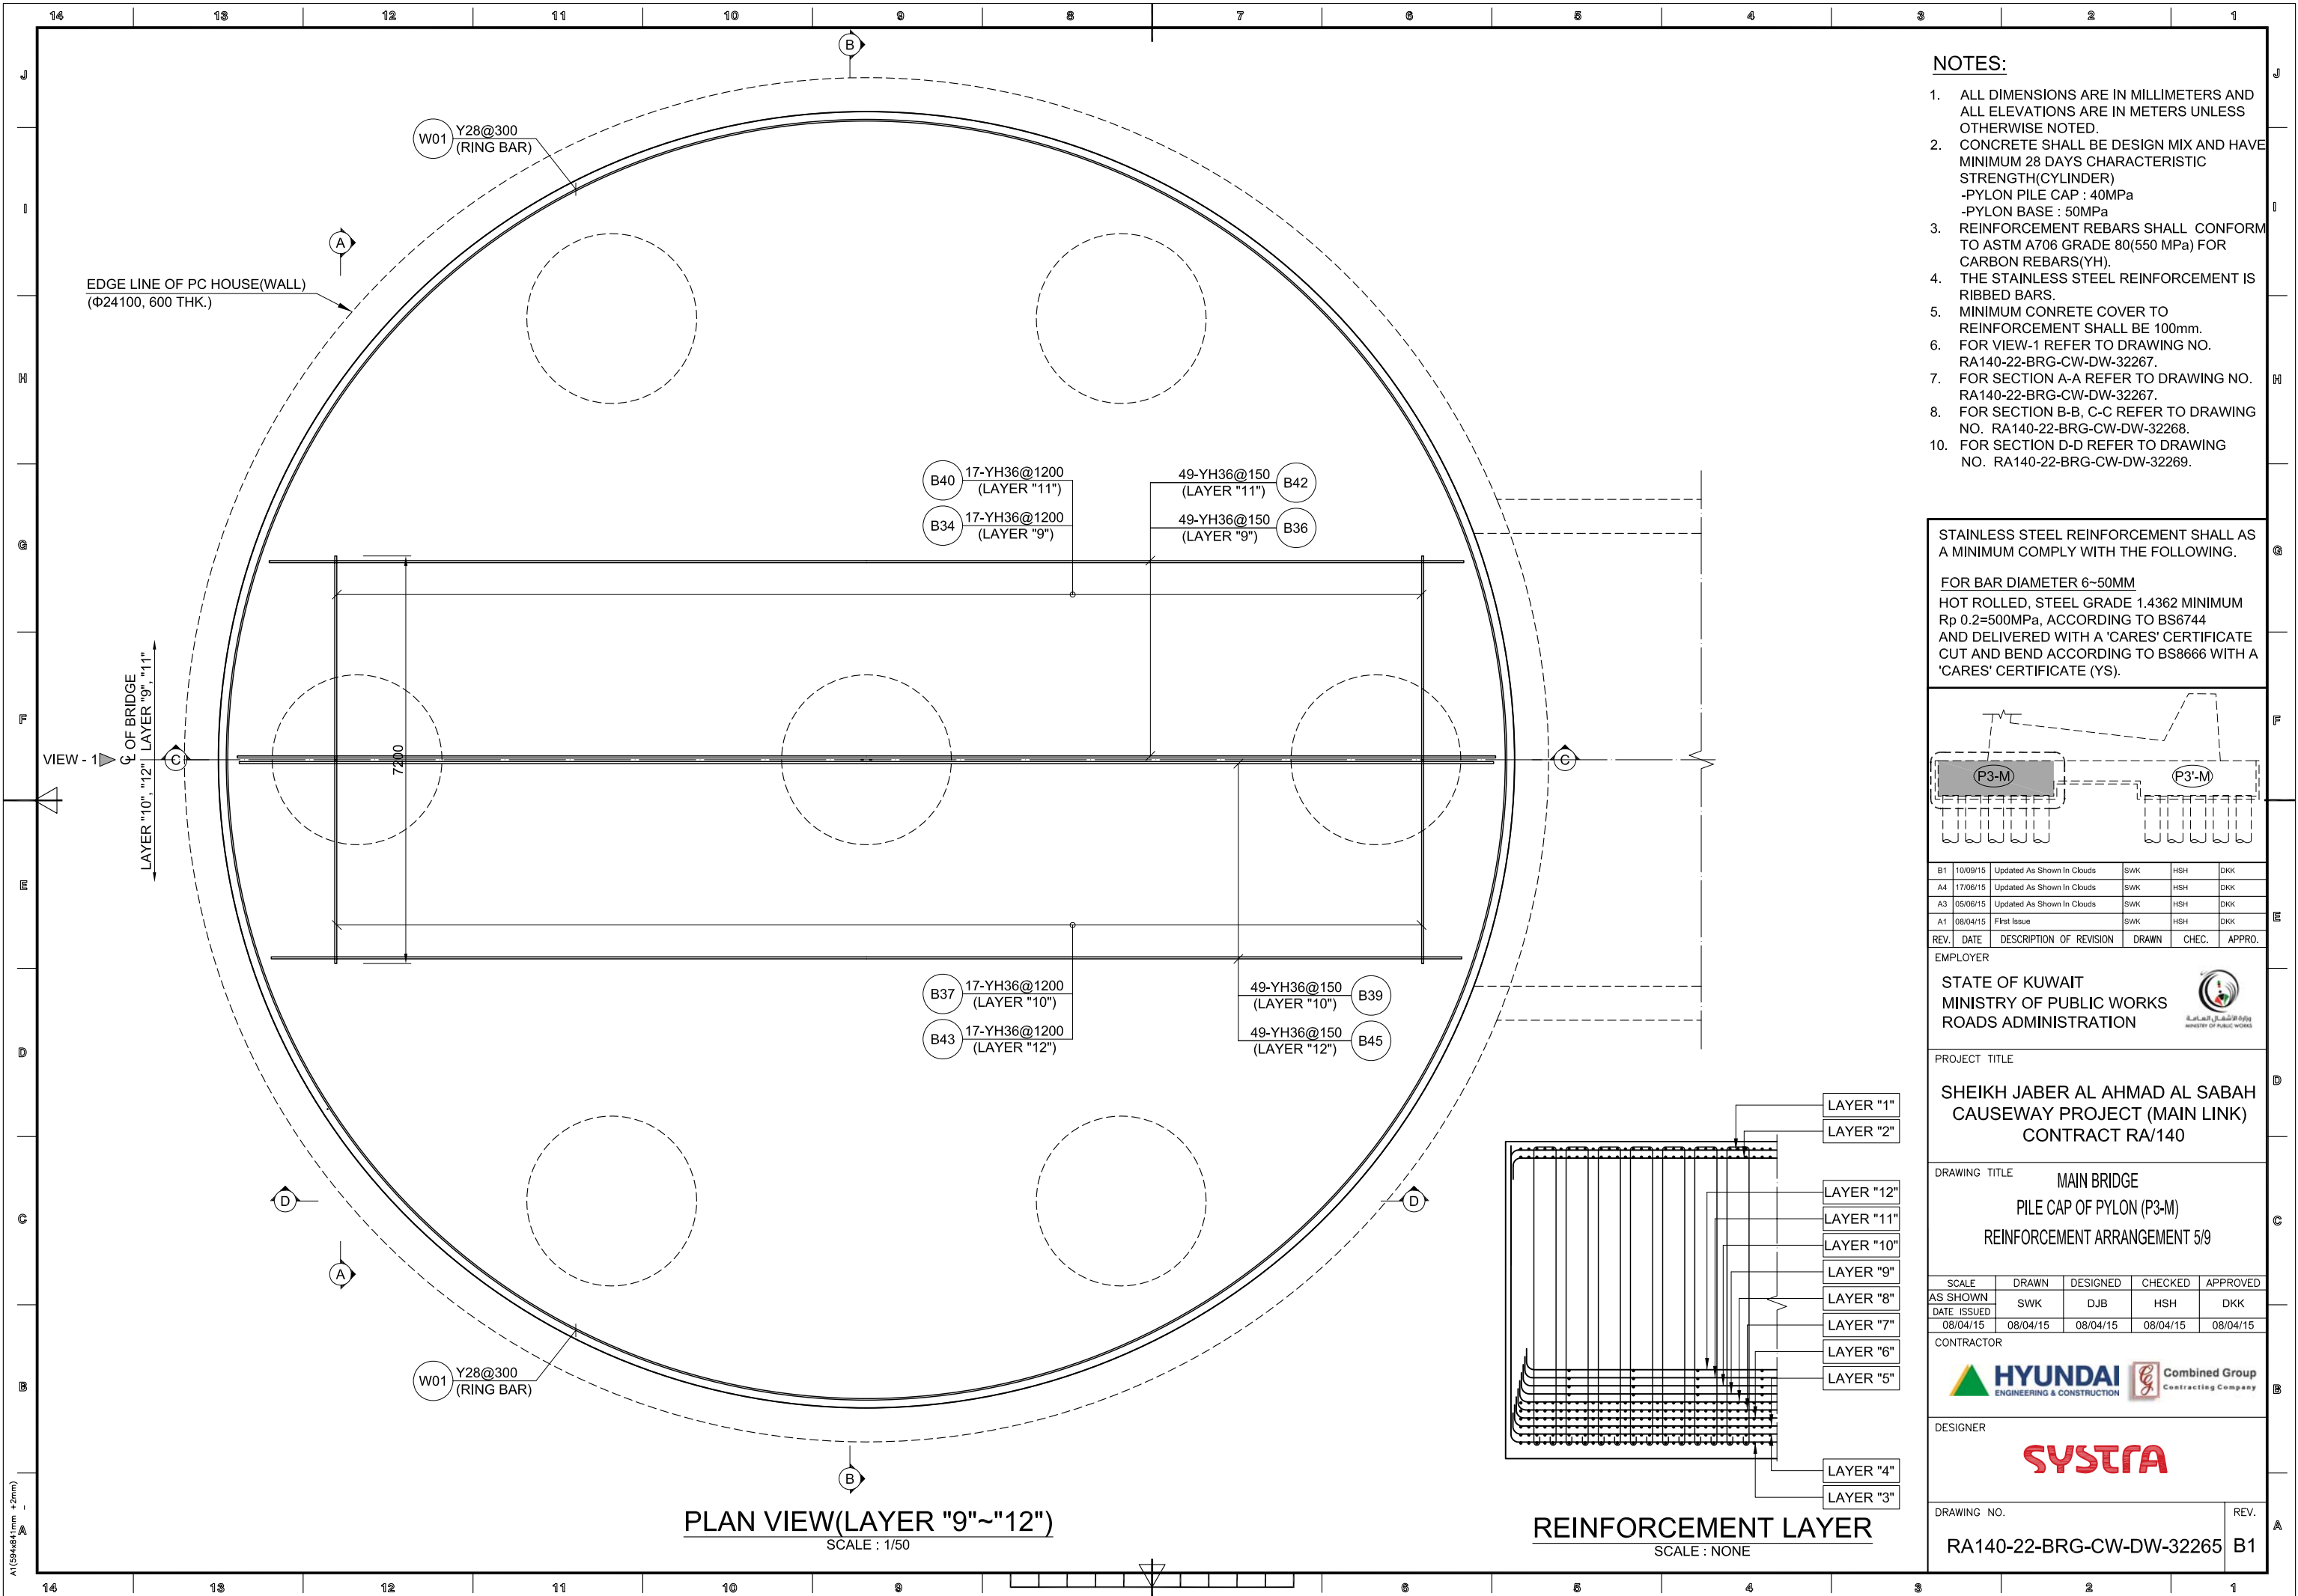


NOTES:

- ALL DIMENSIONS ARE IN MILLIMETERS AND ALL ELEVATIONS ARE IN METERS UNLESS OTHERWISE NOTED.
- CONCRETE SHALL BE DESIGN MIX AND HAVE MINIMUM 28 DAYS CHARACTERISTIC STRENGTH(CYLINDER)
-PYLON PILE CAP : 40MPa
-PYLON BASE : 50MPa
- REINFORCEMENT REBARS SHALL CONFORM TO ASTM A706 GRADE 80(550 MPa) FOR CARBON REBARS(YH).
- THE STAINLESS STEEL REINFORCEMENT IS RIBBED BARS.
- MINIMUM CONCRETE COVER TO REINFORCEMENT SHALL BE 100mm.
- FOR VIEW-1 REFER TO DRAWING NO. RA140-22-BRG-CW-DW-32267.
- FOR SECTION A-A REFER TO DRAWING NO. RA140-22-BRG-CW-DW-32267.
- FOR SECTION B-B, C-C REFER TO DRAWING NO. RA140-22-BRG-CW-DW-32268.
- FOR SECTION D-D REFER TO DRAWING NO. RA140-22-BRG-CW-DW-32269.

STAINLESS STEEL REINFORCEMENT SHALL AS A MINIMUM COMPLY WITH THE FOLLOWING.

FOR BAR DIAMETER 6~50MM
HOT ROLLED, STEEL GRADE 1.4362 MINIMUM
Rp 0.2=500MPa, ACCORDING TO BS6744
AND DELIVERED WITH A 'CARES' CERTIFICATE CUT AND BEND ACCORDING TO BS8666 WITH A 'CARES' CERTIFICATE (YS).

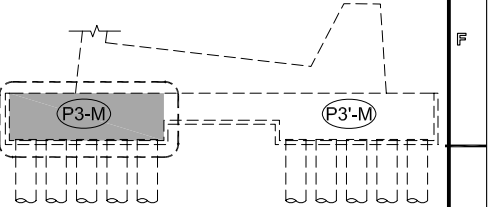

B1	10/09/15	Updated As Shown In Clouds	SWK	HSK	DKK
A4	17/06/15	Updated As Shown In Clouds	SWK	HSK	DKK
A3	05/06/15	Updated As Shown In Clouds	SWK	HSK	DKK
A1	08/04/15	First Issue	SWK	HSK	DKK
REV.	DATE	DESCRIPTION OF REVISION	DRAWN	CHEC.	APPRO.

EMPLOYER
STATE OF KUWAIT
MINISTRY OF PUBLIC WORKS
ROADS ADMINISTRATION

PROJECT TITLE
SHEIKH JABER AL AHMAD AL SABAH
CAUSEWAY PROJECT (MAIN LINK)
CONTRACT RA/140


DRAWING TITLE
MAIN BRIDGE
PILE CAP OF PYLON (P3-M)
REINFORCEMENT ARRANGEMENT 5/9

SCALE	DRAWN	DESIGNED	CHECKED	APPROVED
AS SHOWN	SWK	DJB	HSK	DKK
DATE ISSUED	08/04/15	08/04/15	08/04/15	08/04/15

CONTRACTOR
HYUNDAI ENGINEERING & CONSTRUCTION
Combined Group Contracting Company

DESIGNER
SYSTRA

DRAWING NO.
RA140-22-BRG-CW-DW-32265
REV.
B1

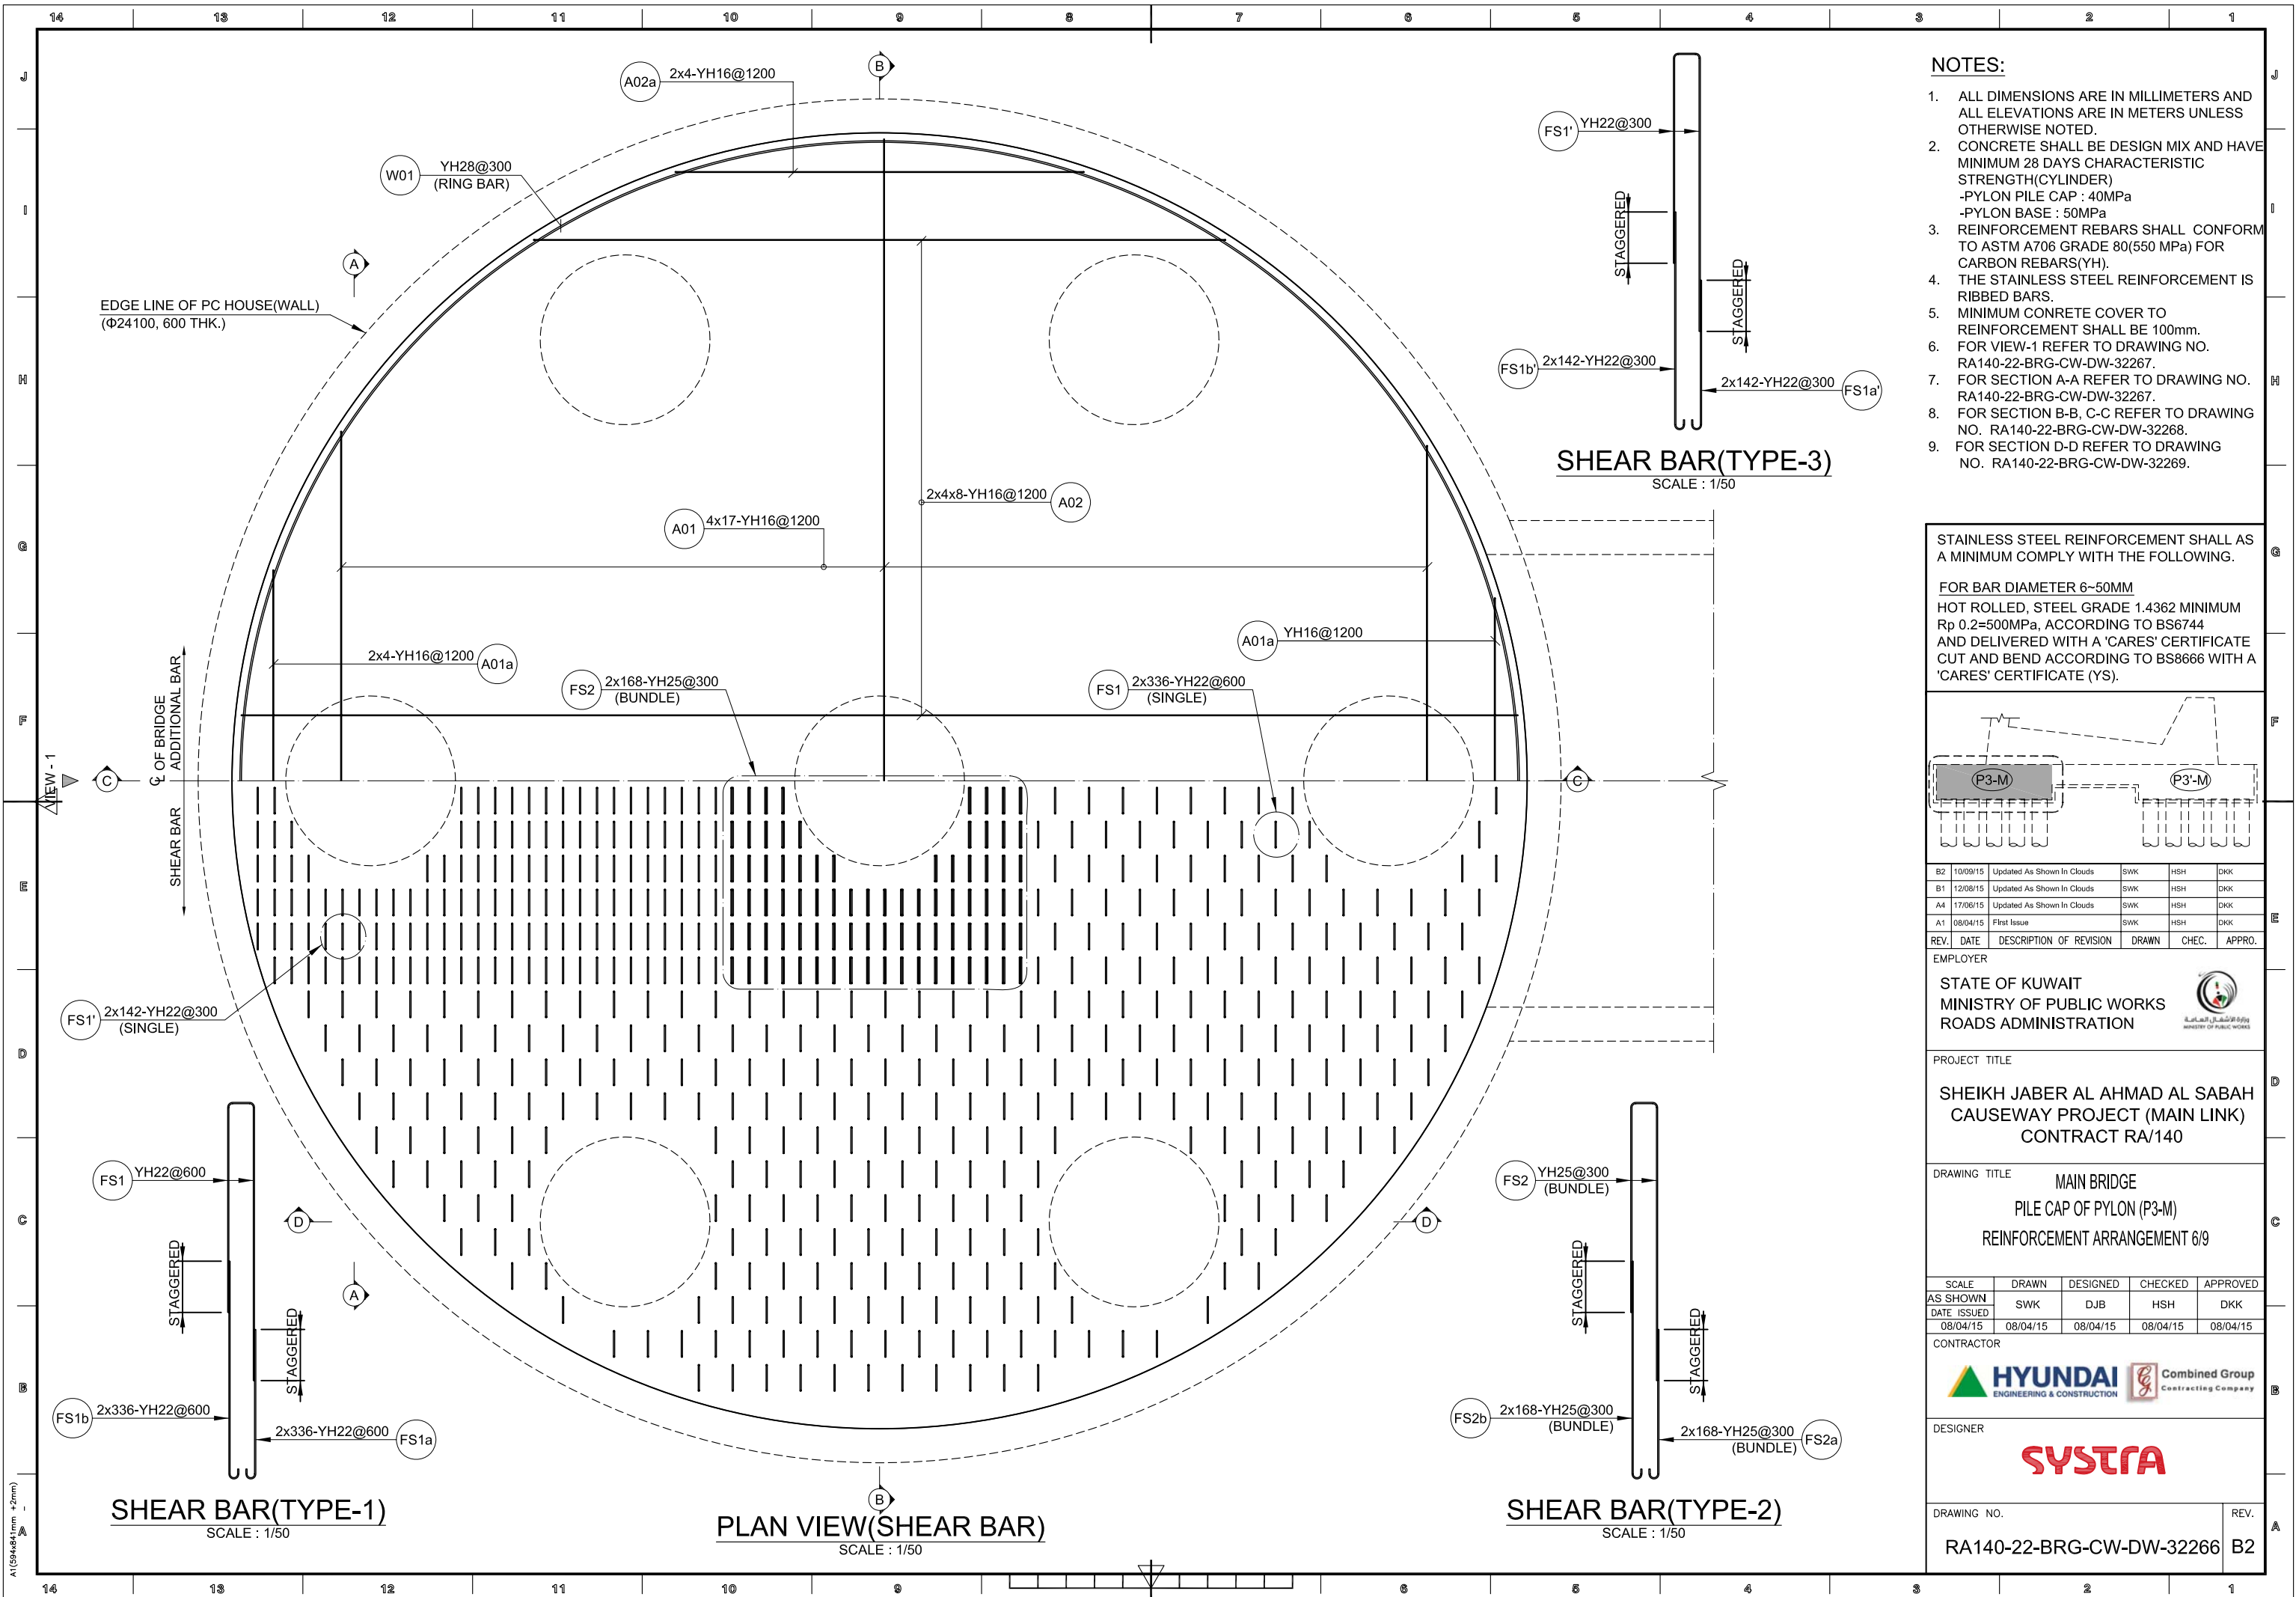


NOTES:

1. ALL DIMENSIONS ARE IN MILLIMETERS AND ALL ELEVATIONS ARE IN METERS UNLESS OTHERWISE NOTED.
2. CONCRETE SHALL BE DESIGN MIX AND HAVE MINIMUM 28 DAYS CHARACTERISTIC STRENGTH(CYLINDER)
-PYLON PILE CAP : 40MPa
-PYLON BASE : 50MPa
3. REINFORCEMENT REBARS SHALL CONFORM TO ASTM A706 GRADE 80(550 MPa) FOR CARBON REBARS(YH).
4. THE STAINLESS STEEL REINFORCEMENT IS RIBBED BARS.
5. MINIMUM CONCRETE COVER TO REINFORCEMENT SHALL BE 100mm.
6. FOR VIEW-1 REFER TO DRAWING NO. RA140-22-BRG-CW-DW-32267.
7. FOR SECTION A-A REFER TO DRAWING NO. RA140-22-BRG-CW-DW-32267.
8. FOR SECTION B-B, C-C REFER TO DRAWING NO. RA140-22-BRG-CW-DW-32268.
9. FOR SECTION D-D REFER TO DRAWING NO. RA140-22-BRG-CW-DW-32269.

STAINLESS STEEL REINFORCEMENT SHALL AS A MINIMUM COMPLY WITH THE FOLLOWING.

FOR BAR DIAMETER 6-50MM
HOT ROLLED, STEEL GRADE 1.4362 MINIMUM
Rp 0.2=500MPa, ACCORDING TO BS6744
AND DELIVERED WITH A 'CARES' CERTIFICATE
CUT AND BEND ACCORDING TO BS8666 WITH A
'CARES' CERTIFICATE (YS).

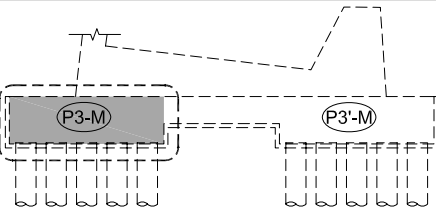

B2	10/09/15	Updated As Shown In Clouds	SWK	HSK	DKK
B1	12/08/15	Updated As Shown In Clouds	SWK	HSK	DKK
A4	17/06/15	Updated As Shown In Clouds	SWK	HSK	DKK
A1	08/04/15	First Issue	SWK	HSK	DKK
REV.	DATE	DESCRIPTION OF REVISION	DRAWN	CHEC.	APPRO.

EMPLOYER

STATE OF KUWAIT
MINISTRY OF PUBLIC WORKS
ROADS ADMINISTRATION



PROJECT TITLE

SHEIKH JABER AL AHMAD AL SABAH
CAUSEWAY PROJECT (MAIN LINK)
CONTRACT RA/140

DRAWING TITLE

MAIN BRIDGE
PILE CAP OF PYLON (P3-M)
REINFORCEMENT ARRANGEMENT 6/9

SCALE	DRAWN	DESIGNED	CHECKED	APPROVED
AS SHOWN	SWK	DJB	HSK	DKK
DATE ISSUED	08/04/15	08/04/15	08/04/15	08/04/15

CONTRACTOR



DESIGNER


SYSTRA


DRAWING NO.

RA140-22-BRG-CW-DW-32266

REV.

B2

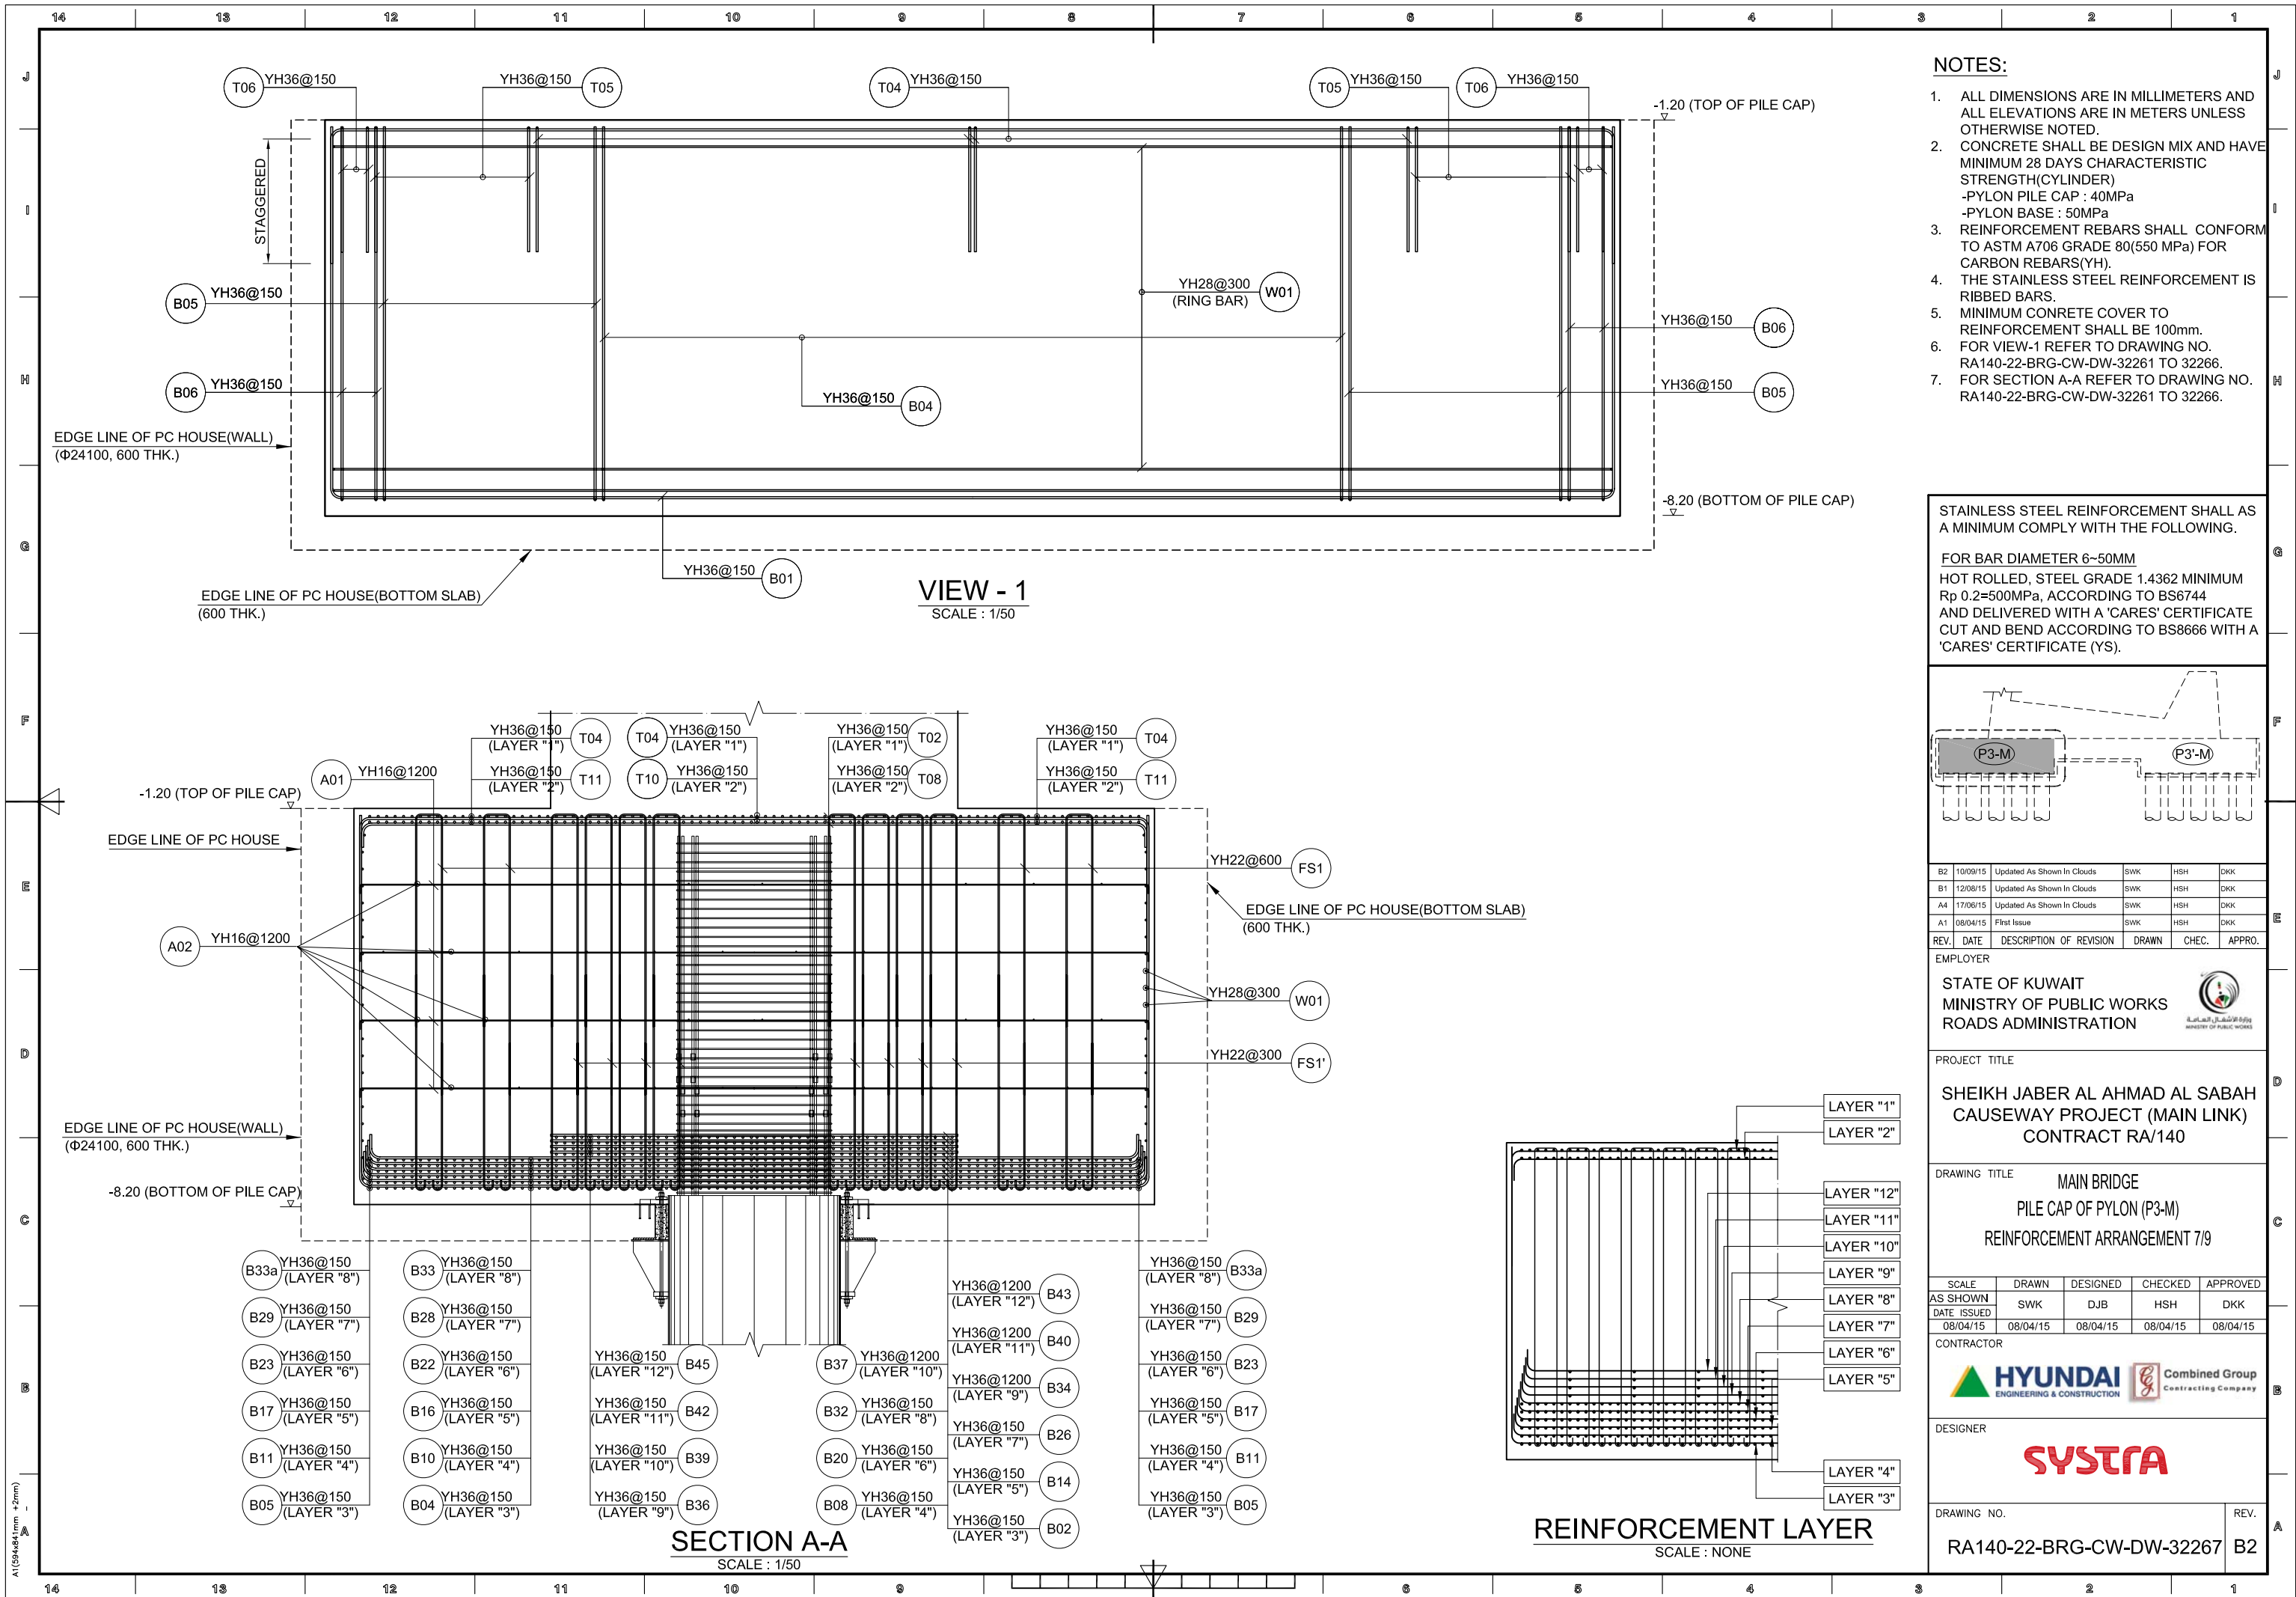

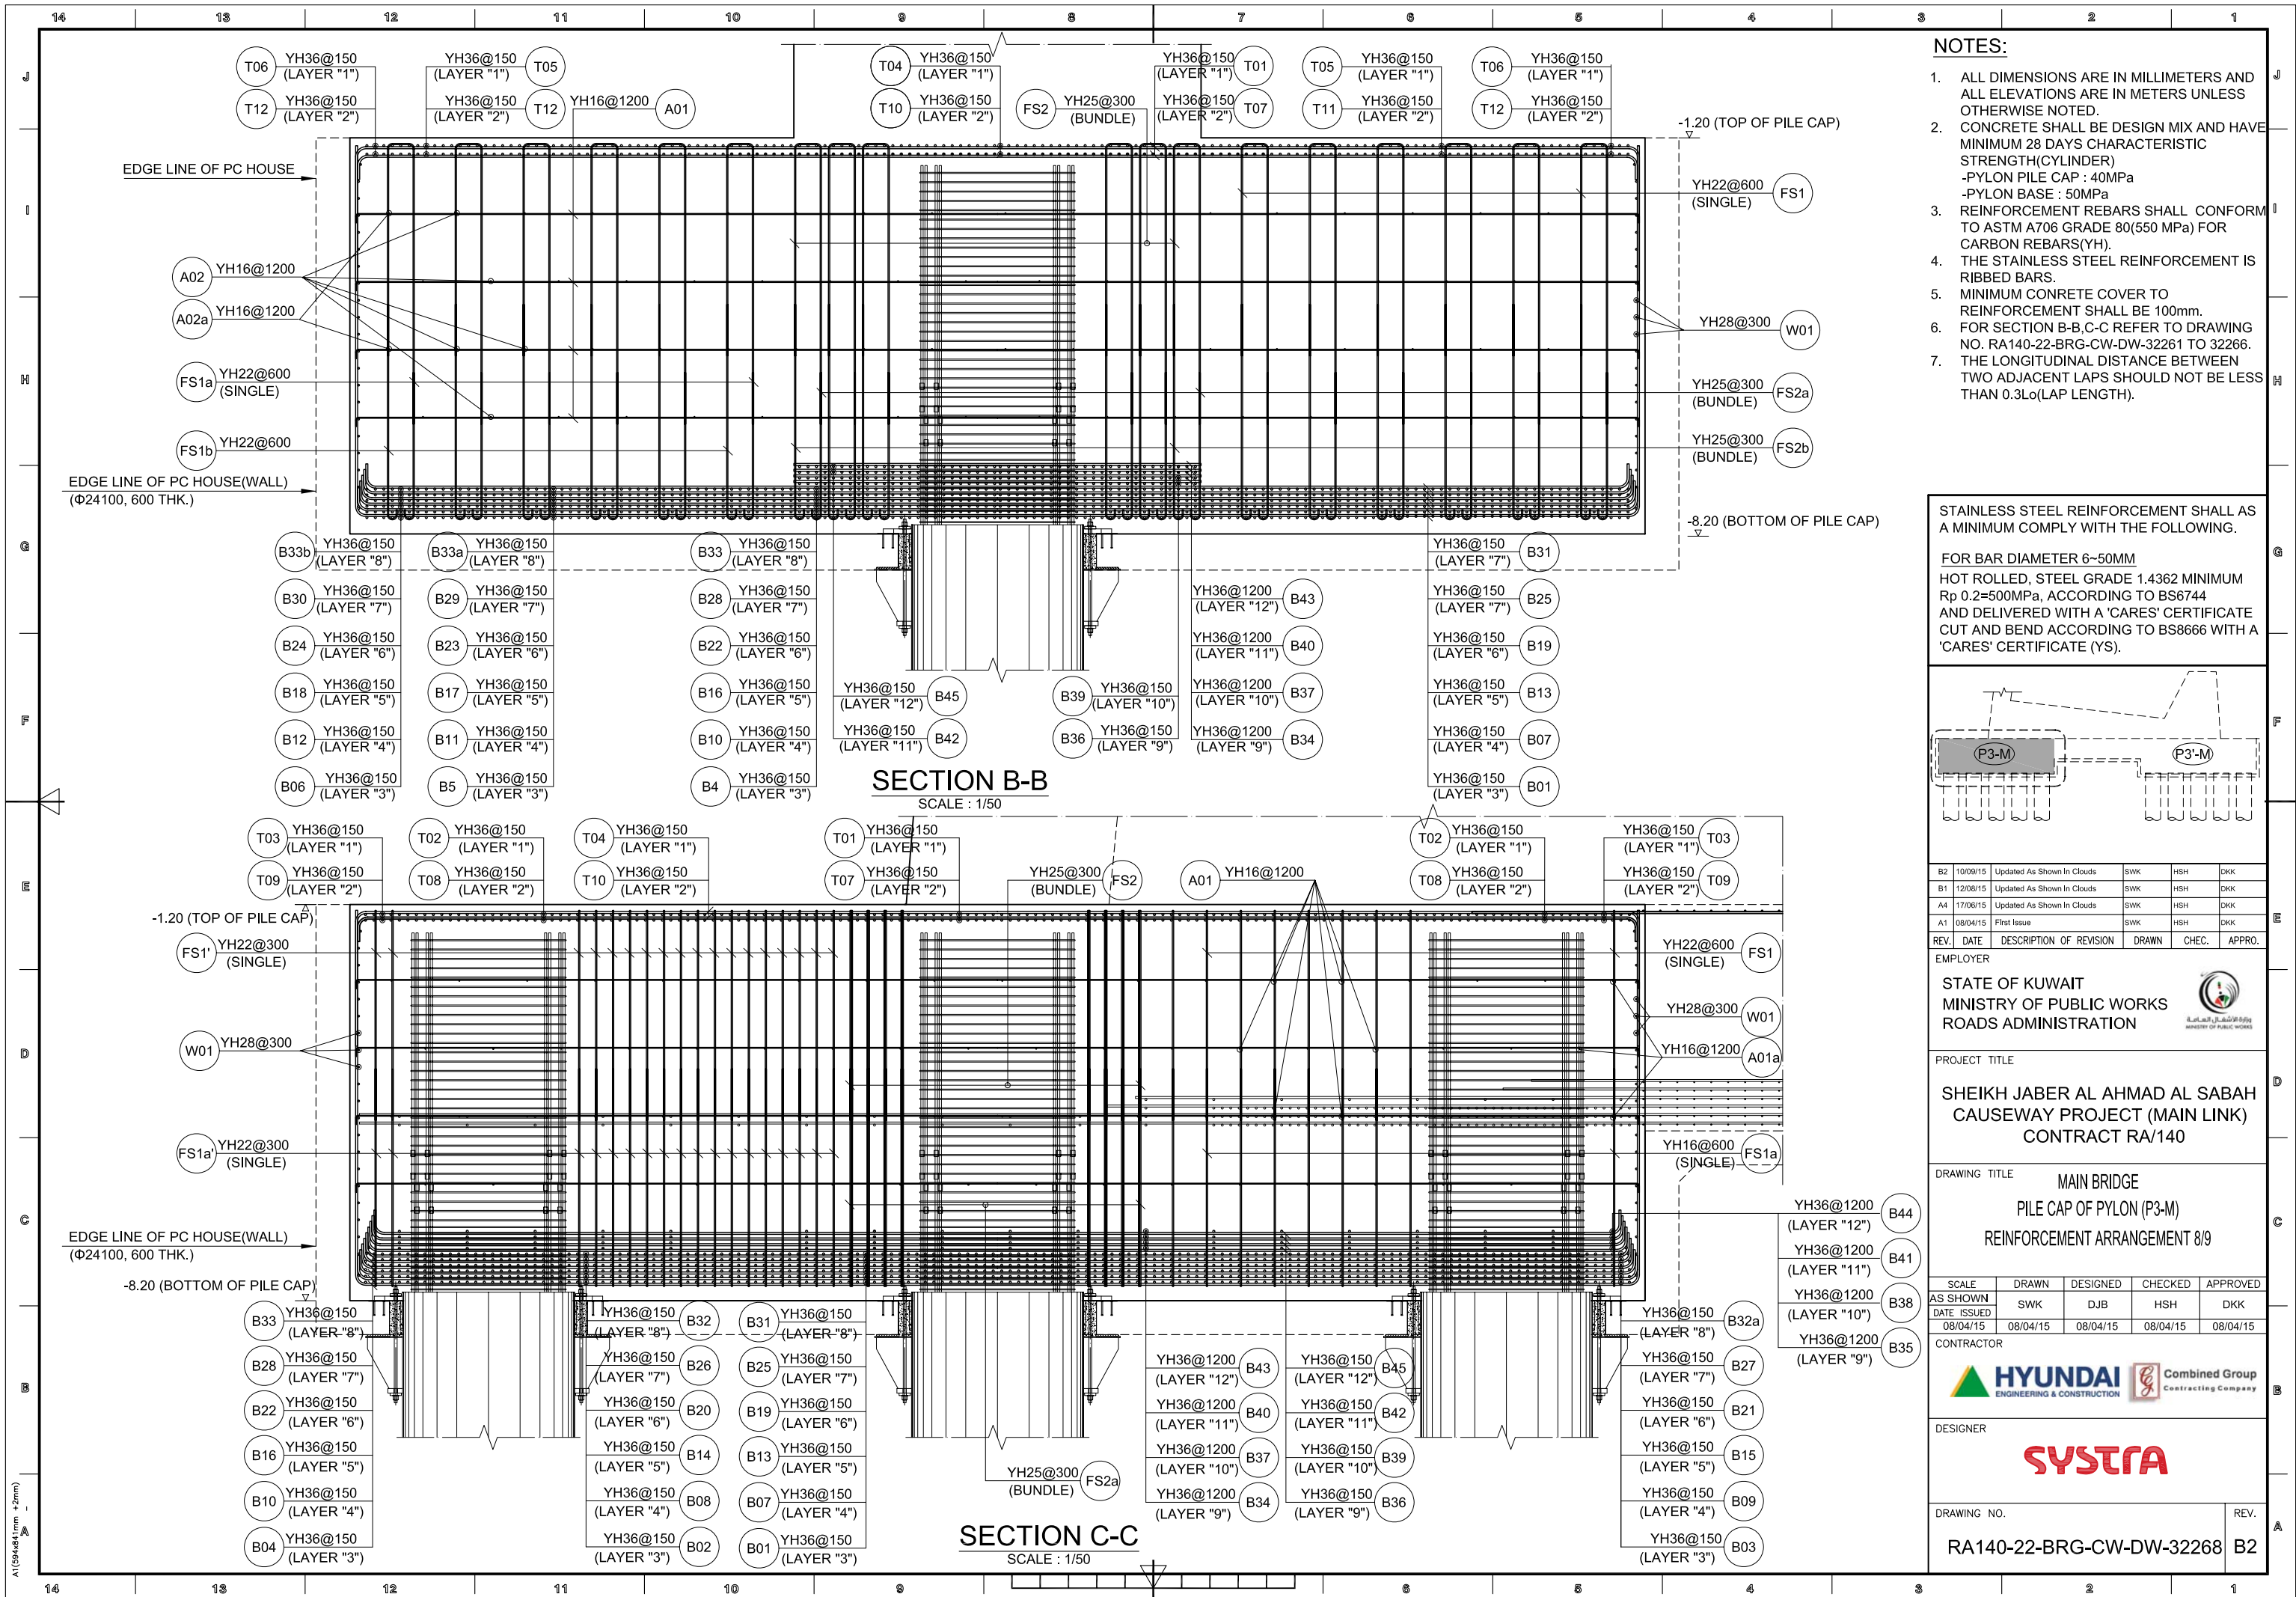


NOTES:

- ALL DIMENSIONS ARE IN MILLIMETERS AND ALL ELEVATIONS ARE IN METERS UNLESS OTHERWISE NOTED.
- CONCRETE SHALL BE DESIGN MIX AND HAVE MINIMUM 28 DAYS CHARACTERISTIC STRENGTH(CYLINDER)
-PYLON PILE CAP : 40MPa
-PYLON BASE : 50MPa
- REINFORCEMENT REBARS SHALL CONFORM TO ASTM A706 GRADE 80(550 MPa) FOR CARBON REBARS(YH).
- THE STAINLESS STEEL REINFORCEMENT IS RIBBED BARS.
- MINIMUM CONCRETE COVER TO REINFORCEMENT SHALL BE 100mm.
- FOR SECTION B-B,C-C REFER TO DRAWING NO. RA140-22-BRG-CW-DW-32261 TO 32266.
- THE LONGITUDINAL DISTANCE BETWEEN TWO ADJACENT LAPS SHOULD NOT BE LESS THAN 0.3Lo(LAP LENGTH).

STAINLESS STEEL REINFORCEMENT SHALL AS A MINIMUM COMPLY WITH THE FOLLOWING.

FOR BAR DIAMETER 6-50MM
HOT ROLLED, STEEL GRADE 1.4362 MINIMUM
Rp 0.2=500MPa, ACCORDING TO BS6744
AND DELIVERED WITH A 'CARES' CERTIFICATE
CUT AND BEND ACCORDING TO BS8666 WITH A
'CARES' CERTIFICATE (YS).

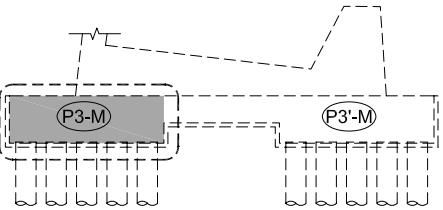

B2	10/09/15	Updated As Shown In Clouds	SWK	HSK	DKK
B1	12/08/15	Updated As Shown In Clouds	SWK	HSK	DKK
A4	17/06/15	Updated As Shown In Clouds	SWK	HSK	DKK
A1	08/04/15	First Issue	SWK	HSK	DKK
REV.	DATE	DESCRIPTION OF REVISION	DRAWN	CHEC.	APPRO.

EMPLOYER

STATE OF KUWAIT
MINISTRY OF PUBLIC WORKS
ROADS ADMINISTRATION



PROJECT TITLE

SHEIKH JABER AL AHMAD AL SABAH
CAUSEWAY PROJECT (MAIN LINK)
CONTRACT RA/140

DRAWING TITLE

MAIN BRIDGE
PILE CAP OF PYLON (P3-M)
REINFORCEMENT ARRANGEMENT 8/9

SCALE	DRAWN	DESIGNED	CHECKED	APPROVED
AS SHOWN	SWK	DJB	HSK	DKK
DATE ISSUED	08/04/15	08/04/15	08/04/15	08/04/15

CONTRACTOR



DESIGNER


SYSTRA


DRAWING NO.


RA140-22-BRG-CW-DW-32268


REV.

B2

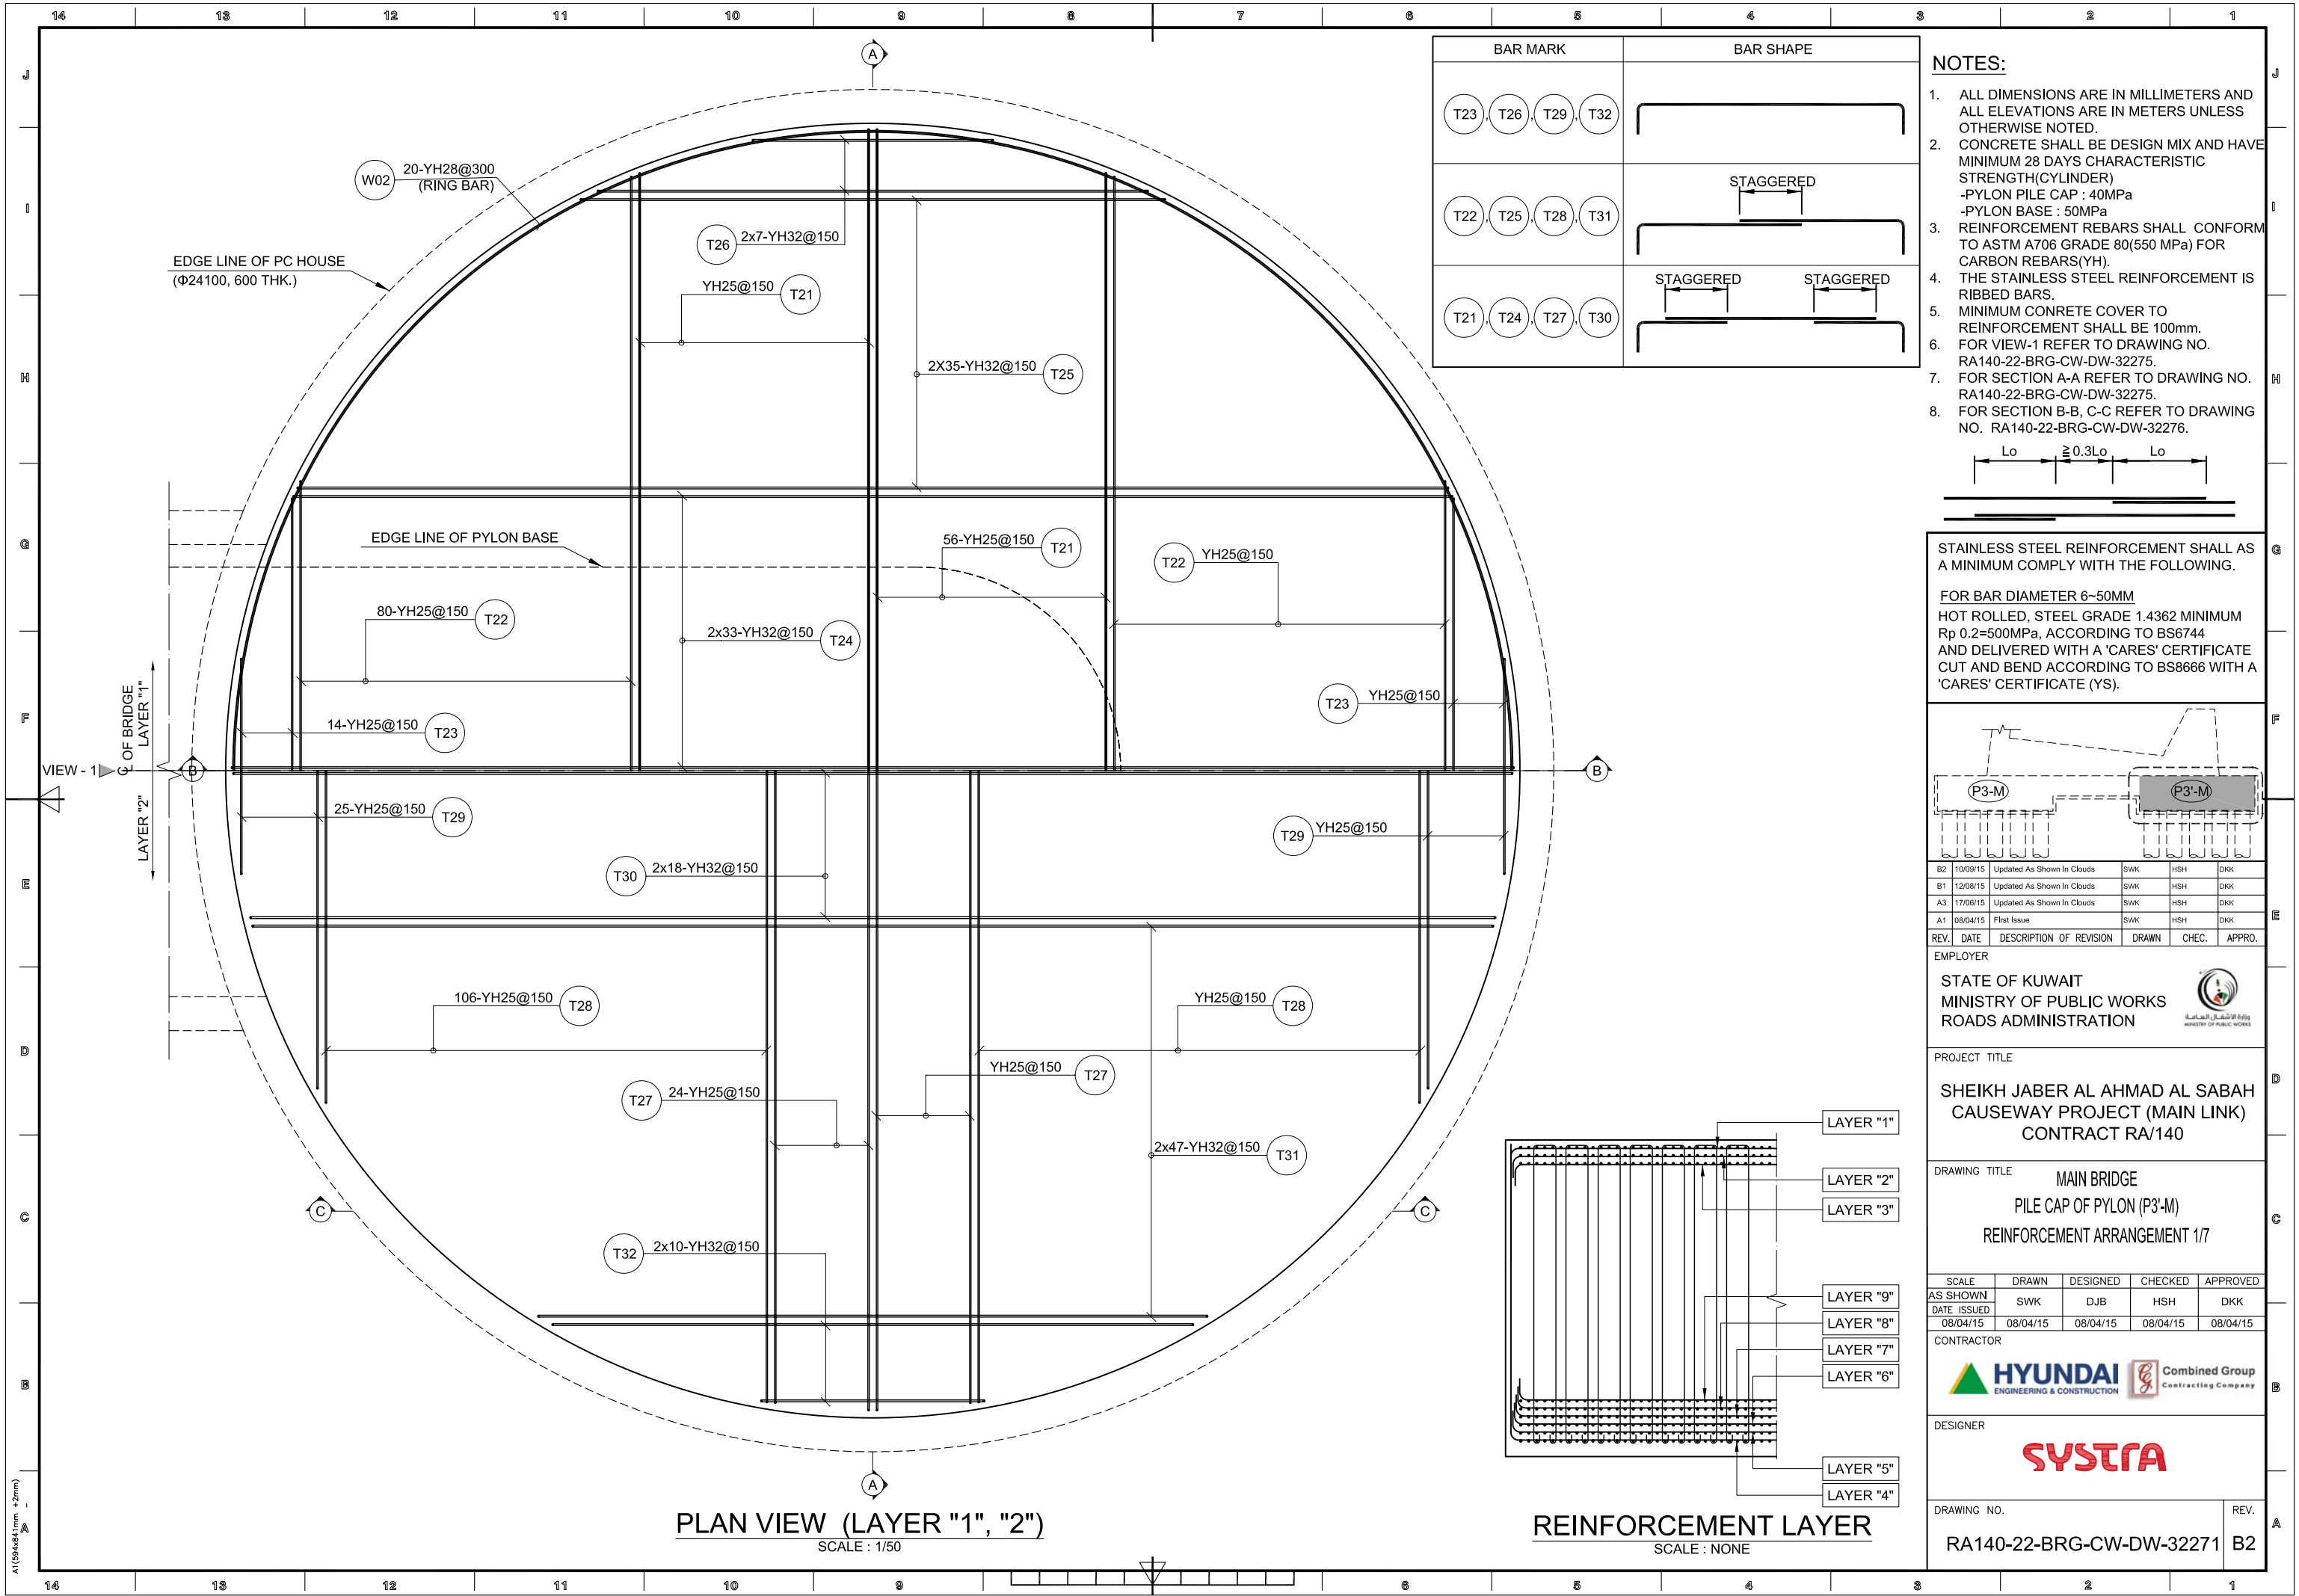

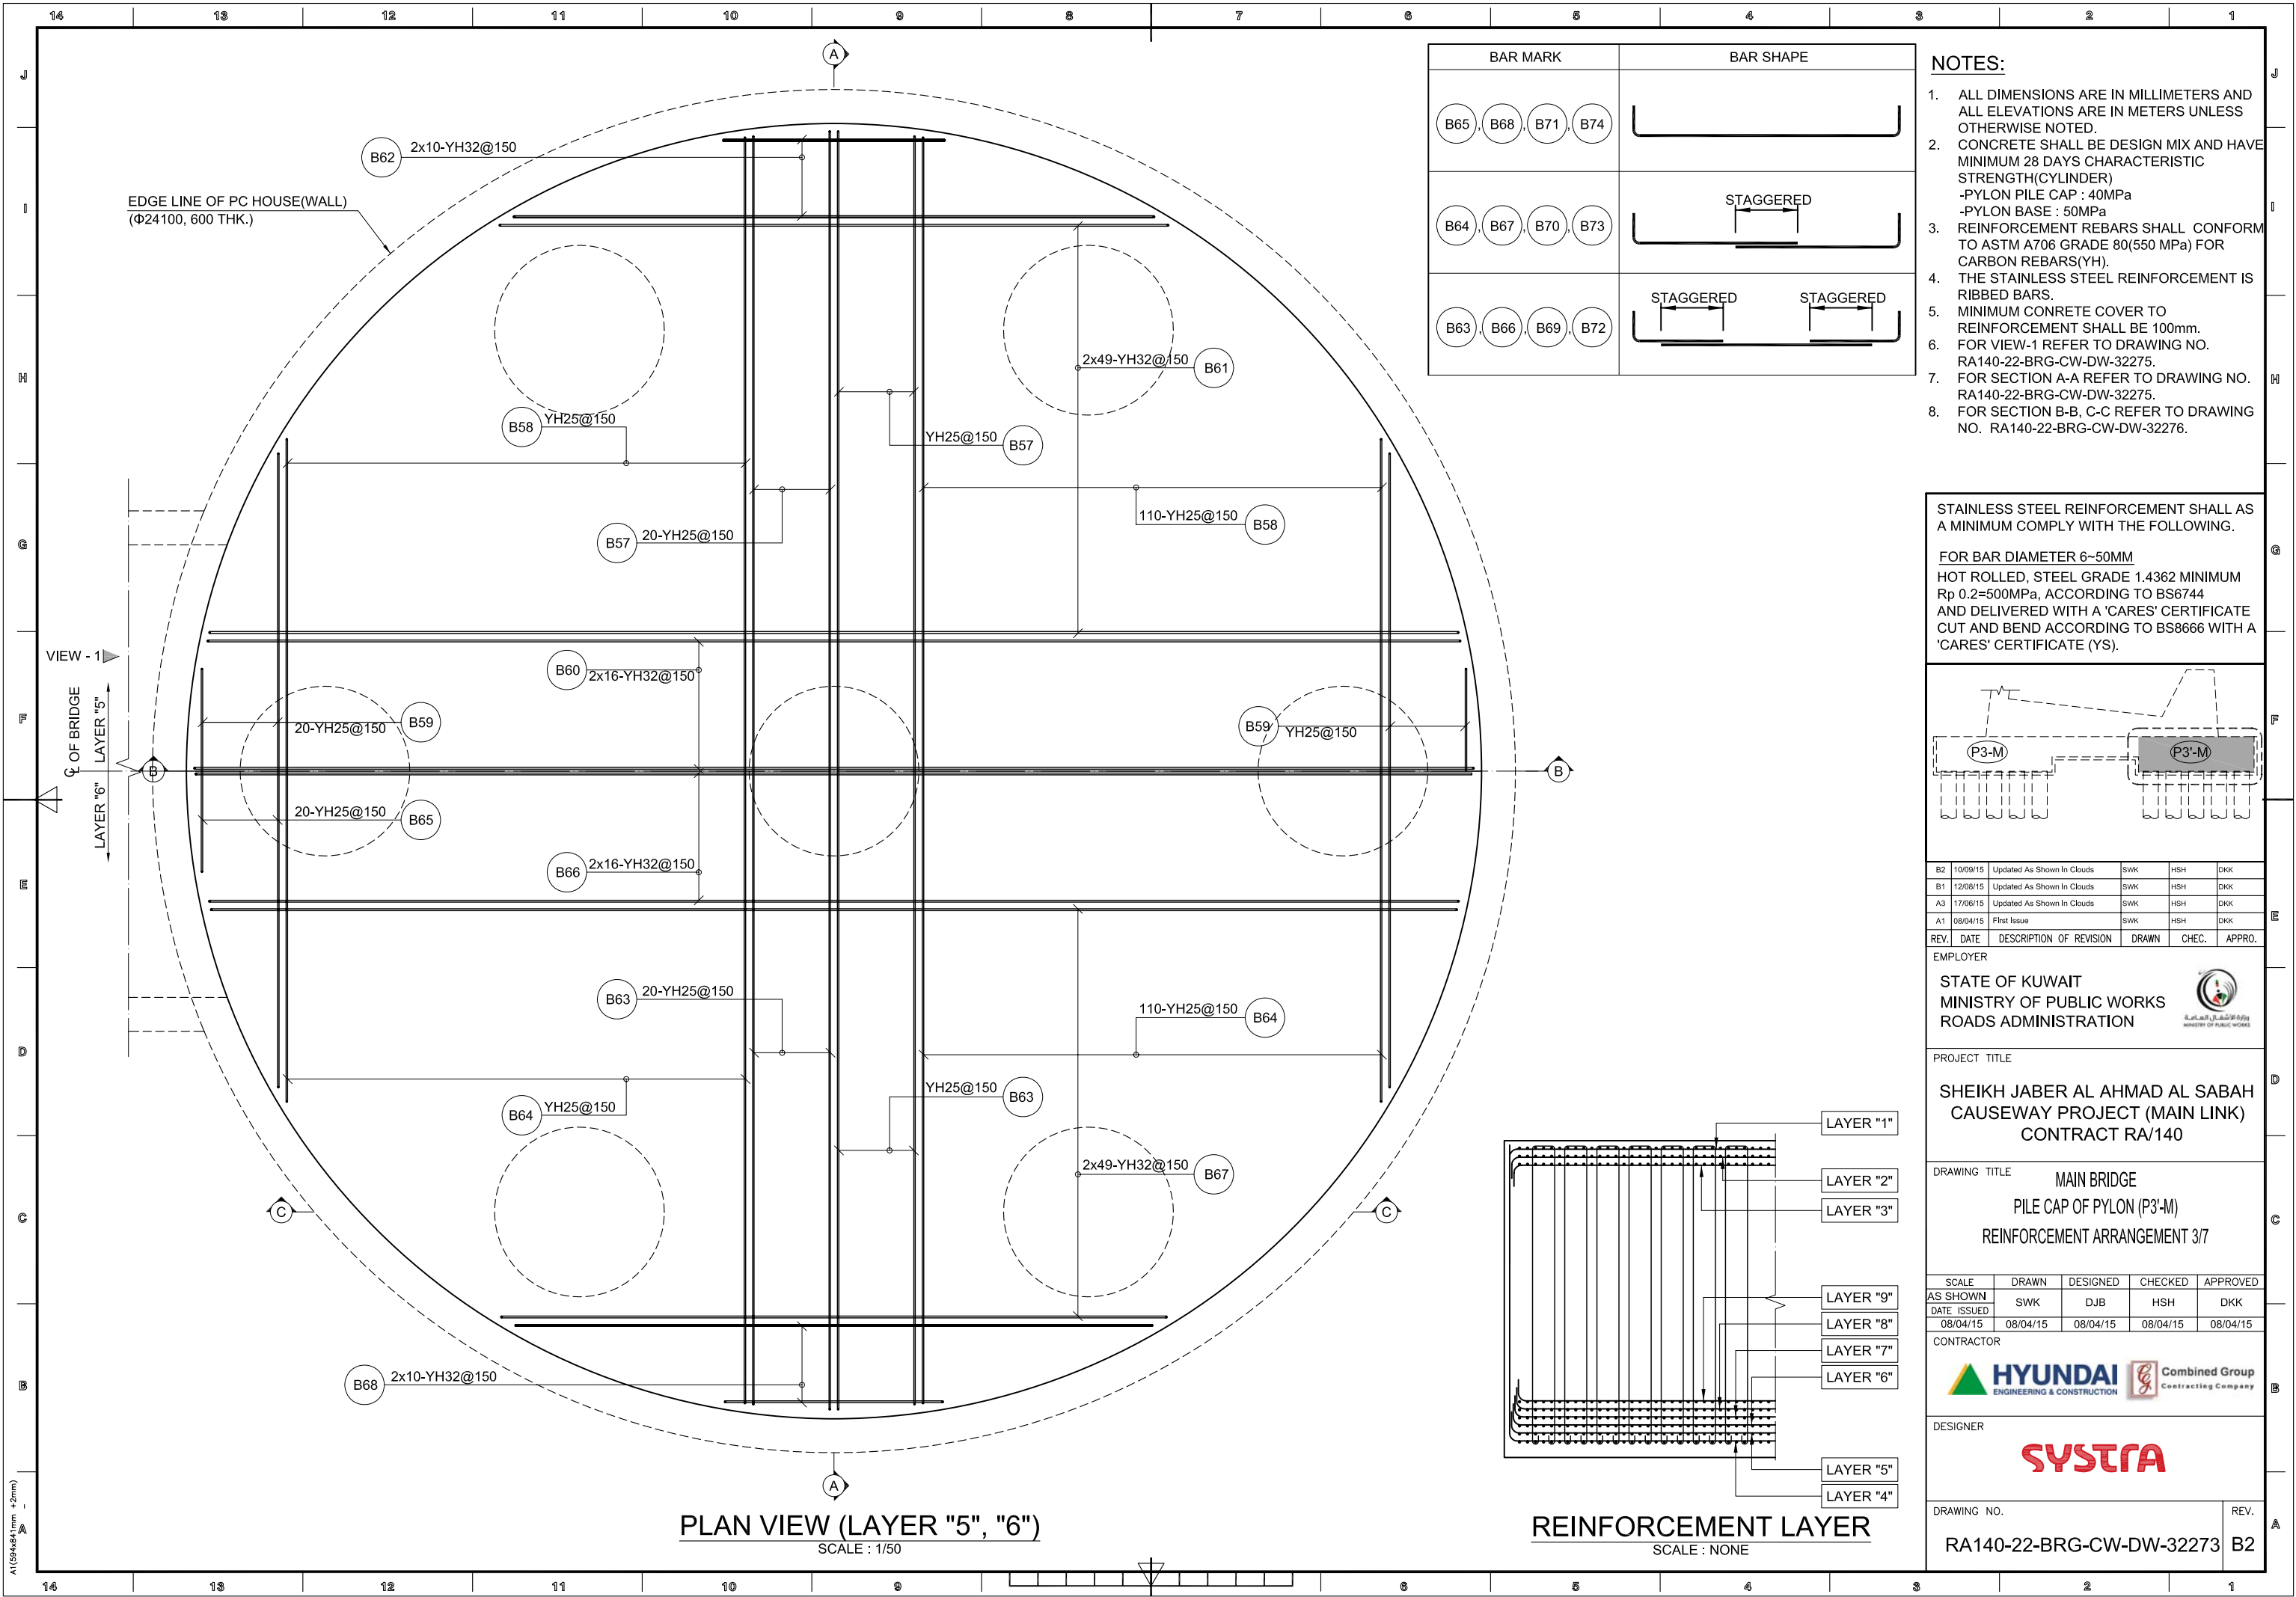

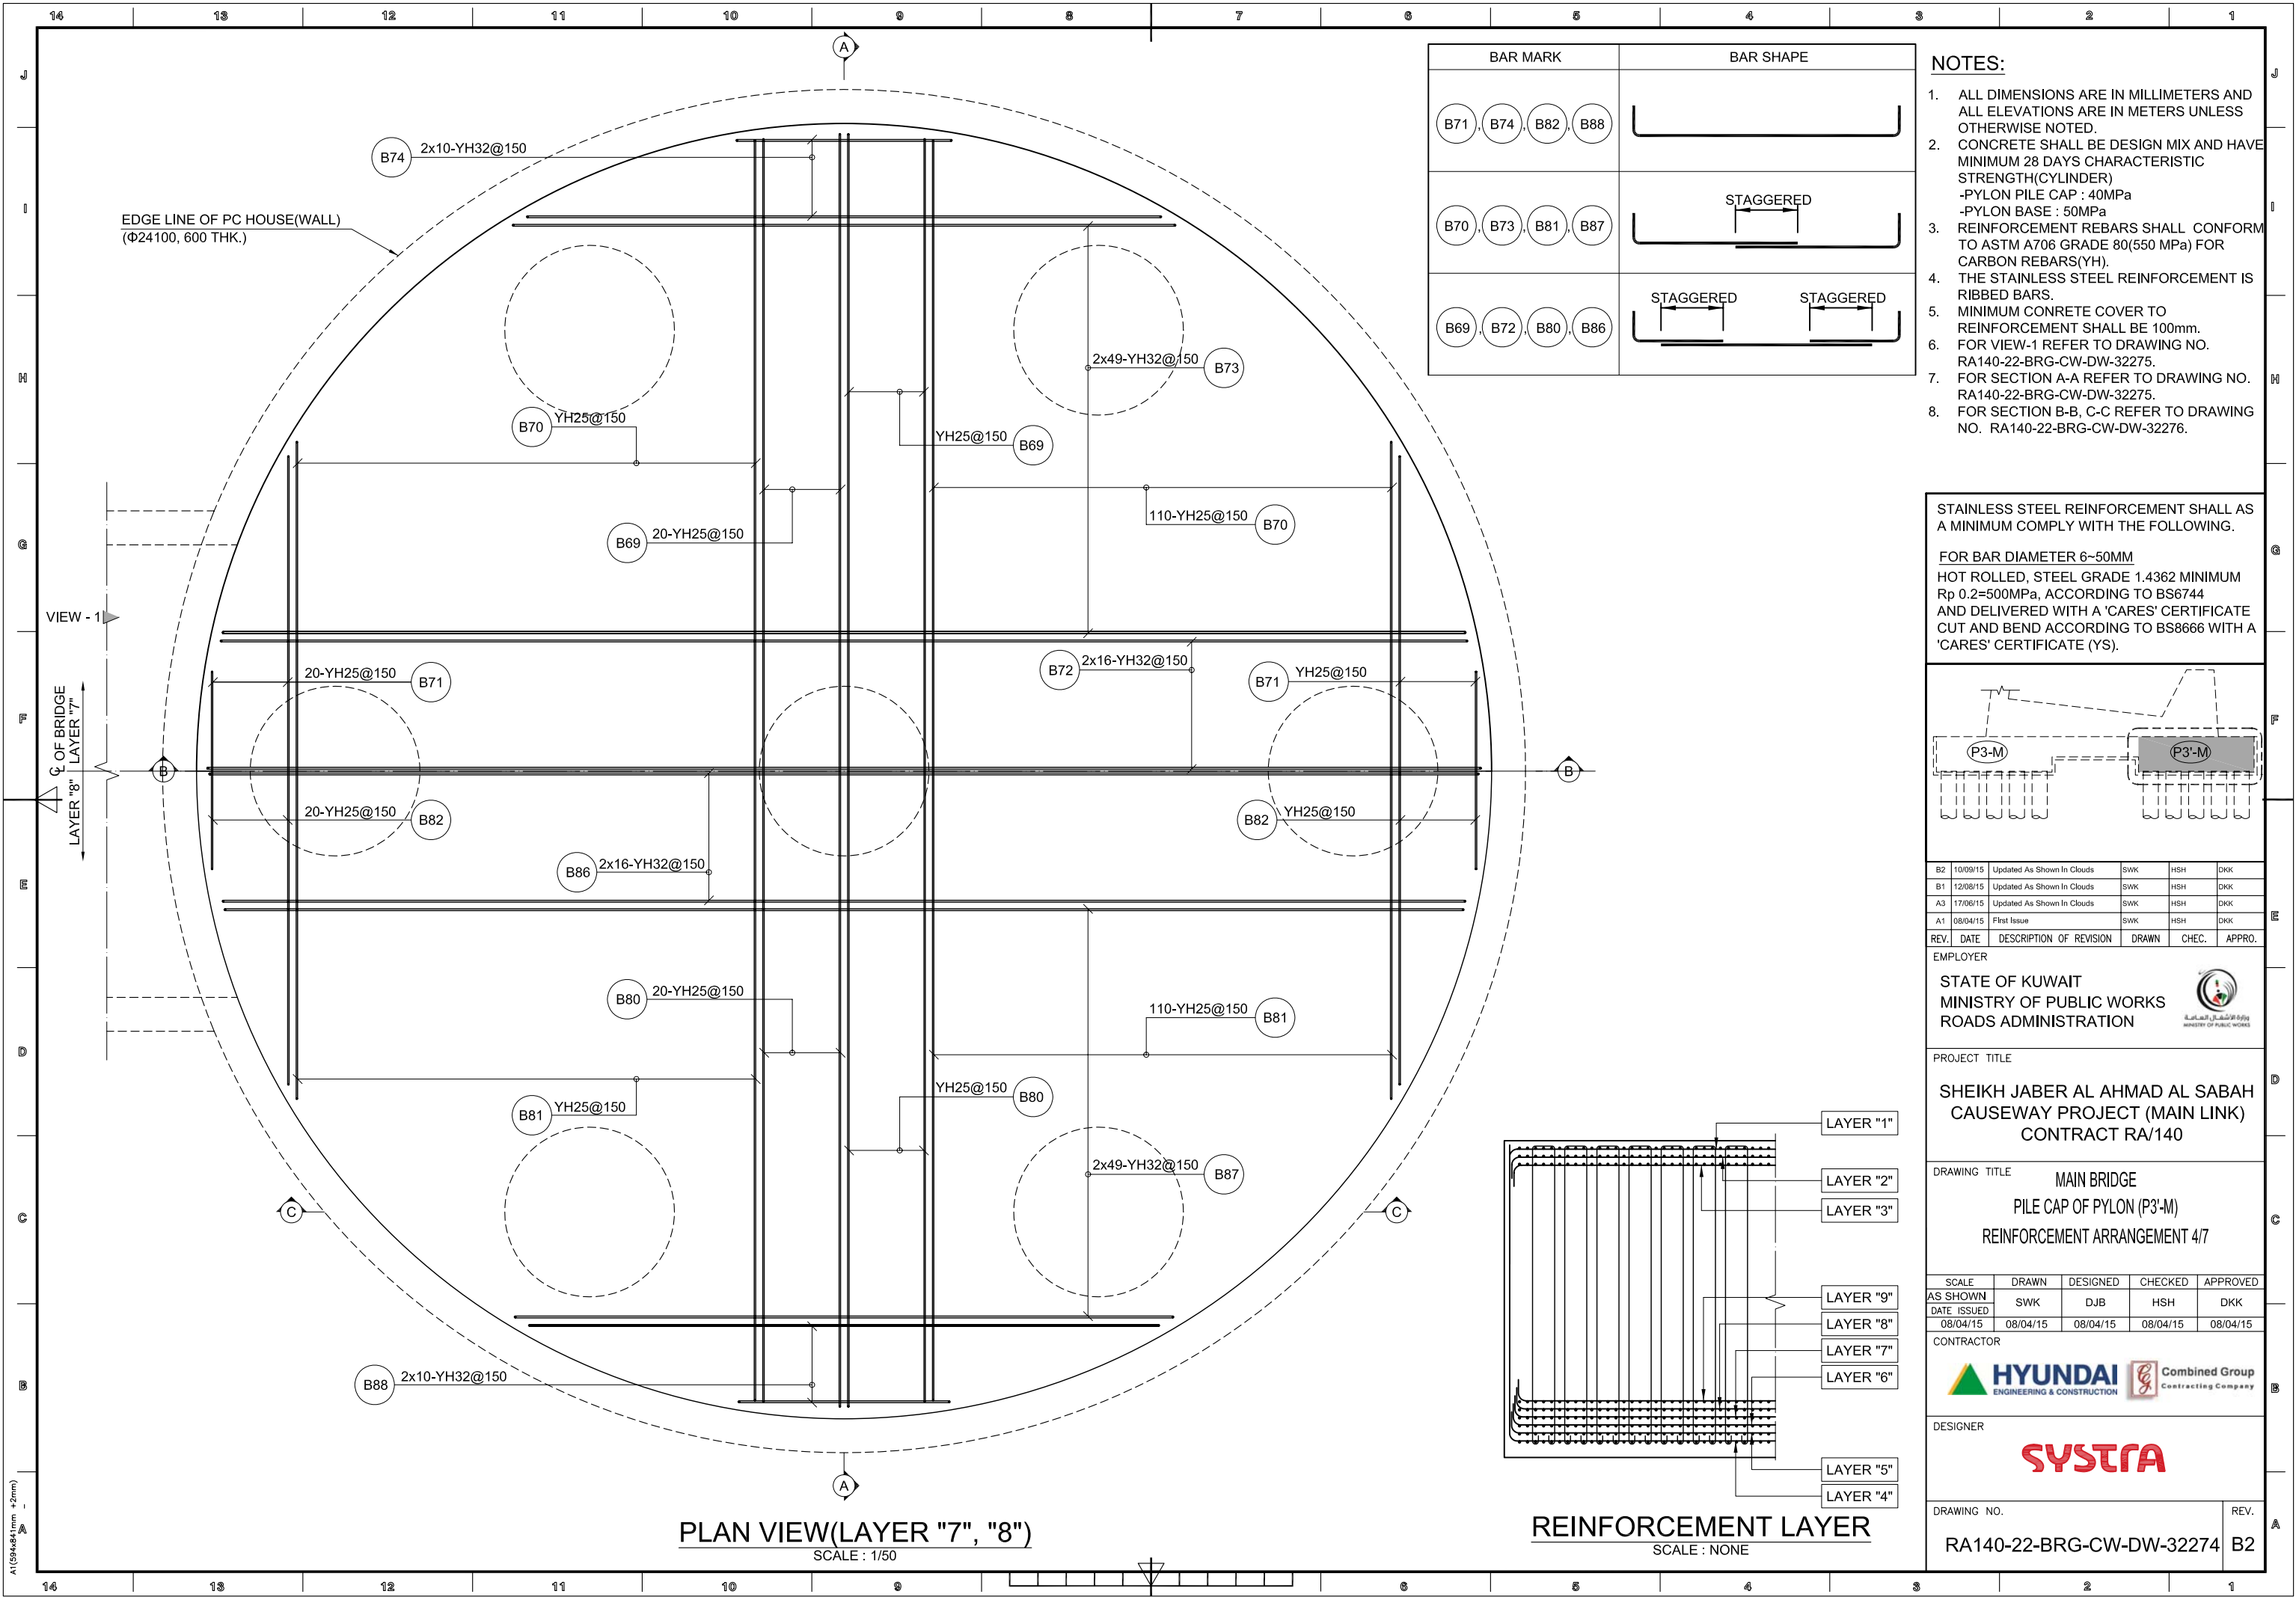


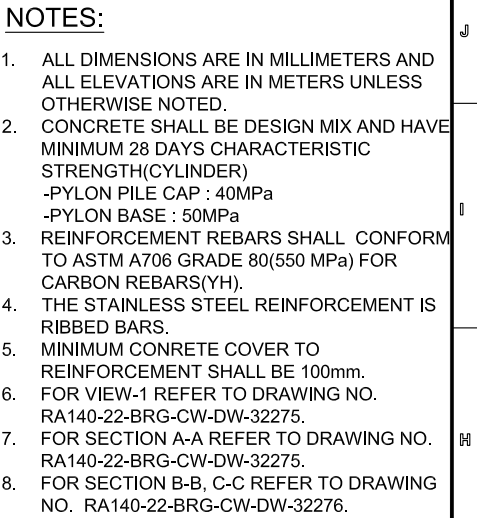

STAINLESS STEEL REINFORCEMENT SHALL AS
A MINIMUM COMPLY WITH THE FOLLOWING.

FOR BAR DIAMETER 6~50MM

HOT ROLLED, STEEL GRADE 1.4362 MINIMUM
Rp 0.2=500MPa, ACCORDING TO BS6744
AND DELIVERED WITH A 'CARES' CERTIFICATE
CUT AND BEND ACCORDING TO BS8666 WITH A
'CARES' CERTIFICATE (YS).

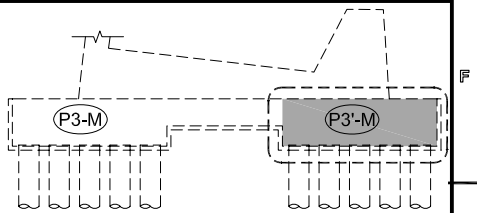

B1	10/09/15	First Issue	SWK	HSB	DKK
REV.	DATE	DESCRIPTION OF REVISION	DRAWN	CHEC.	APPRO.

EMPLOYER

STATE OF KUWAIT
MINISTRY OF PUBLIC WORKS
ROADS ADMINISTRATION


وزارة الأشغال العامة
MINISTRY OF PUBLIC WORKS

PROJECT TITLE	
SHEIKH JABER AL AHMAD AL SABAH CAUSEWAY PROJECT (MAIN LINK) CONTRACT RA/140	D

DRAWING TITLE	MAIN BRIDGE
	PILE CAP OF PYLON (P3'-M)
	REINFORCEMENT ARRANGEMENT 5/7

SCALE	DRAWN	DESIGNED	CHECKED	APPROVED
AS SHOWN	SWK	DJB	HSH	DKK
DATE ISSUED				
10/09/15	10/09/15	10/09/15	10/09/15	10/09/15

CONTRACTOR

 **HYUNDAI**
ENGINEERING & CONSTRUCTION


 **Combined Group**
Contracting Company




DESIGNER

SYSTRA


DRAWING NO.	REV.
RA140-22-BRG-CW-DW-32279	B1

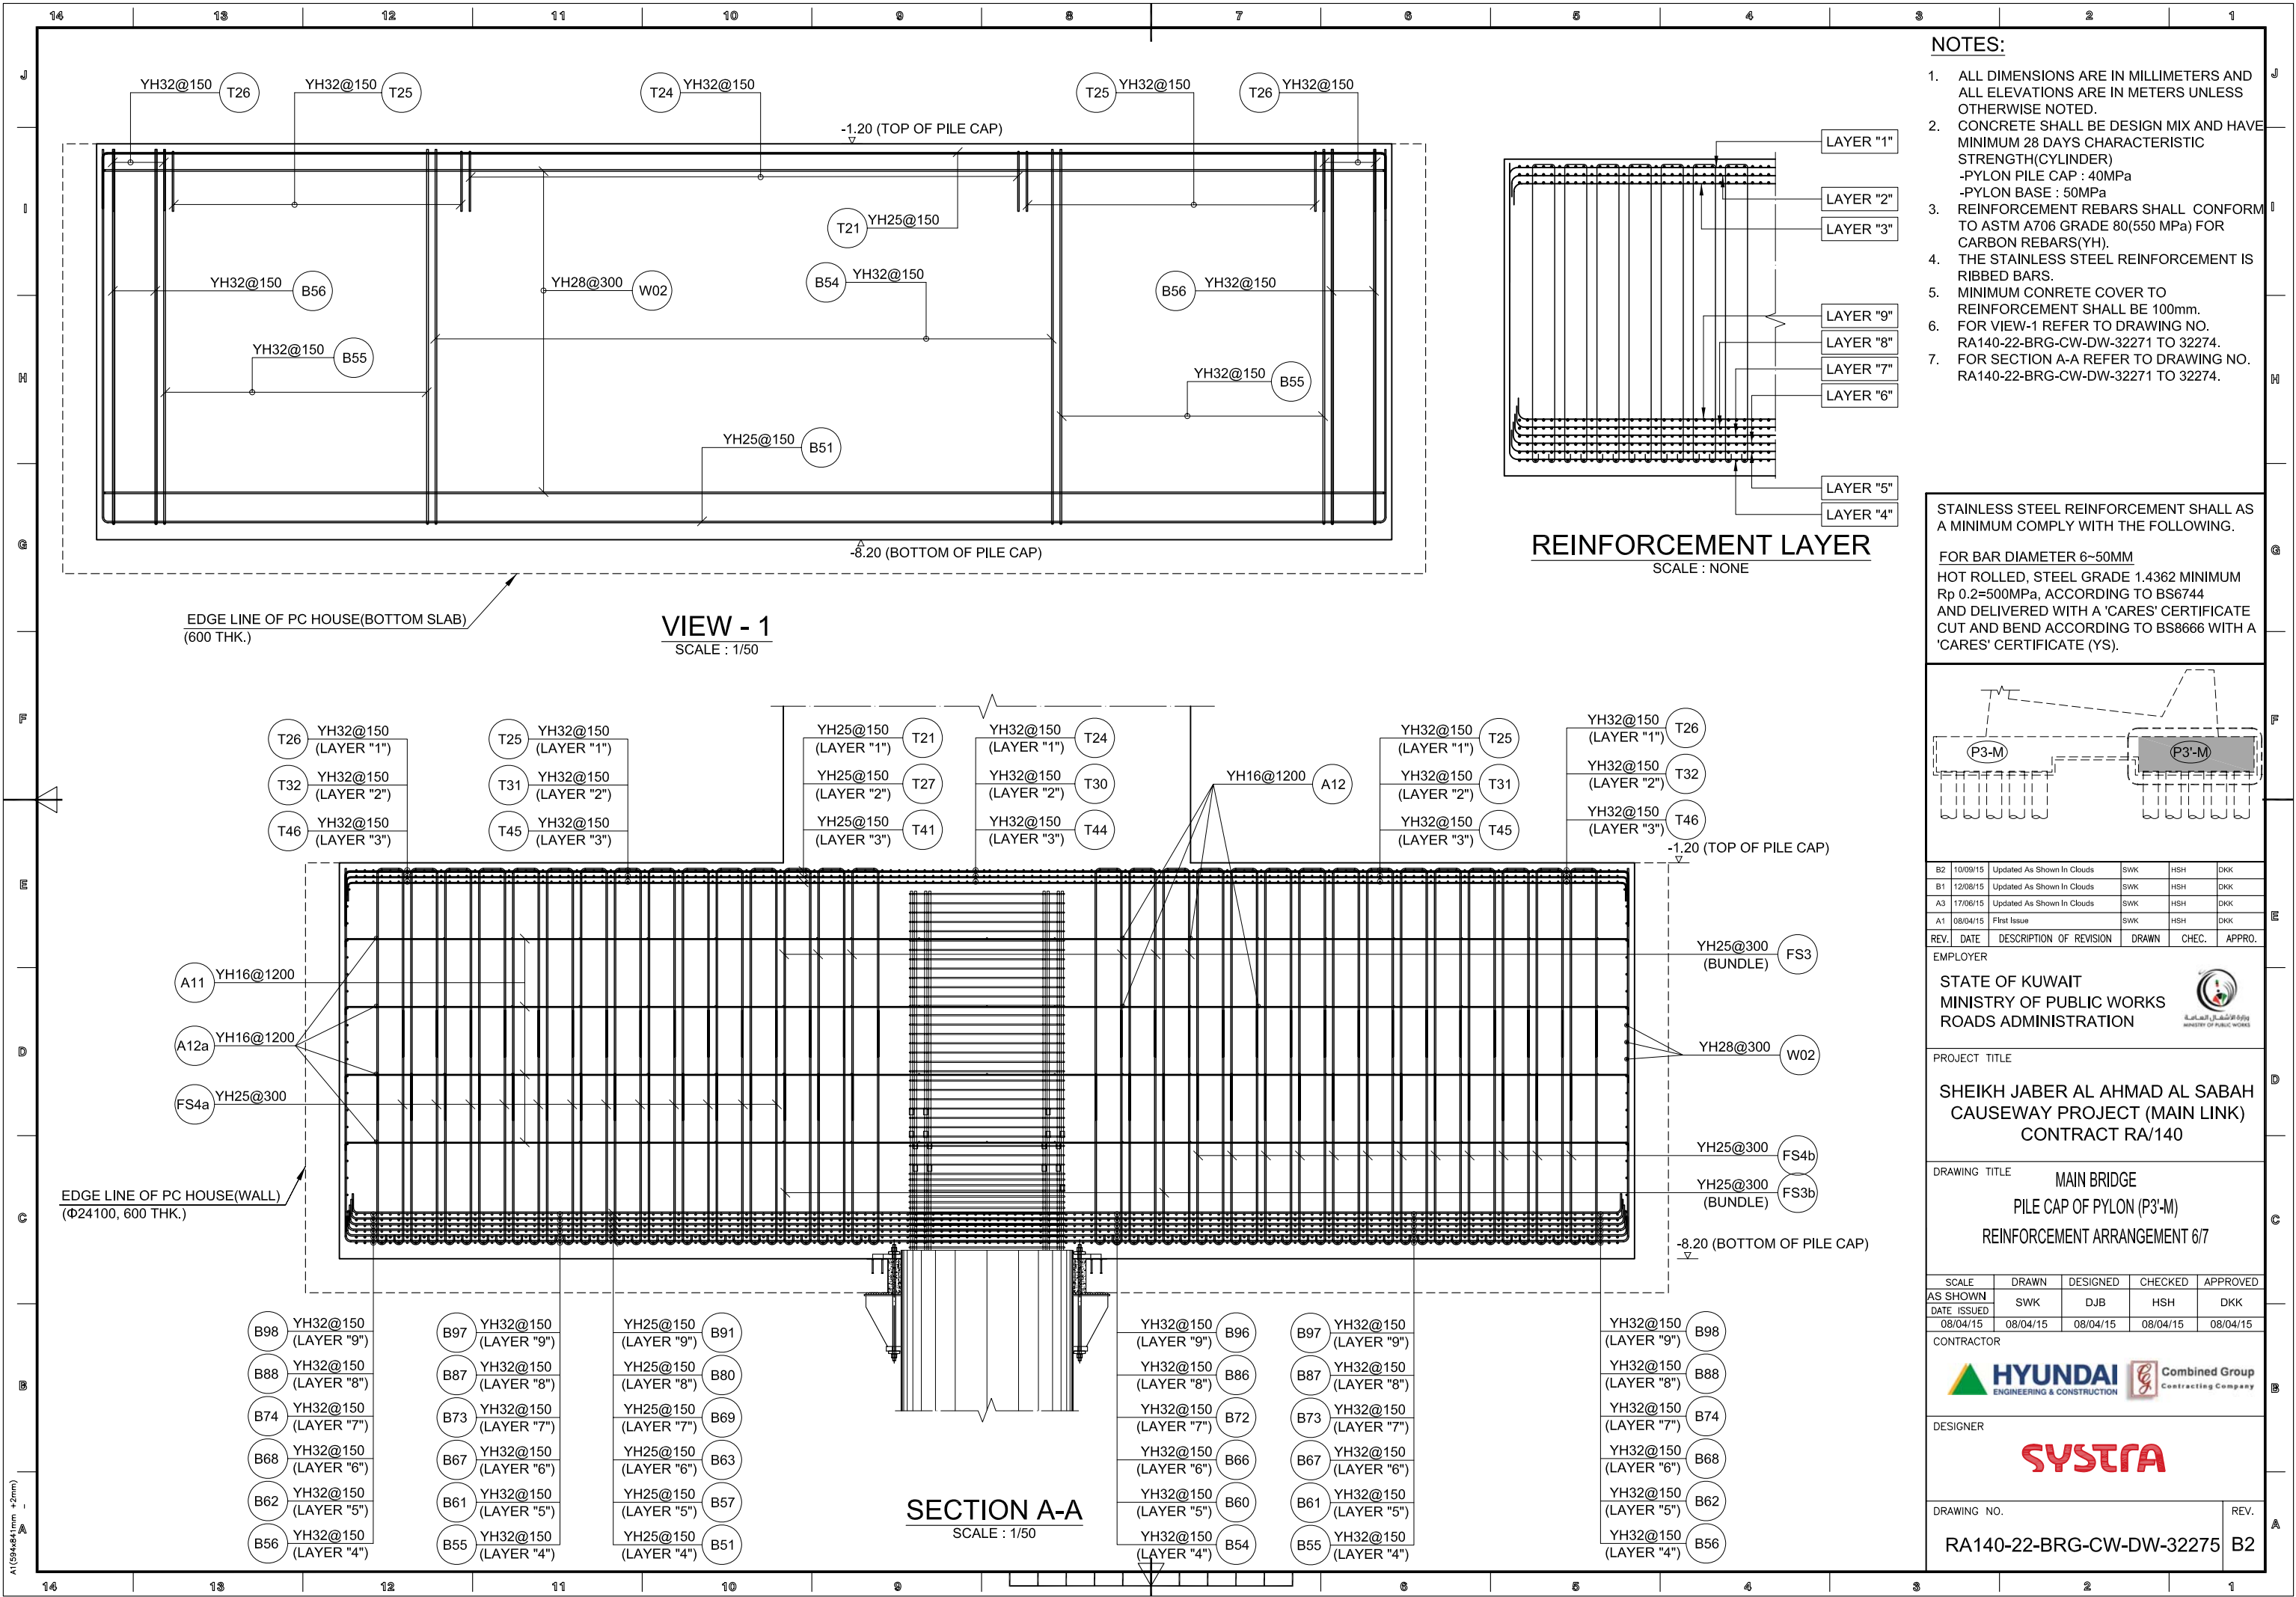

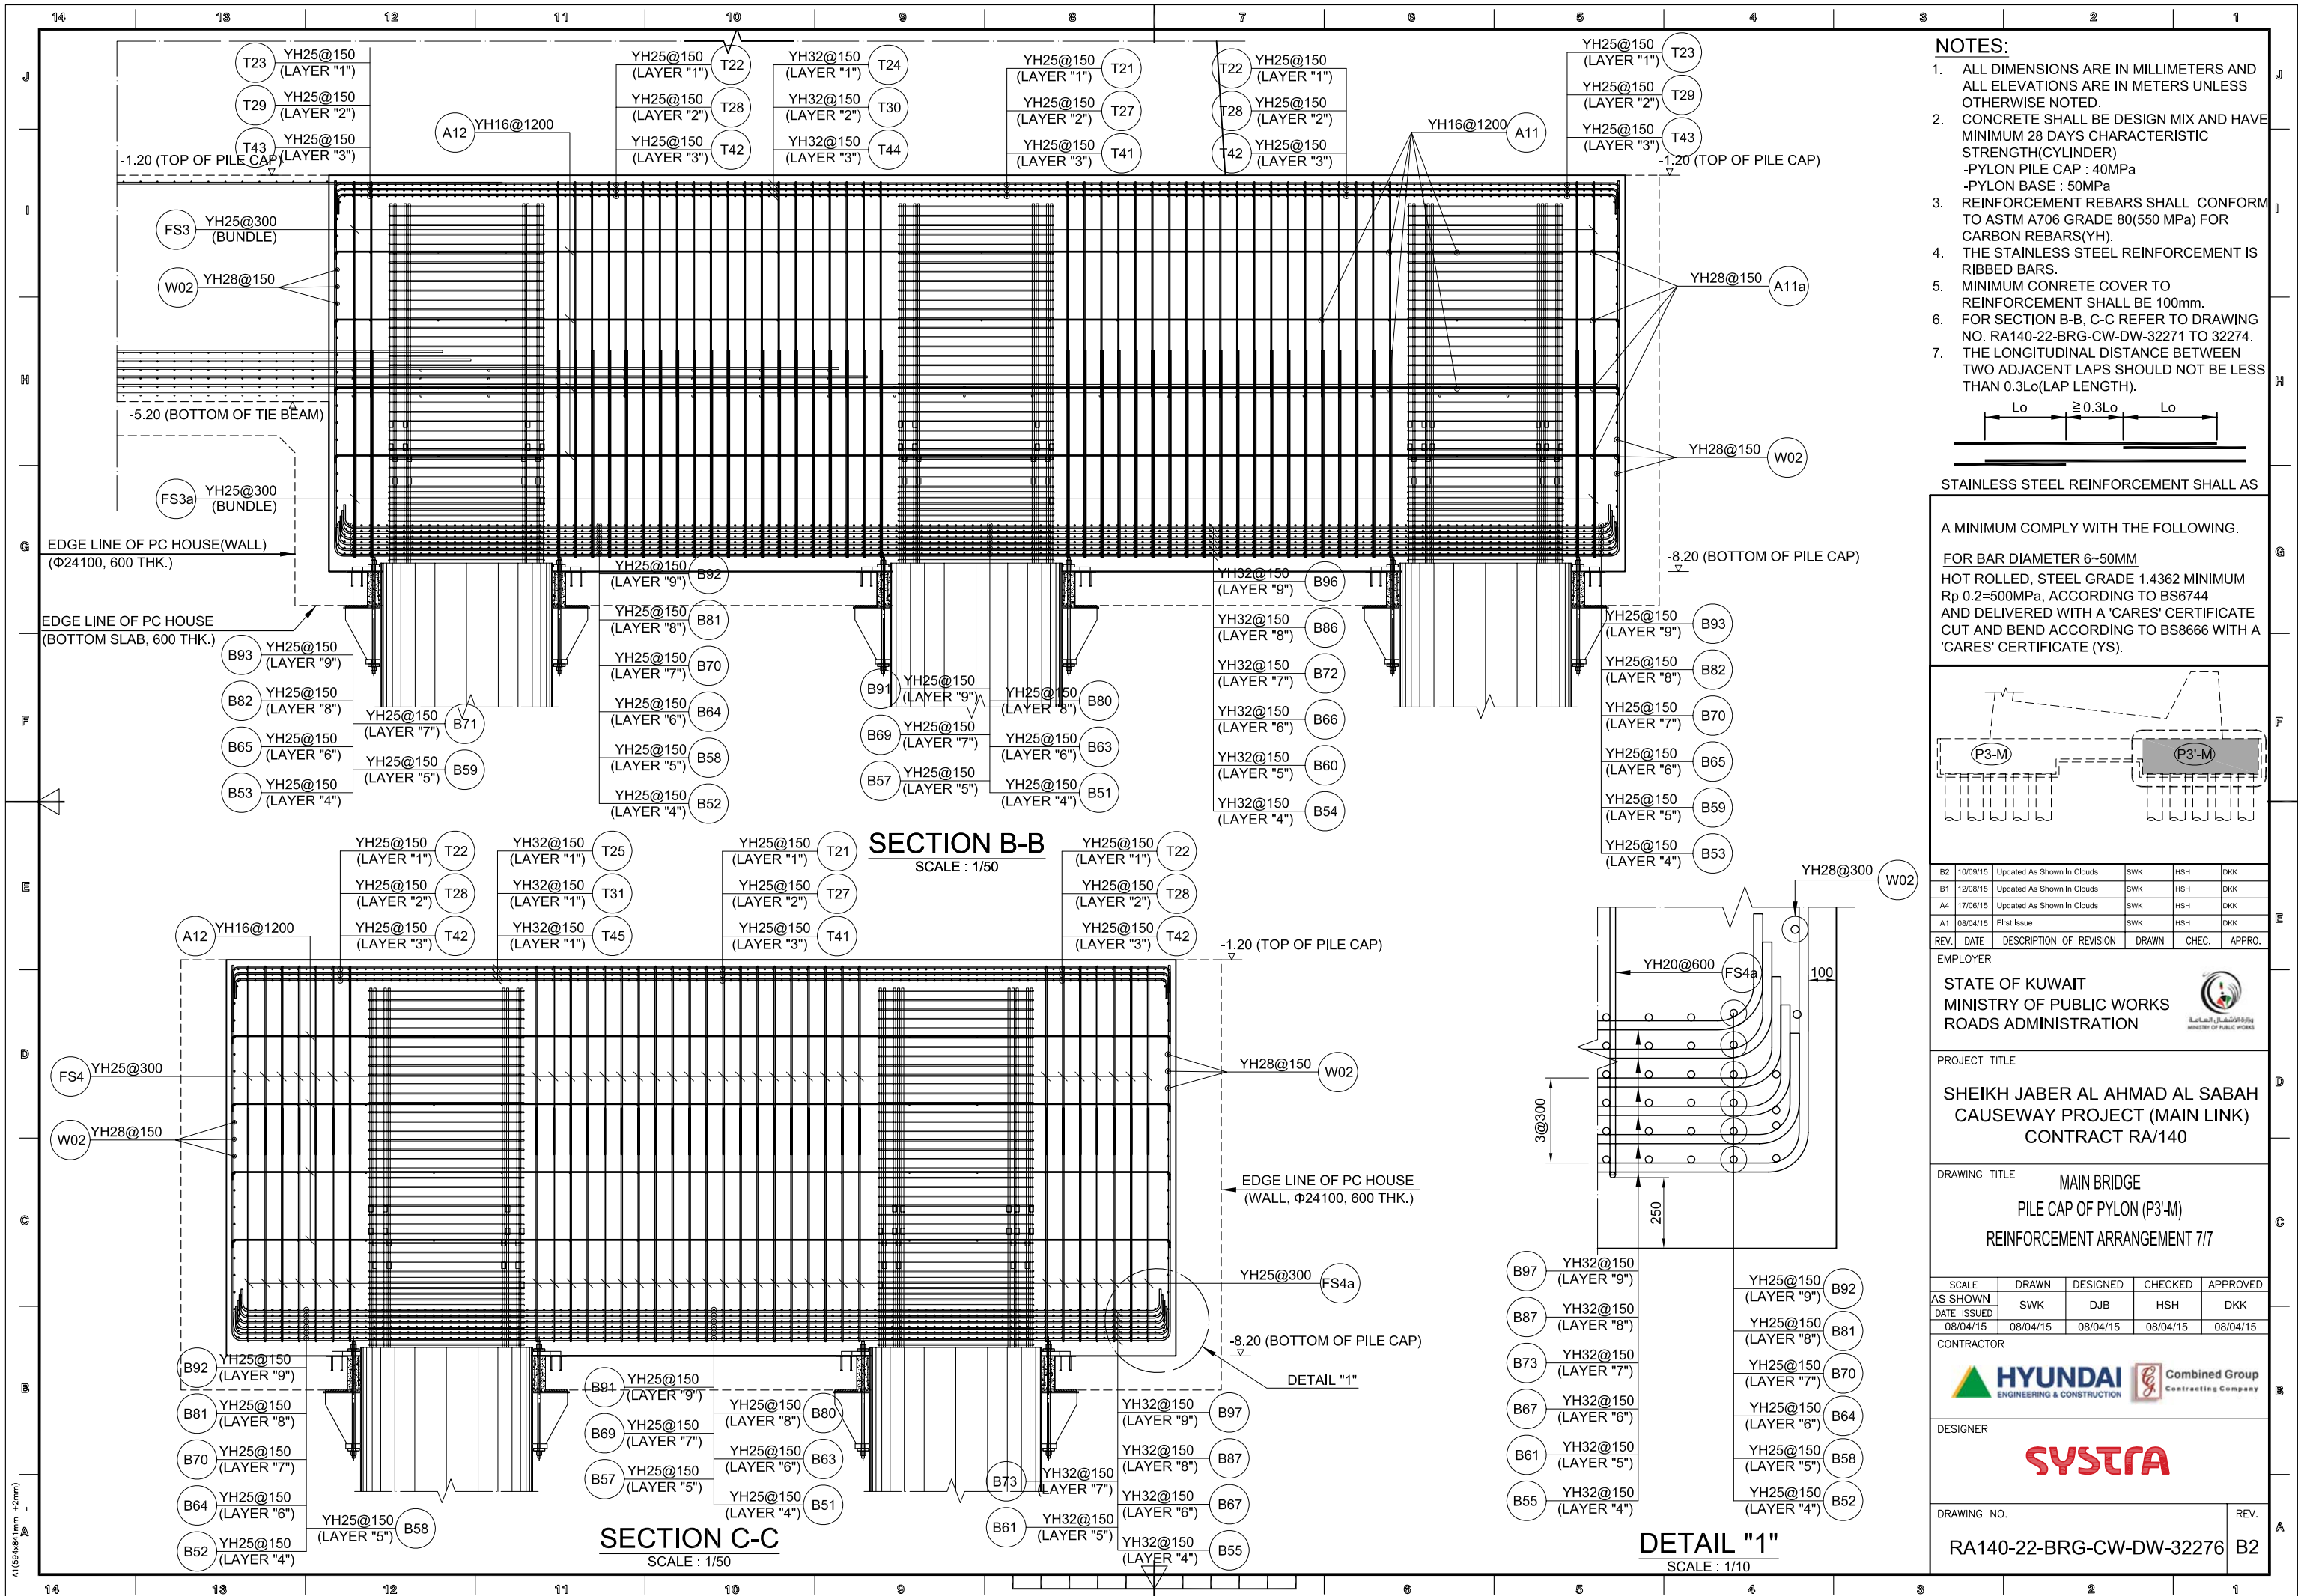

NOTES:


- ALL DIMENSIONS ARE IN MILLIMETERS AND ALL ELEVATIONS ARE IN METERS UNLESS OTHERWISE NOTED.
- CONCRETE SHALL BE DESIGN MIX AND HAVE MINIMUM 28 DAYS CHARACTERISTIC STRENGTH(CYLINDER)
-PYLON PILE CAP : 40MPa
-PYLON BASE : 50MPa
- REINFORCEMENT REBARS SHALL CONFORM TO ASTM A706 GRADE 80(550 MPa) FOR CARBON REBARS(YH).
- THE STAINLESS STEEL REINFORCEMENT IS RIBBED BARS.
- MINIMUM CONCRETE COVER TO REINFORCEMENT SHALL BE 100mm.
- FOR SECTION B-B, C-C REFER TO DRAWING NO. RA140-22-BRG-CW-DW-32271 TO 32274.
- THE LONGITUDINAL DISTANCE BETWEEN TWO ADJACENT LAPS SHOULD NOT BE LESS THAN 0.3Lo(LAP LENGTH).

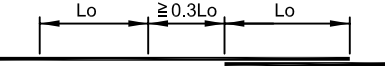

STAINLESS STEEL REINFORCEMENT SHALL AS

A MINIMUM COMPLY WITH THE FOLLOWING.

FOR BAR DIAMETER 6-50MM
HOT ROLLED, STEEL GRADE 1.4362 MINIMUM
Rp 0.2=500MPa, ACCORDING TO BS6744
AND DELIVERED WITH A 'CARES' CERTIFICATE
CUT AND BEND ACCORDING TO BS8666 WITH A
'CARES' CERTIFICATE (YS).

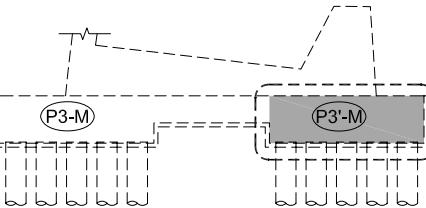

B2	10/09/15	Updated As Shown In Clouds	SWK	HSK	DKK
B1	12/08/15	Updated As Shown In Clouds	SWK	HSK	DKK
A4	17/06/15	Updated As Shown In Clouds	SWK	HSK	DKK
A1	08/04/15	First Issue	SWK	HSK	DKK
REV.	DATE	DESCRIPTION OF REVISION	DRAWN	CHEC.	APPRO.

EMPLOYER

STATE OF KUWAIT
MINISTRY OF PUBLIC WORKS
ROADS ADMINISTRATION



PROJECT TITLE

SHEIKH JABER AL AHMAD AL SABAH
CAUSEWAY PROJECT (MAIN LINK)
CONTRACT RA/140

DRAWING TITLE

MAIN BRIDGE
PILE CAP OF PYLON (P3-M)
REINFORCEMENT ARRANGEMENT 7/7

SCALE	DRAWN	DESIGNED	CHECKED	APPROVED
AS SHOWN	SWK	DJB	HSK	DKK
DATE ISSUED	08/04/15	08/04/15	08/04/15	08/04/15

CONTRACTOR



DESIGNER





SYSTRA


DRAWING NO.

RA140-22-BRG-CW-DW-32276


REV.

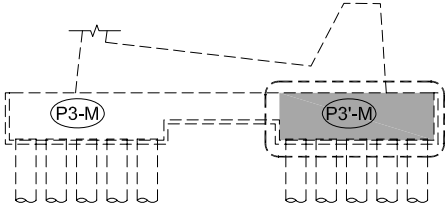B2


14	13	12	11	10	9	8	7	6	5	4	3	2	1
													NOTES:
													1. ALL DIMENSIONS ARE IN MILLIMETERS AND ALL ELEVATIONS ARE IN METERS UNLESS OTHERWISE NOTED.
													2. CONCRETE SHALL BE DESIGN MIX AND HAVE MINIMUM 28 DAYS CHARACTERISTIC STRENGTH(CYLINDER)
													-PYLON PILE CAP : 40MPa
													-PYLON BASE : 50MPa
													3. REINFORCEMENT REBARS SHALL CONFORM TO ASTM A706 GRADE 80(550 MPa) FOR CARBON REBARS(YH).
													4. THE STAINLESS STEEL REINFORCEMENT IS RIBBED BARS.
													5. MINIMUM CONCRETE COVER TO REINFORCEMENT SHALL BE 100mm.
													STAINLESS STEEL REINFORCEMENT SHALL AS A MINIMUM COMPLY WITH THE FOLLOWING.
													FOR BAR DIAMETER 6-50MM
													HOT ROLLED, STEEL GRADE 1.4362 MINIMUM Rp 0.2=500MPa, ACCORDING TO BS6744 AND DELIVERED WITH A 'CARES' CERTIFICATE CUT AND BEND ACCORDING TO BS8666 WITH A 'CARES' CERTIFICATE (YS).
													
													B2 10/09/15 Updated As Shown In Clouds SWK HSH DKK
													B1 12/08/15 Updated As Shown In Clouds SWK HSH DKK
													A4 17/06/15 Updated As Shown In Clouds SWK HSH DKK
													A1 08/04/15 First Issue SWK HSH DKK
													REV. DATE DESCRIPTION OF REVISION DRAWN CHEC. APPRO.
													EMPLOYER
													STATE OF KUWAIT
													MINISTRY OF PUBLIC WORKS
													ROADS ADMINISTRATION
													PROJECT TITLE
													SHEIKH JABER AL AHMAD AL SABAH CAUSEWAY PROJECT (MAIN LINK)
													CONTRACT RA/140
													DRAWING TITLE
													MAIN BRIDGE
													PILE CAP OF PYLON (TIE BEAM)
													BAR LIST
													SCALE
													DRAWN
													DESIGNED
													CHECKED
													APPROVED
													AS SHOWN
													DATE ISSUED
													SWK
													DJB
													HSH
													DKK
													08/04/15
													08/04/15
													08/04/15
													CONTRACTOR
													
													Combined Group
													Contracting Company
													DESIGNER
													
													DRAWING NO.
													RA140-22-BRG-CW-BS-32277
													REV.
													B2
													QUANTITY TABLE OF REINFORCING BAR
													SCALE : NONE
													
14	13	12	11	10	9	8	7	6	5	4	3	2	1

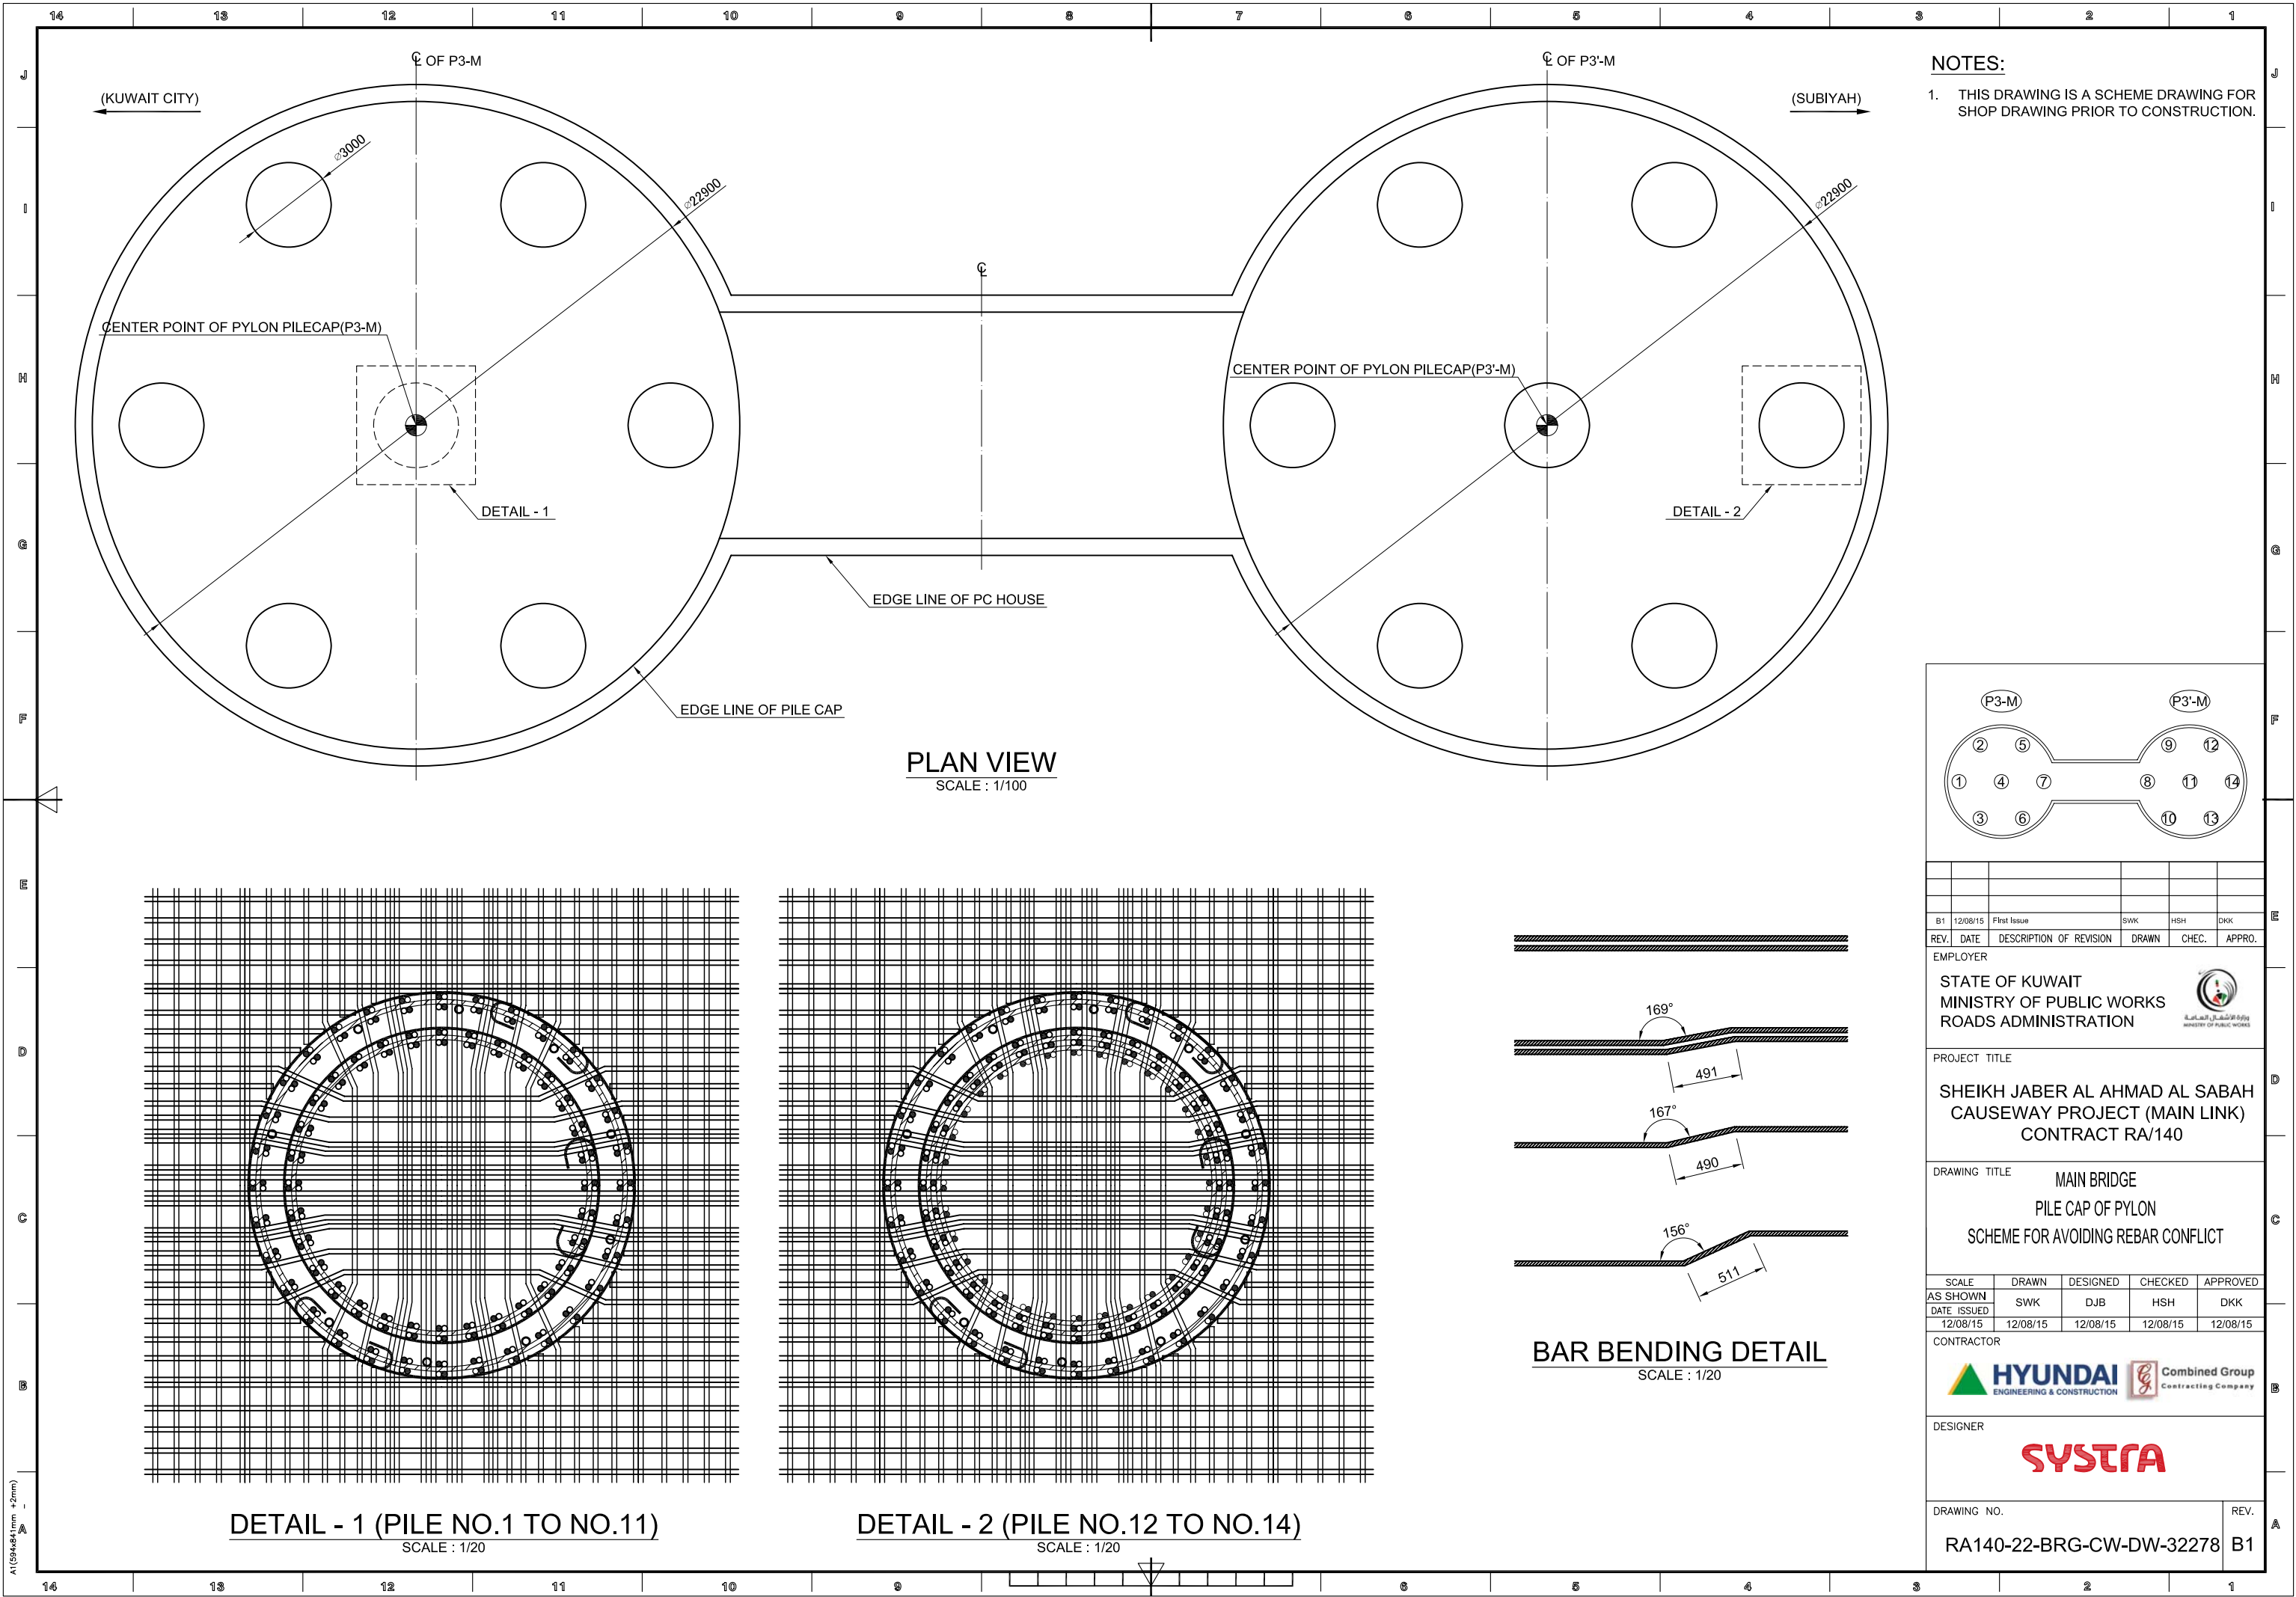


PLAN VIEW
SCALE : 1/100

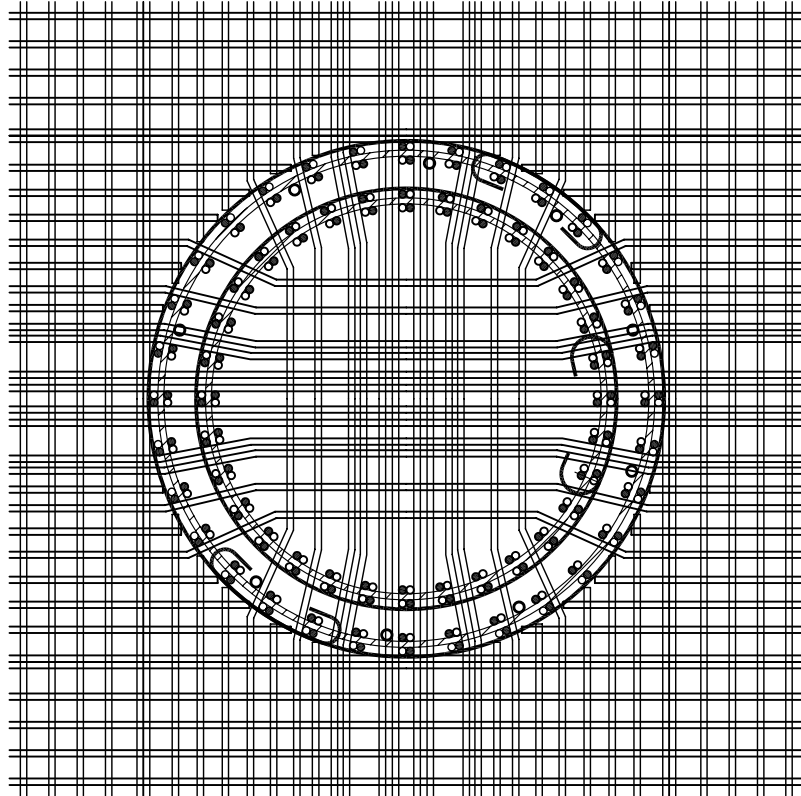

DETAIL - 1 (PILE NO.1 TO NO.11)
SCALE : 1/20

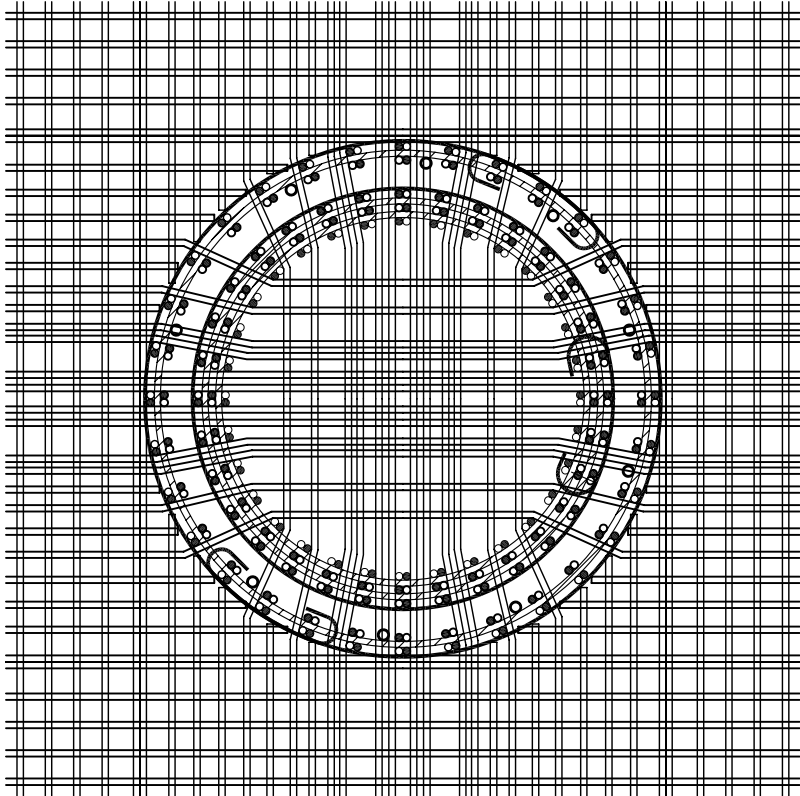


DETAIL - 2 (PILE NO.12 TO NO.14)
SCALE : 1/20

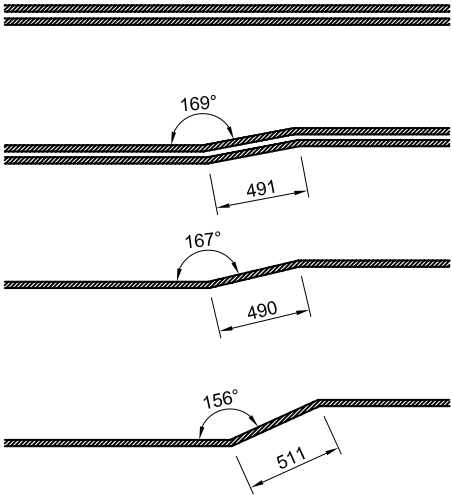

BAR BENDING DETAIL
SCALE : 1/20

NOTES:

1. THIS DRAWING IS A SCHEME DRAWING FOR SHOP DRAWING PRIOR TO CONSTRUCTION.

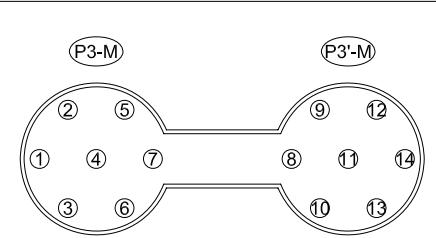

REV.	DATE	DESCRIPTION OF REVISION	DRAWN	CHEC.	APPRO.
B1	12/08/15	First Issue	SWK	HSB	DKK

EMPLOYER
STATE OF KUWAIT
MINISTRY OF PUBLIC WORKS
ROADS ADMINISTRATION

PROJECT TITLE
SHEIKH JABER AL AHMAD AL SABAH
CAUSEWAY PROJECT (MAIN LINK)
CONTRACT RA/140

DRAWING TITLE
MAIN BRIDGE
PILE CAP OF PYLON
SCHEME FOR AVOIDING REBAR CONFLICT


SCALE	DRAWN	DESIGNED	CHECKED	APPROVED
AS SHOWN	SWK	DJB	HSB	DKK
DATE ISSUED	12/08/15	12/08/15	12/08/15	12/08/15

CONTRACTOR
HYUNDAI ENGINEERING & CONSTRUCTION
Combined Group Contracting Company

DESIGNER
SYSTRA


DRAWING NO.
RA140-22-BRG-CW-DW-32278
REV.
B1

A1 (50x40x1mm + 2mm)

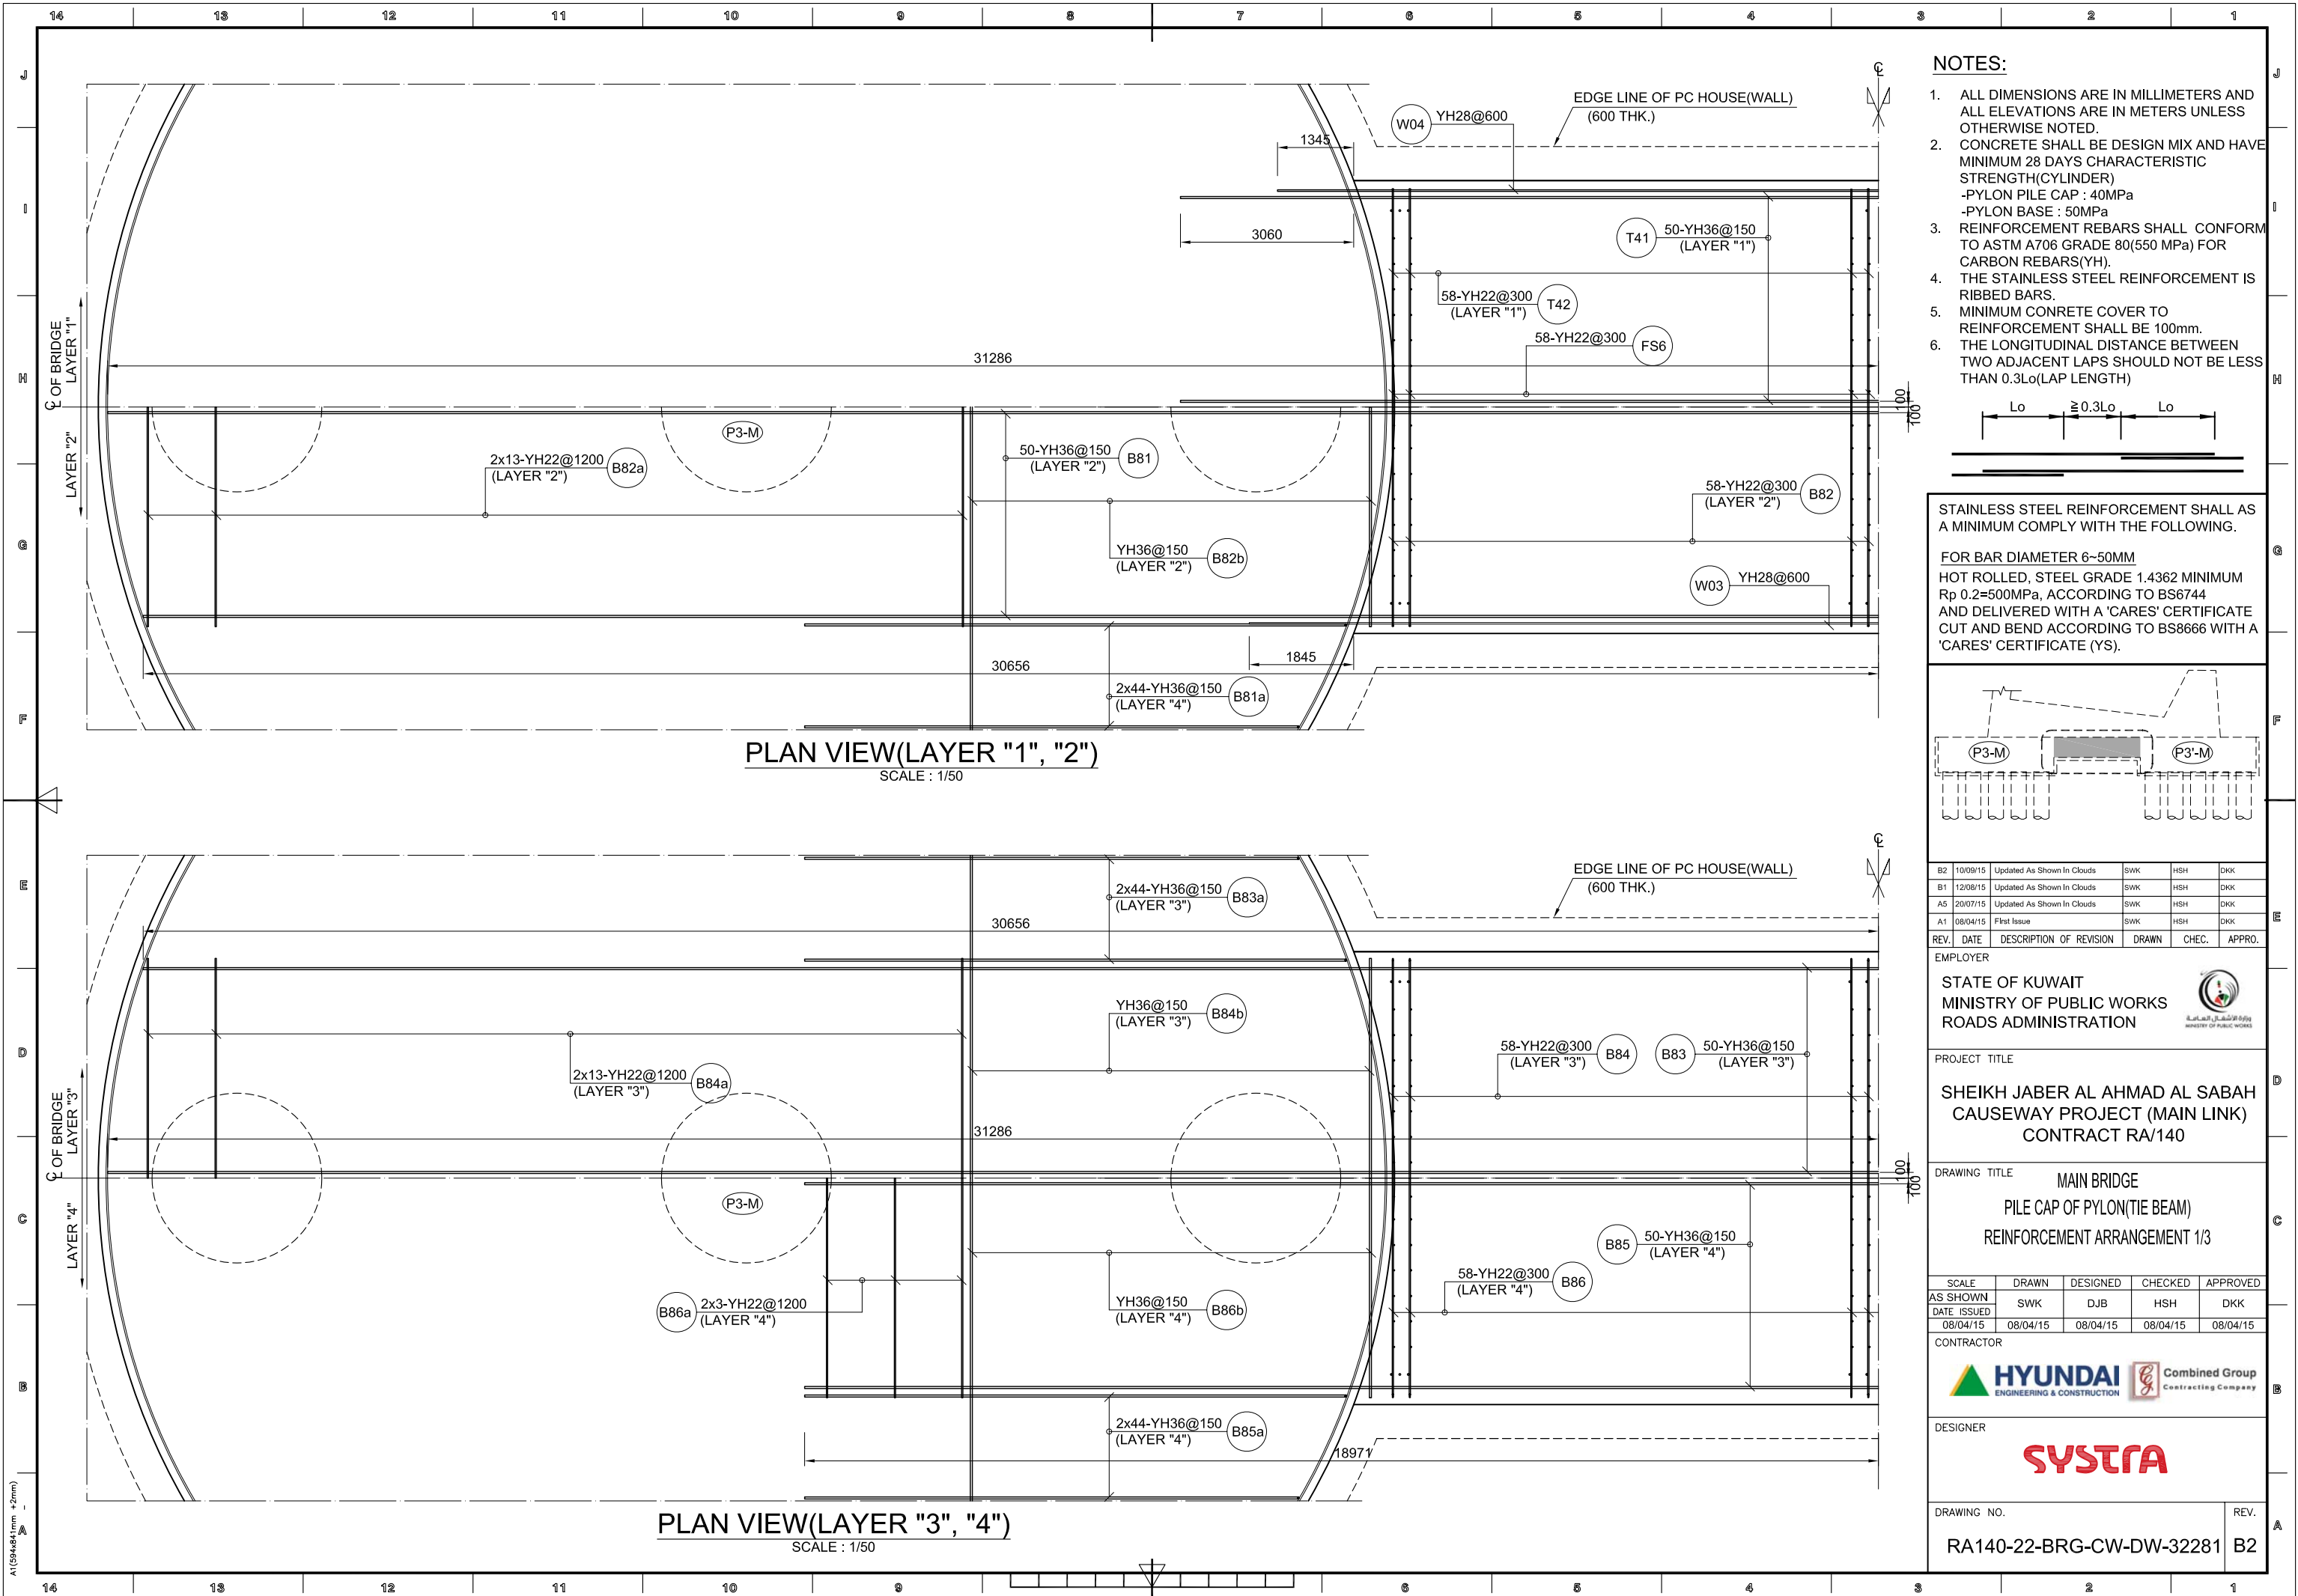


NOTES:

1. ALL DIMENSIONS ARE IN MILLIMETERS AND ALL ELEVATIONS ARE IN METERS UNLESS OTHERWISE NOTED.
2. CONCRETE SHALL BE DESIGN MIX AND HAVE MINIMUM 28 DAYS CHARACTERISTIC STRENGTH(CYLINDER)
-PYLON PILE CAP : 40MPa
-PYLON BASE : 50MPa
3. REINFORCEMENT REBARS SHALL CONFORM TO ASTM A706 GRADE 80(550 MPa) FOR CARBON REBARS(YH).
4. THE STAINLESS STEEL REINFORCEMENT IS RIBBED BARS.
5. MINIMUM CONCRETE COVER TO REINFORCEMENT SHALL BE 100mm.
6. THE LONGITUDINAL DISTANCE BETWEEN TWO ADJACENT LAPS SHOULD NOT BE LESS THAN 0.3Lo(LAP LENGTH)

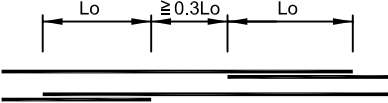

STAINLESS STEEL REINFORCEMENT SHALL AS A MINIMUM COMPLY WITH THE FOLLOWING.

FOR BAR DIAMETER 6-50MM
HOT ROLLED, STEEL GRADE 1.4362 MINIMUM
Rp 0.2=500MPa, ACCORDING TO BS6744
AND DELIVERED WITH A 'CARES' CERTIFICATE
CUT AND BEND ACCORDING TO BS8666 WITH A
'CARES' CERTIFICATE (YS).

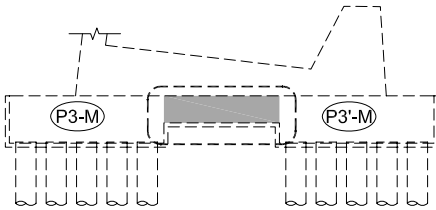

B2	10/09/15	Updated As Shown In Clouds	SWK	HSK	DKK
B1	12/08/15	Updated As Shown In Clouds	SWK	HSK	DKK
A5	20/07/15	Updated As Shown In Clouds	SWK	HSK	DKK
A1	08/04/15	First Issue	SWK	HSK	DKK
REV.	DATE	DESCRIPTION OF REVISION	DRAWN	CHEC.	APPRO.

EMPLOYER

STATE OF KUWAIT
MINISTRY OF PUBLIC WORKS
ROADS ADMINISTRATION



PROJECT TITLE

SHEIKH JABER AL AHMAD AL SABAH
CAUSEWAY PROJECT (MAIN LINK)
CONTRACT RA/140

DRAWING TITLE

MAIN BRIDGE
PILE CAP OF PYLON(TIE BEAM)
REINFORCEMENT ARRANGEMENT 1/3

SCALE	DRAWN	DESIGNED	CHECKED	APPROVED
AS SHOWN	SWK	DJB	HSK	DKK
DATE ISSUED	08/04/15	08/04/15	08/04/15	08/04/15

CONTRACTOR



DESIGNER

SYSTRA


DRAWING NO.

RA140-22-BRG-CW-DW-32281

REV.

B2


A1(594x841mm +2mm)

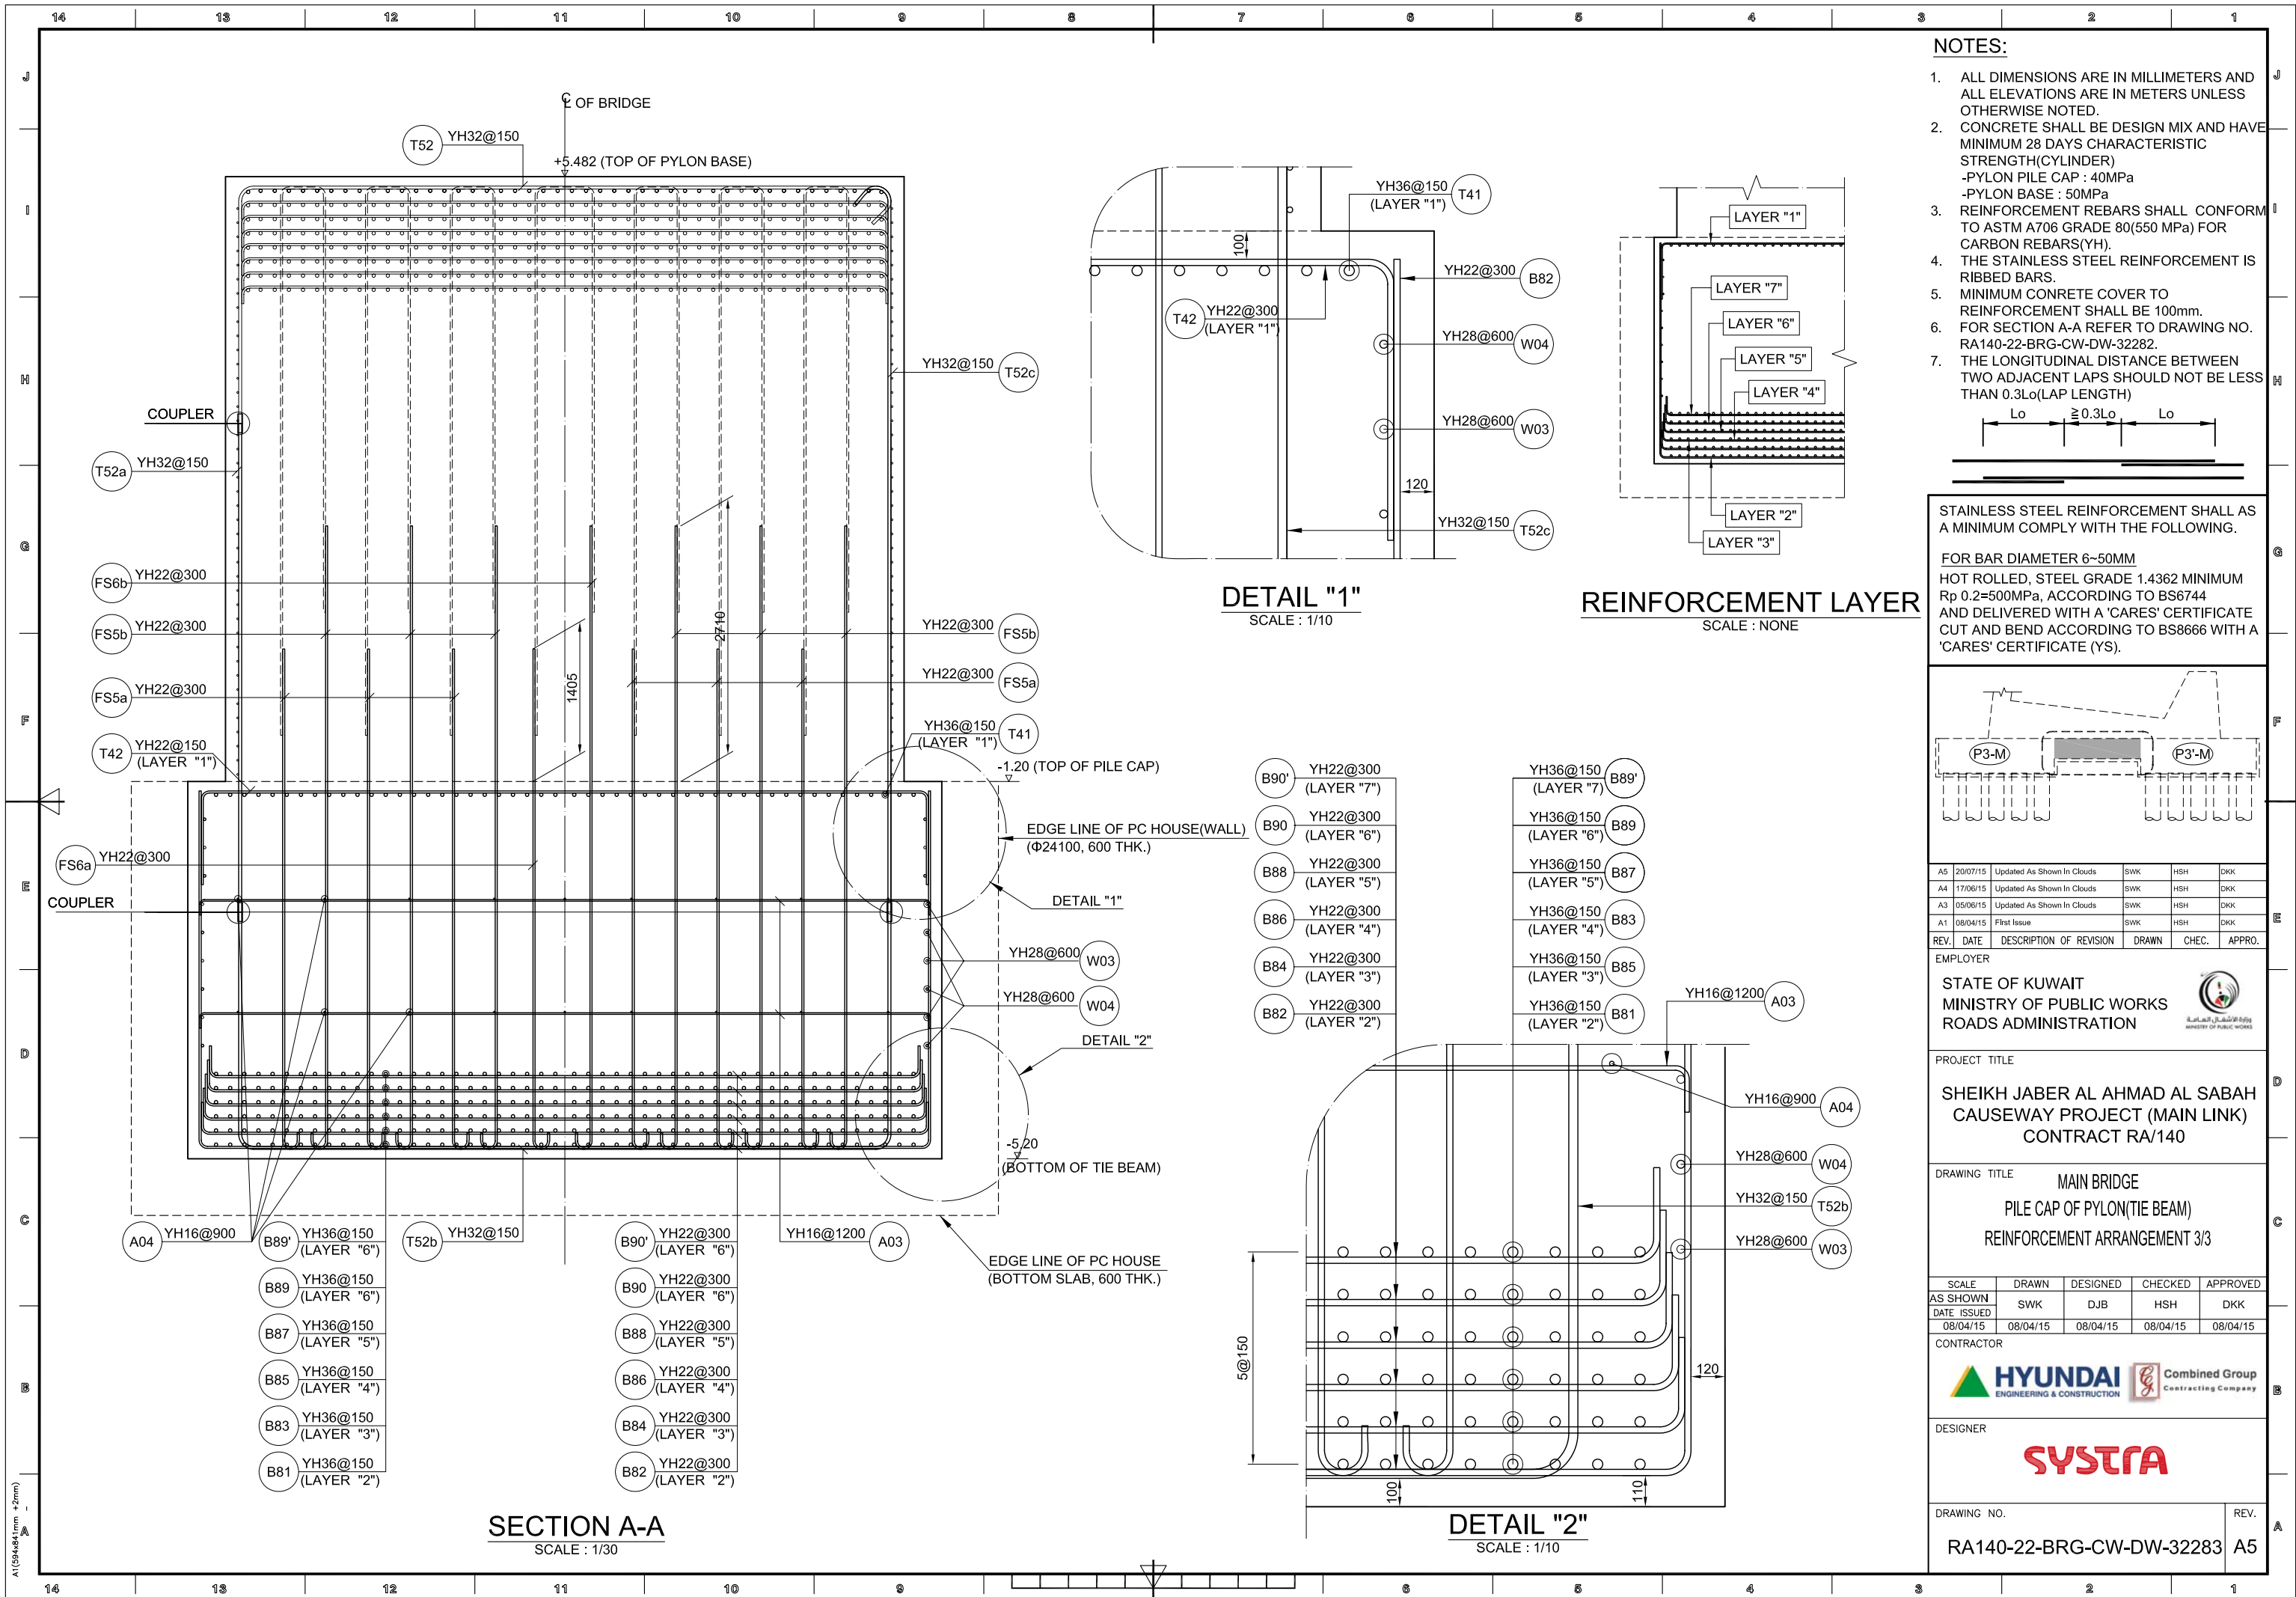

	13	12	11	10	9	8	7	6	5	4	3	2	1
--	----	----	----	----	---	---	---	---	---	---	---	---	---

NOTES:

- ALL DIMENSIONS ARE IN MILLIMETERS AND
ALL ELEVATIONS ARE IN METERS UNLESS
OTHERWISE NOTED.
- CONCRETE SHALL BE DESIGN MIX AND HAVE
MINIMUM 28 DAYS CHARACTERISTIC
STRENGTH(CYLINDER)
- PYLON PILE CAP : 40MPa
-PYLON BASE : 50MPa
- REINFORCEMENT REBARS SHALL CONFORM
TO ASTM A706 GRADE 80(550 MPa) FOR
CARBON REBARS(YH).
- THE STAINLESS STEEL REINFORCEMENT IS
RIBBED BARS.
- MINIMUM CONCRETE COVER TO
REINFORCEMENT SHALL BE 100mm.

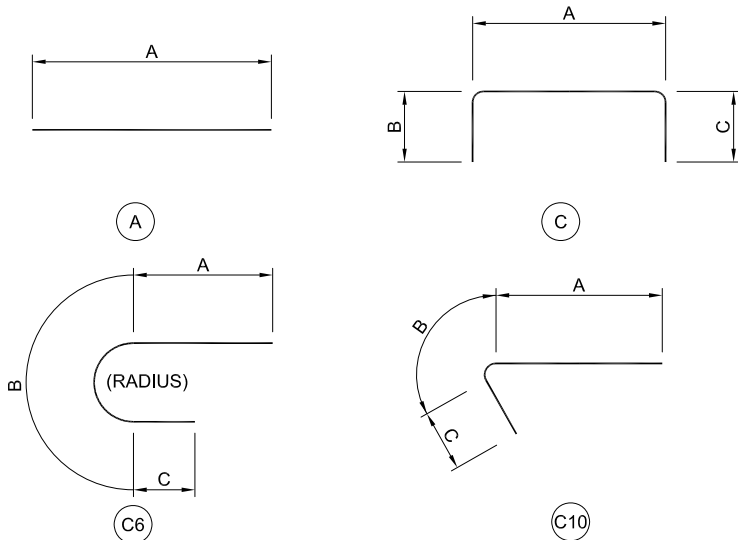

MARKS	DIA.	SHAPE	NOS	REINFORCING BAR DIMENSION (mm)									LAP SPLICE (mm)		LENGTH (m)	WEIGHT (kg)
				A	B	C	D	E	F	G	H	I	LENGTH	NUMBER		
B82a	Y22	A	26	7,760											202	602
B84a	Y22	A	26	7,760											202	602
B86a	Y22	A	6	7,760											47	139
B88a	Y22	A	16	7,760											124	370
B90a	Y22	A	6	7,760											47	139
B90'a	Y22	A	6	7,760											47	139
W03	Y28	A	8	22,233									1,345	1	189	913
W04	Y28	A	10	21,233									1,345	1	226	1,093
A03	Y16	C	30	7,788	164	164									243	385
A04	Y16	A	18	19,643									660	1	365	577
T52a	Y32	A	116	4,302											499	3,149
T52b	Y32	C	116	6,928	2,500	2,500									1,384	8,731
T52c	Y32	C10	116	6,801	339	192									850	5,366
FS5a	Y22	C6	348	5,217	276	88									1,942	5,794
FS5b	Y22	C6	348	6,522	276	88									2,396	7,148
FS6a	Y22	C6	58	5,217	276	88									324	966
FS6b	Y22	C6	58	6,522	276	88									399	1,191
TOTAL WEIGHT (kg)																210,835
TOTAL WEIGHT (TON)																210.835

[illegible]


No.	COUNT	REMARKS
YH32	348	

COUPLER DETAIL

SCALE : NONE

QUANTITY TABLE OF REINFORCING BAR

SCALE : NONE

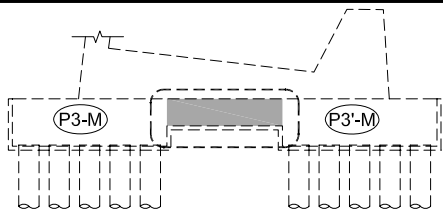

B2	10/09/15	Updated As Shown In Clouds	SWK	HSB	DKK
B1	12/08/15	Updated As Shown In Clouds	SWK	HSB	DKK
A4	17/06/15	Updated As Shown In Clouds	SWK	HSB	DKK
A1	08/04/15	First Issue	SWK	HSB	DKK
REV.	DATE	DESCRIPTION OF REVISION	DRAWN	CHEC.	APPRO.

EMPLOYER

STATE OF KUWAIT
MINISTRY OF PUBLIC WORKS
ROADS ADMINISTRATION



PROJECT TITLE

SHEIKH JABER AL AHMAD AL SABAH
CAUSEWAY PROJECT (MAIN LINK)
CONTRACT RA/140

DRAWING TITLE

MAIN BRIDGE
PILE CAP OF PYLON (TIE BEAM)
BAR LIST

SCALE	DRAWN	DESIGNED	CHECKED	APPROVED
AS SHOWN	SWK	DJB	HSH	DKK
DATE ISSUED				
08/04/15	08/04/15	08/04/15	08/04/15	08/04/15

CONTRACTOR



DESIGNER




DRAWING NO

RA140-22-BRG-CW-BS-32284

REV.


B2

	13	12	11	10	9										6	5	4	3	2	1
--	----	----	----	----	---	--	--	--	--	--	--	--	--	--	---	---	---	---	---	---

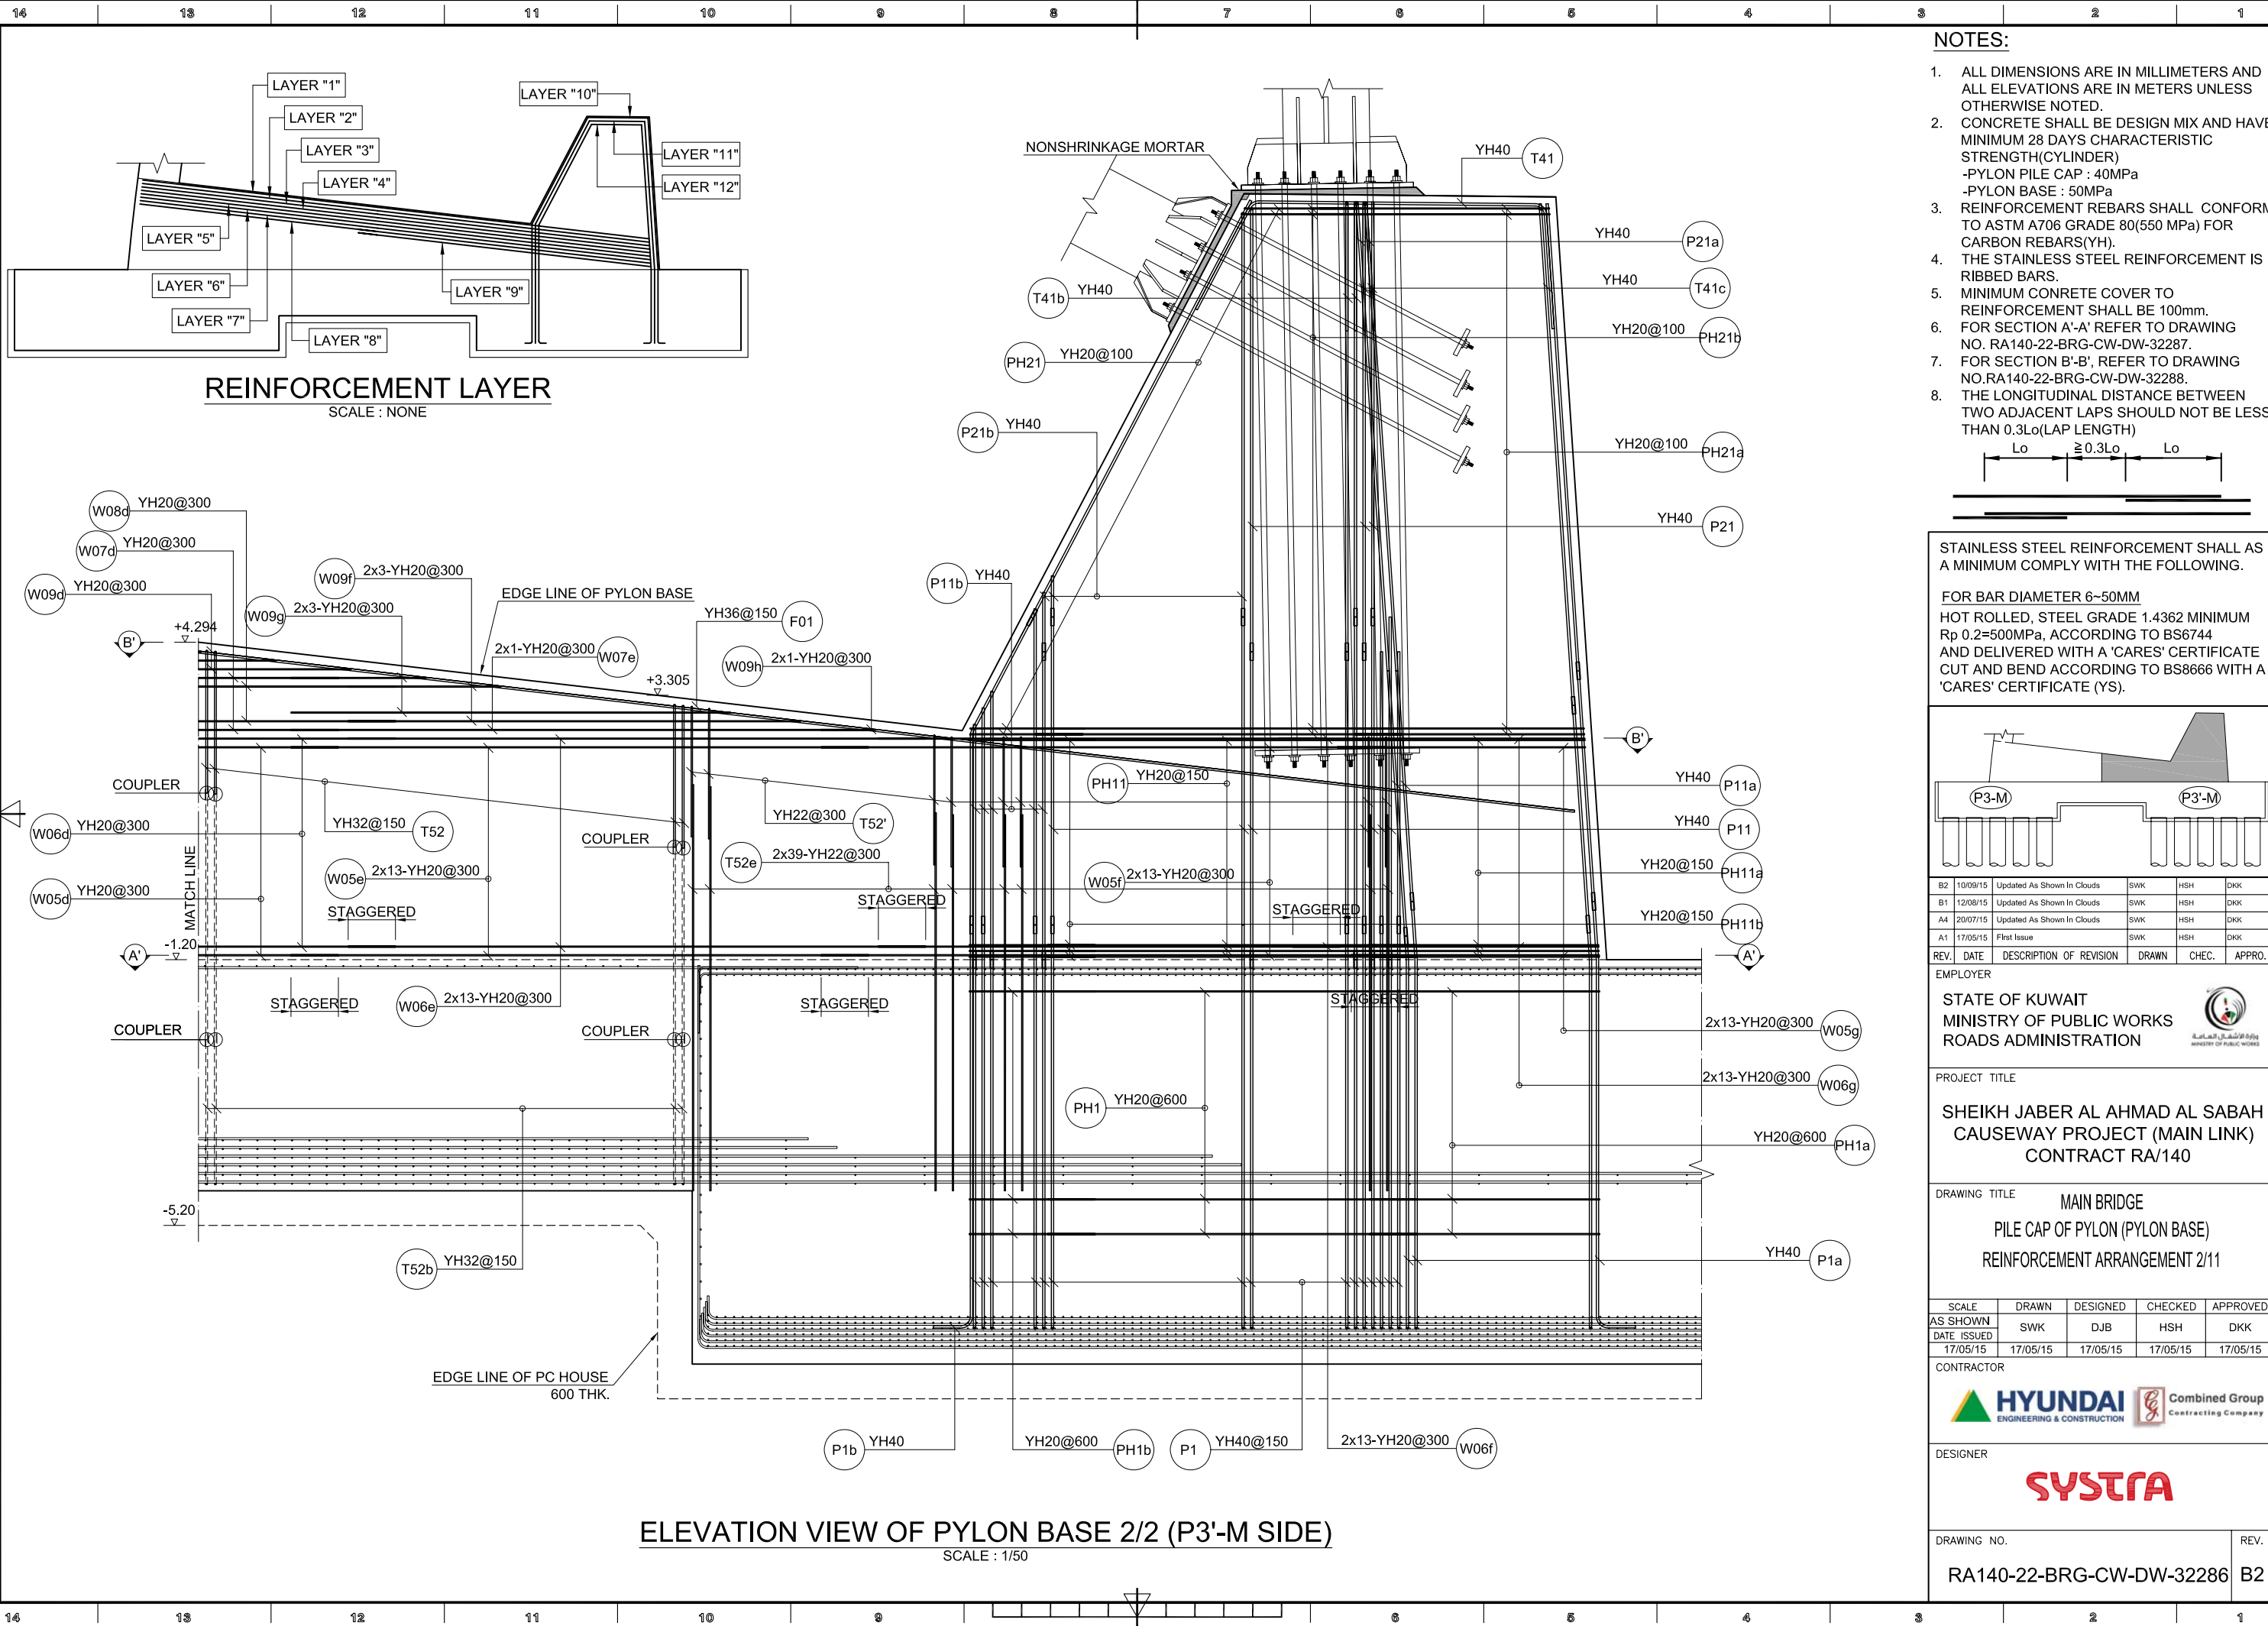


NOTES:

- ALL DIMENSIONS ARE IN MILLIMETERS AND ALL ELEVATIONS ARE IN METERS UNLESS OTHERWISE NOTED.
- CONCRETE SHALL BE DESIGN MIX AND HAVE MINIMUM 28 DAYS CHARACTERISTIC STRENGTH(CYLINDER)
-PYLON PILE CAP : 40MPa
-PYLON BASE : 50MPa
- REINFORCEMENT REBARS SHALL CONFORM TO ASTM A706 GRADE 80(550 MPa) FOR CARBON REBARS(YH).
- THE STAINLESS STEEL REINFORCEMENT IS RIBBED BARS.
- MINIMUM CONCRETE COVER TO REINFORCEMENT SHALL BE 100mm.
- FOR SECTION A'-A' REFER TO DRAWING NO. RA140-22-BRG-CW-DW-32287.
- FOR SECTION B'-B', REFER TO DRAWING NO. RA140-22-BRG-CW-DW-32288.
- THE LONGITUDINAL DISTANCE BETWEEN TWO ADJACENT LAPS SHOULD NOT BE LESS THAN 0.3Lo(LAP LENGTH)

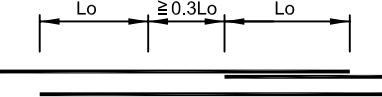

STAINLESS STEEL REINFORCEMENT SHALL AS A MINIMUM COMPLY WITH THE FOLLOWING.

FOR BAR DIAMETER 6-50MM
HOT ROLLED, STEEL GRADE 1.4362 MINIMUM
Rp 0.2=500MPa, ACCORDING TO BS6744
AND DELIVERED WITH A 'CARES' CERTIFICATE
CUT AND BEND ACCORDING TO BS8666 WITH A
'CARES' CERTIFICATE (YS).

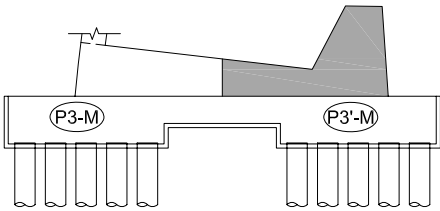

B2	10/09/15	Updated As Shown In Clouds	SWK	HSH	DKK
B1	12/08/15	Updated As Shown In Clouds	SWK	HSH	DKK
A4	20/07/15	Updated As Shown In Clouds	SWK	HSH	DKK
A1	17/05/15	First Issue	SWK	HSH	DKK
REV.	DATE	DESCRIPTION OF REVISION	DRAWN	CHEC.	APPRO.

EMPLOYER

STATE OF KUWAIT
MINISTRY OF PUBLIC WORKS
ROADS ADMINISTRATION

PROJECT TITLE

SHEIKH JABER AL AHMAD AL SABAH
CAUSEWAY PROJECT (MAIN LINK)
CONTRACT RA/140

DRAWING TITLE

MAIN BRIDGE
PILE CAP OF PYLON (PYLON BASE)
REINFORCEMENT ARRANGEMENT 2/11

SCALE	DRAWN	DESIGNED	CHECKED	APPROVED
AS SHOWN	SWK	DJB	HSH	DKK
DATE ISSUED	17/05/15	17/05/15	17/05/15	17/05/15

CONTRACTOR

HYUNDAI ENGINEERING & CONSTRUCTION
Combined Group Contracting Company


DESIGNER


SYSTRA

DRAWING NO.


RA140-22-BRG-CW-DW-32286 B2

REV.

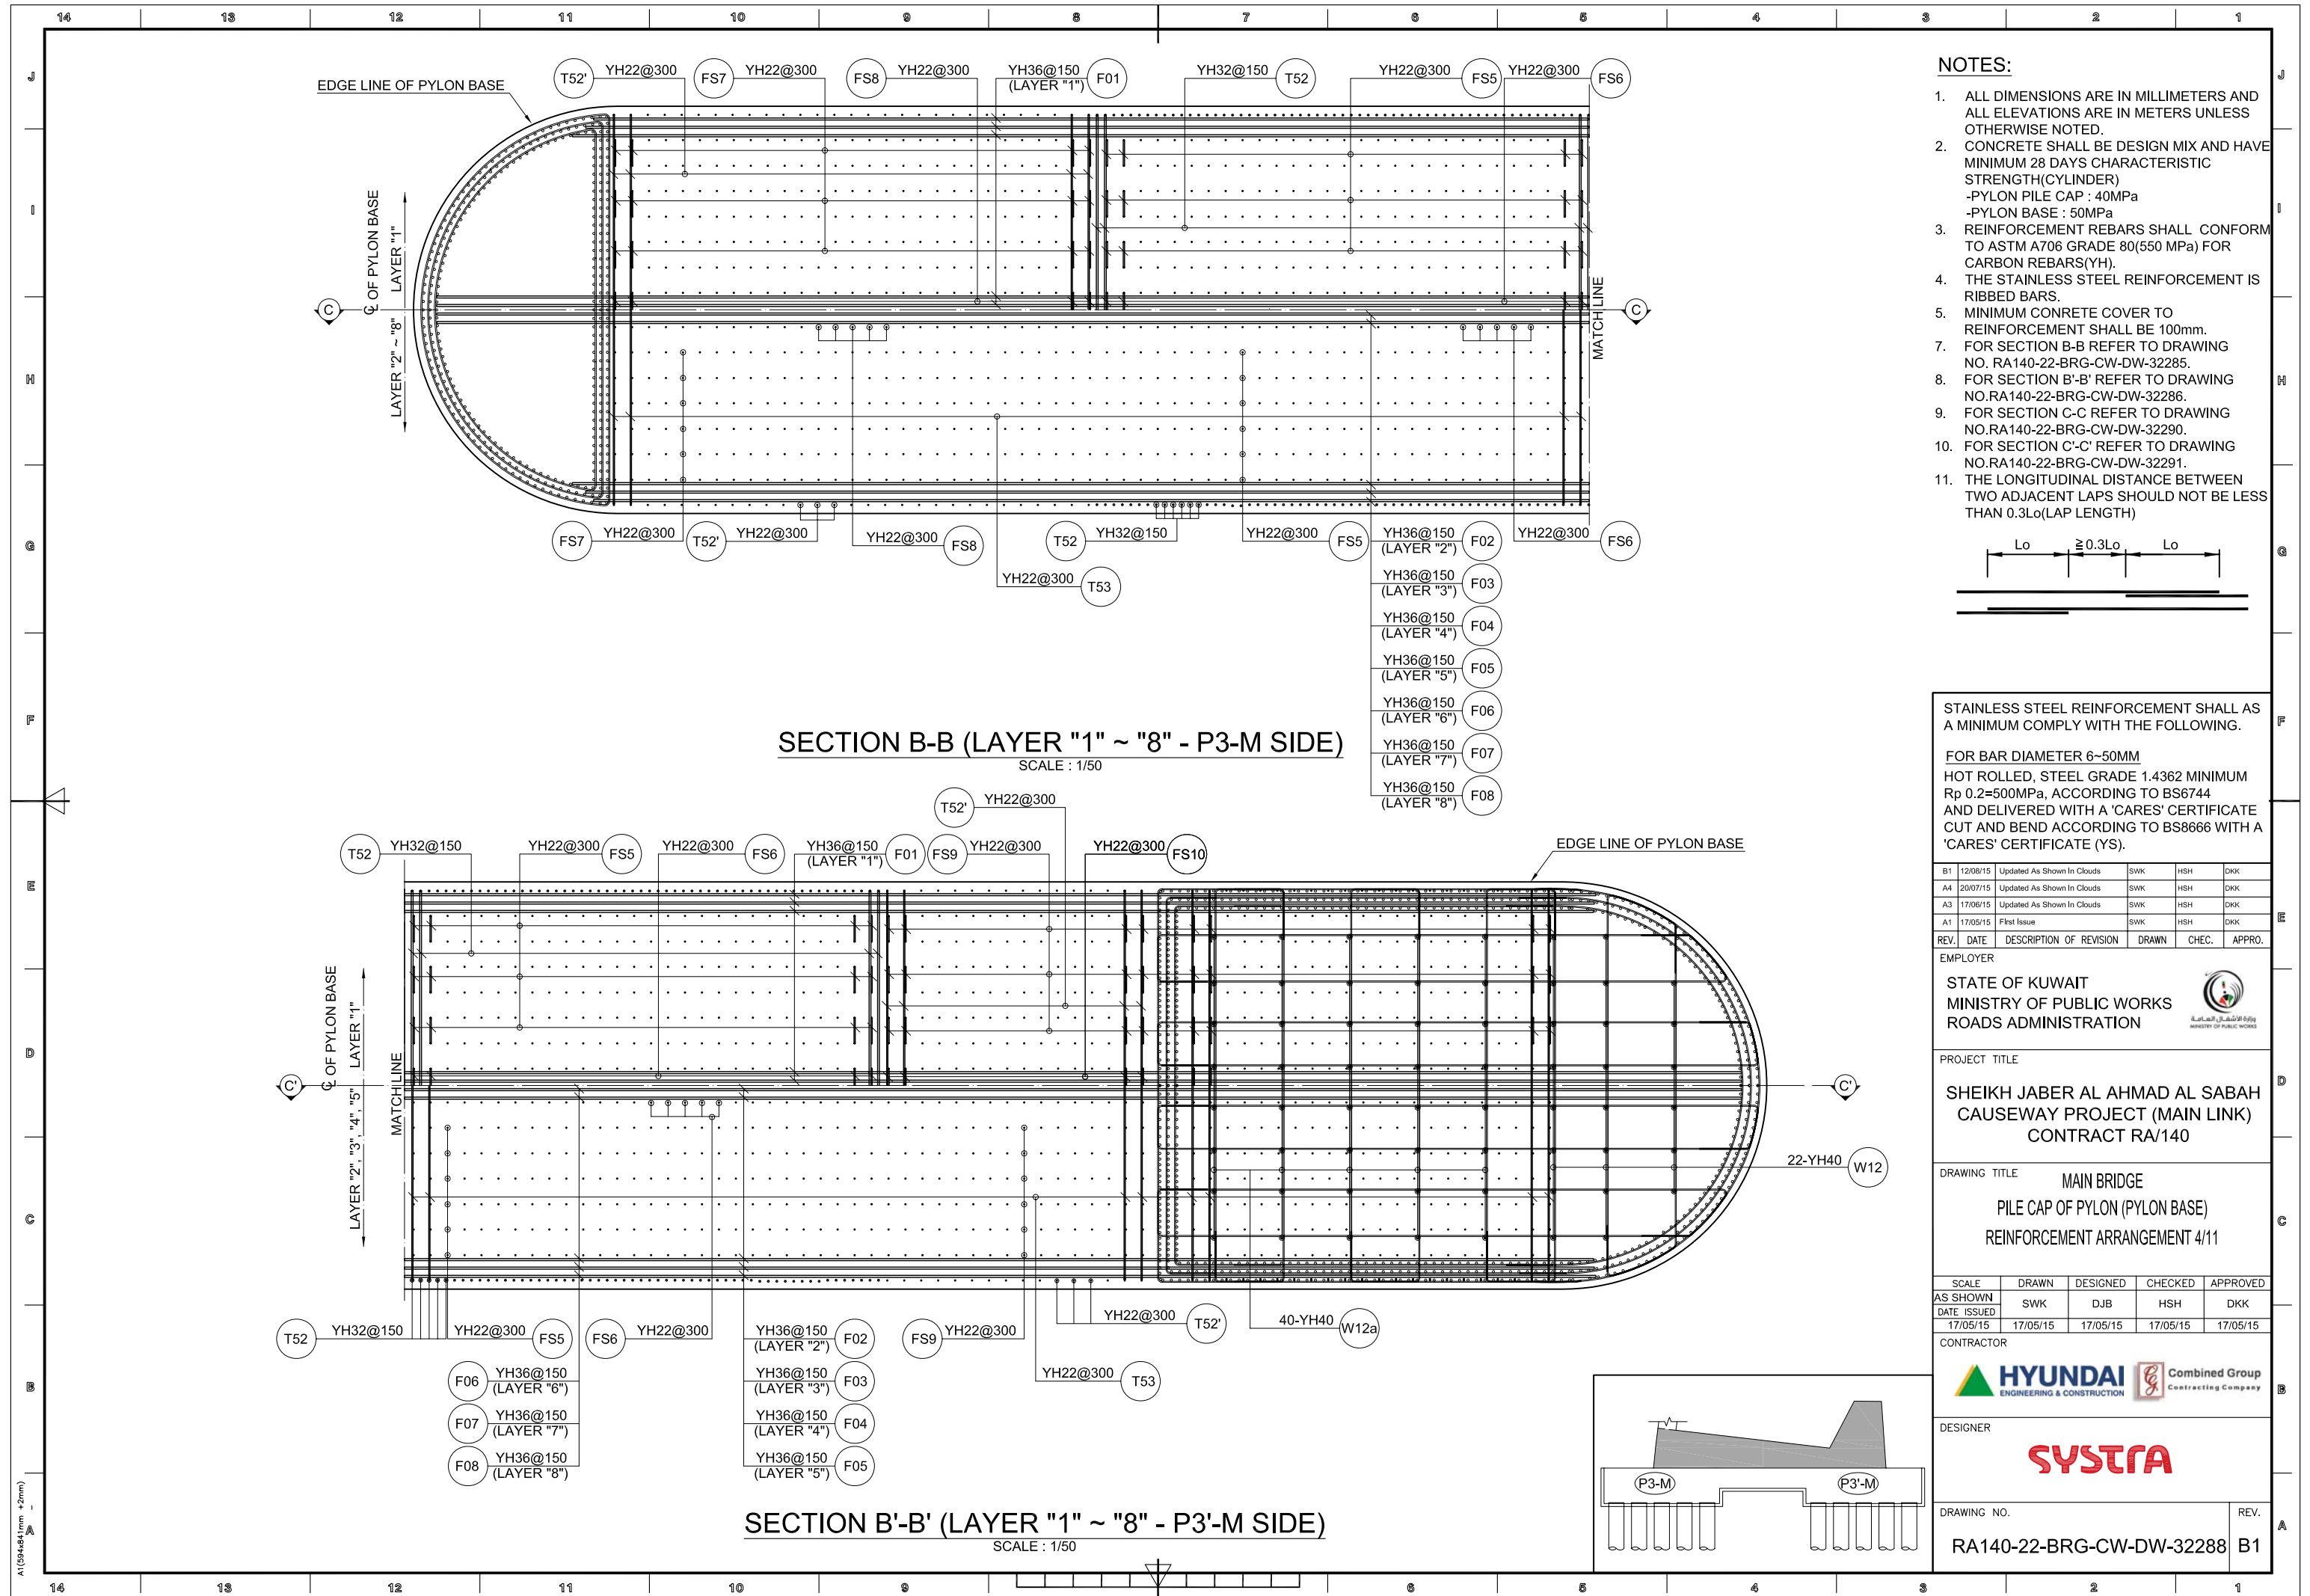


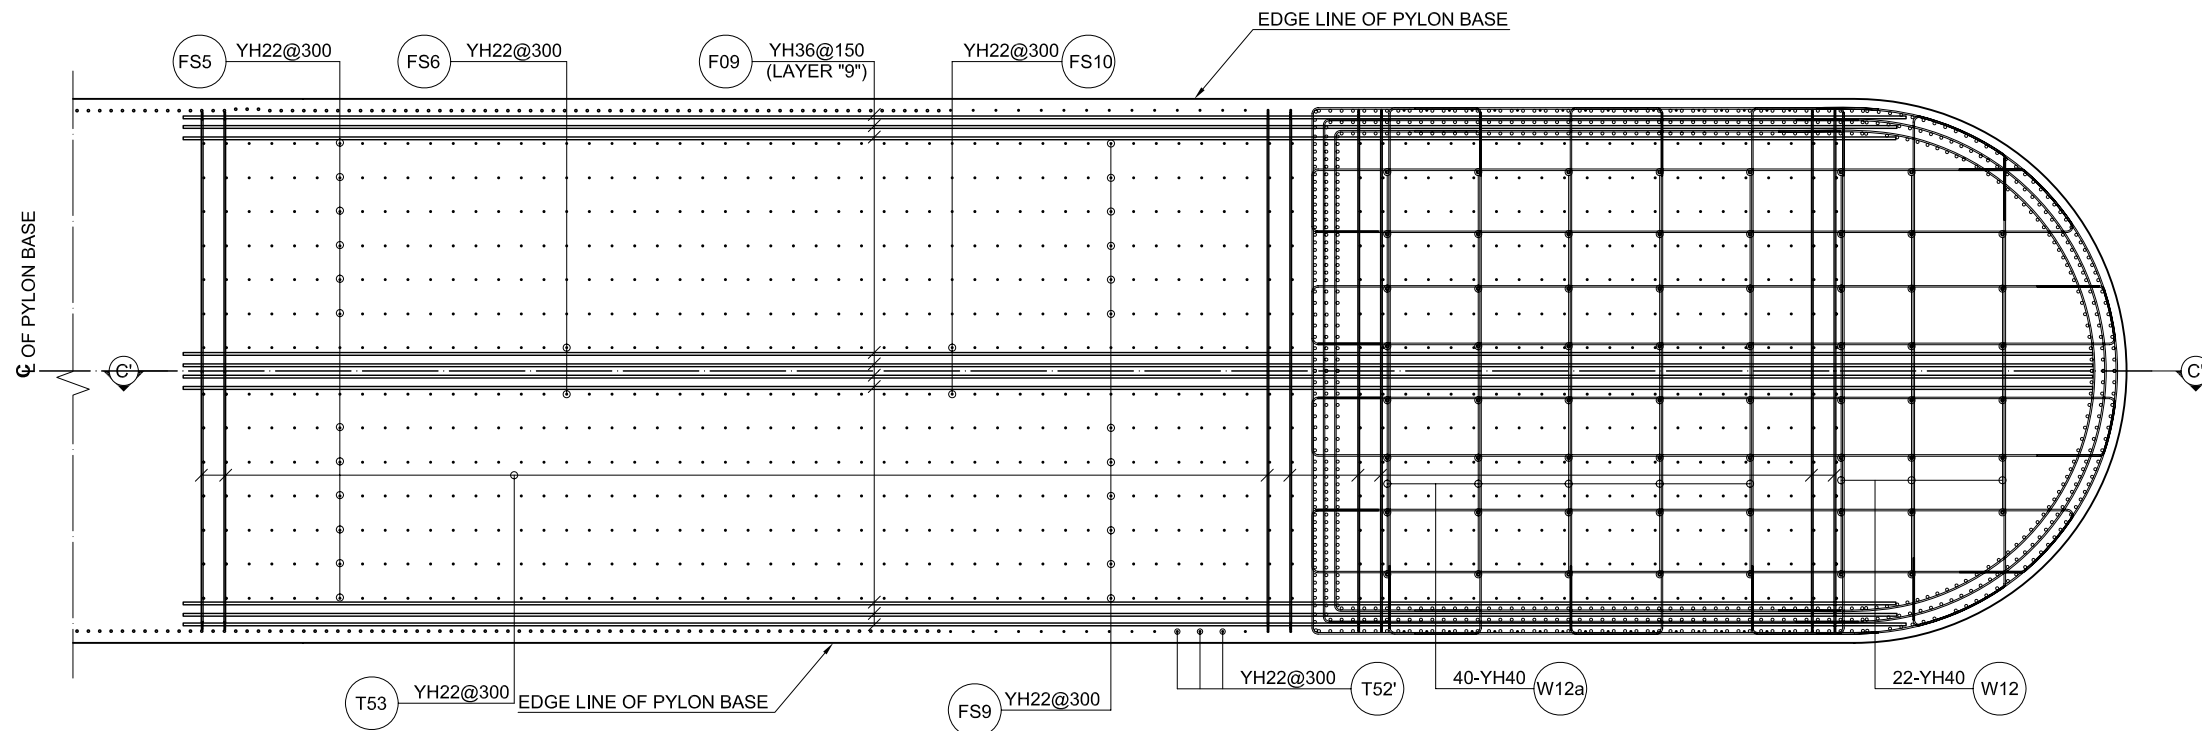


SECTION B'-B' (LAYER "9" - P3'-M SIDE)
SCALE : 1/50

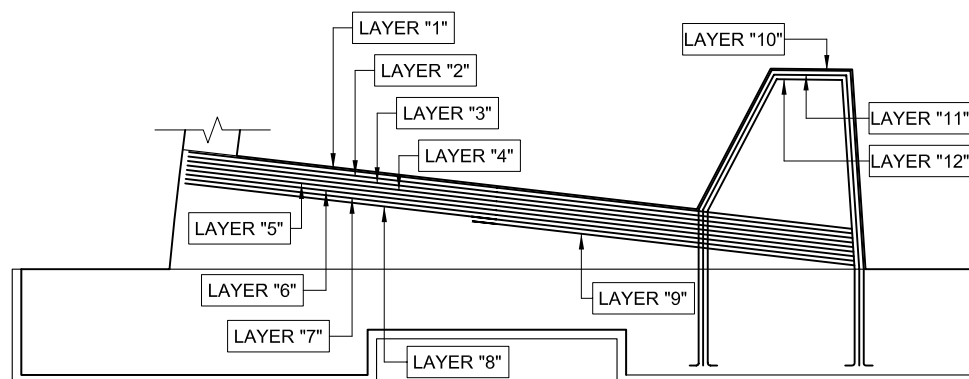

REINFORCEMENT LAYER
SCALE : NONE

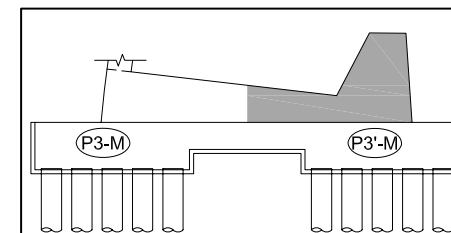

- NOTES:
- ALL DIMENSIONS ARE IN MILLIMETERS AND ALL ELEVATIONS ARE IN METERS UNLESS OTHERWISE NOTED.
 - CONCRETE SHALL BE DESIGN MIX AND HAVE MINIMUM 28 DAYS CHARACTERISTIC STRENGTH(CYLINDER)
-PYLON PILE CAP : 40MPa
-PYLON BASE : 50MPa
 - REINFORCEMENT REBARS SHALL CONFORM TO ASTM A706 GRADE 80(550 MPa) FOR CARBON REBARS(YH).
 - THE STAINLESS STEEL REINFORCEMENT IS RIBBED BARS.
 - MINIMUM CONCRETE COVER TO REINFORCEMENT SHALL BE 100mm.
 - FOR SECTION B-B REFER TO DRAWING NO. RA140-22-BRG-CW-DW-32285.
 - FOR SECTION B'-B' REFER TO DRAWING NO.RA140-22-BRG-CW-DW-32286.
 - THE LONGITUDINAL DISTANCE BETWEEN TWO ADJACENT LAPS SHOULD NOT BE LESS THAN 0.3Lo(LAP LENGTH)

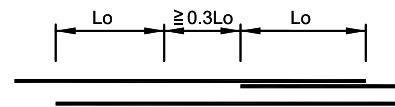

STAINLESS STEEL REINFORCEMENT SHALL AS A MINIMUM COMPLY WITH THE FOLLOWING.

FOR BAR DIAMETER 6~50MM
HOT ROLLED, STEEL GRADE 1.4362 MINIMUM Rp 0.2=500MPa, ACCORDING TO BS6744 AND DELIVERED WITH A 'CARES' CERTIFICATE CUT AND BEND ACCORDING TO BS8666 WITH A 'CARES' CERTIFICATE (YS).

B1	12/08/15	Updated As Shown In Clouds	SWK	HSK	DKK
A4	20/07/15	Updated As Shown In Clouds	SWK	HSK	DKK
A3	17/06/15	Updated As Shown In Clouds	SWK	HSK	DKK
A1	17/05/15	First Issue	SWK	HSK	DKK
REV.	DATE	DESCRIPTION OF REVISION	DRAWN	CHEC.	APPRO.

EMPLOYER

STATE OF KUWAIT
MINISTRY OF PUBLIC WORKS
ROADS ADMINISTRATION



PROJECT TITLE

SHEIKH JABER AL AHMAD AL SABAH
CAUSEWAY PROJECT (MAIN LINK)
CONTRACT RA/140

DRAWING TITLE

MAIN BRIDGE
PILE CAP OF PYLON (PYLON BASE)
REINFORCEMENT ARRANGEMENT 5/11

SCALE	DRAWN	DESIGNED	CHECKED	APPROVED
AS SHOWN	SWK	DJB	HSK	DKK
DATE ISSUED	17/05/15	17/05/15	17/05/15	17/05/15

CONTRACTOR




DESIGNER

SYSTRA


DRAWING NO.

RA140-22-BRG-CW-DW-32289 B1

REV.

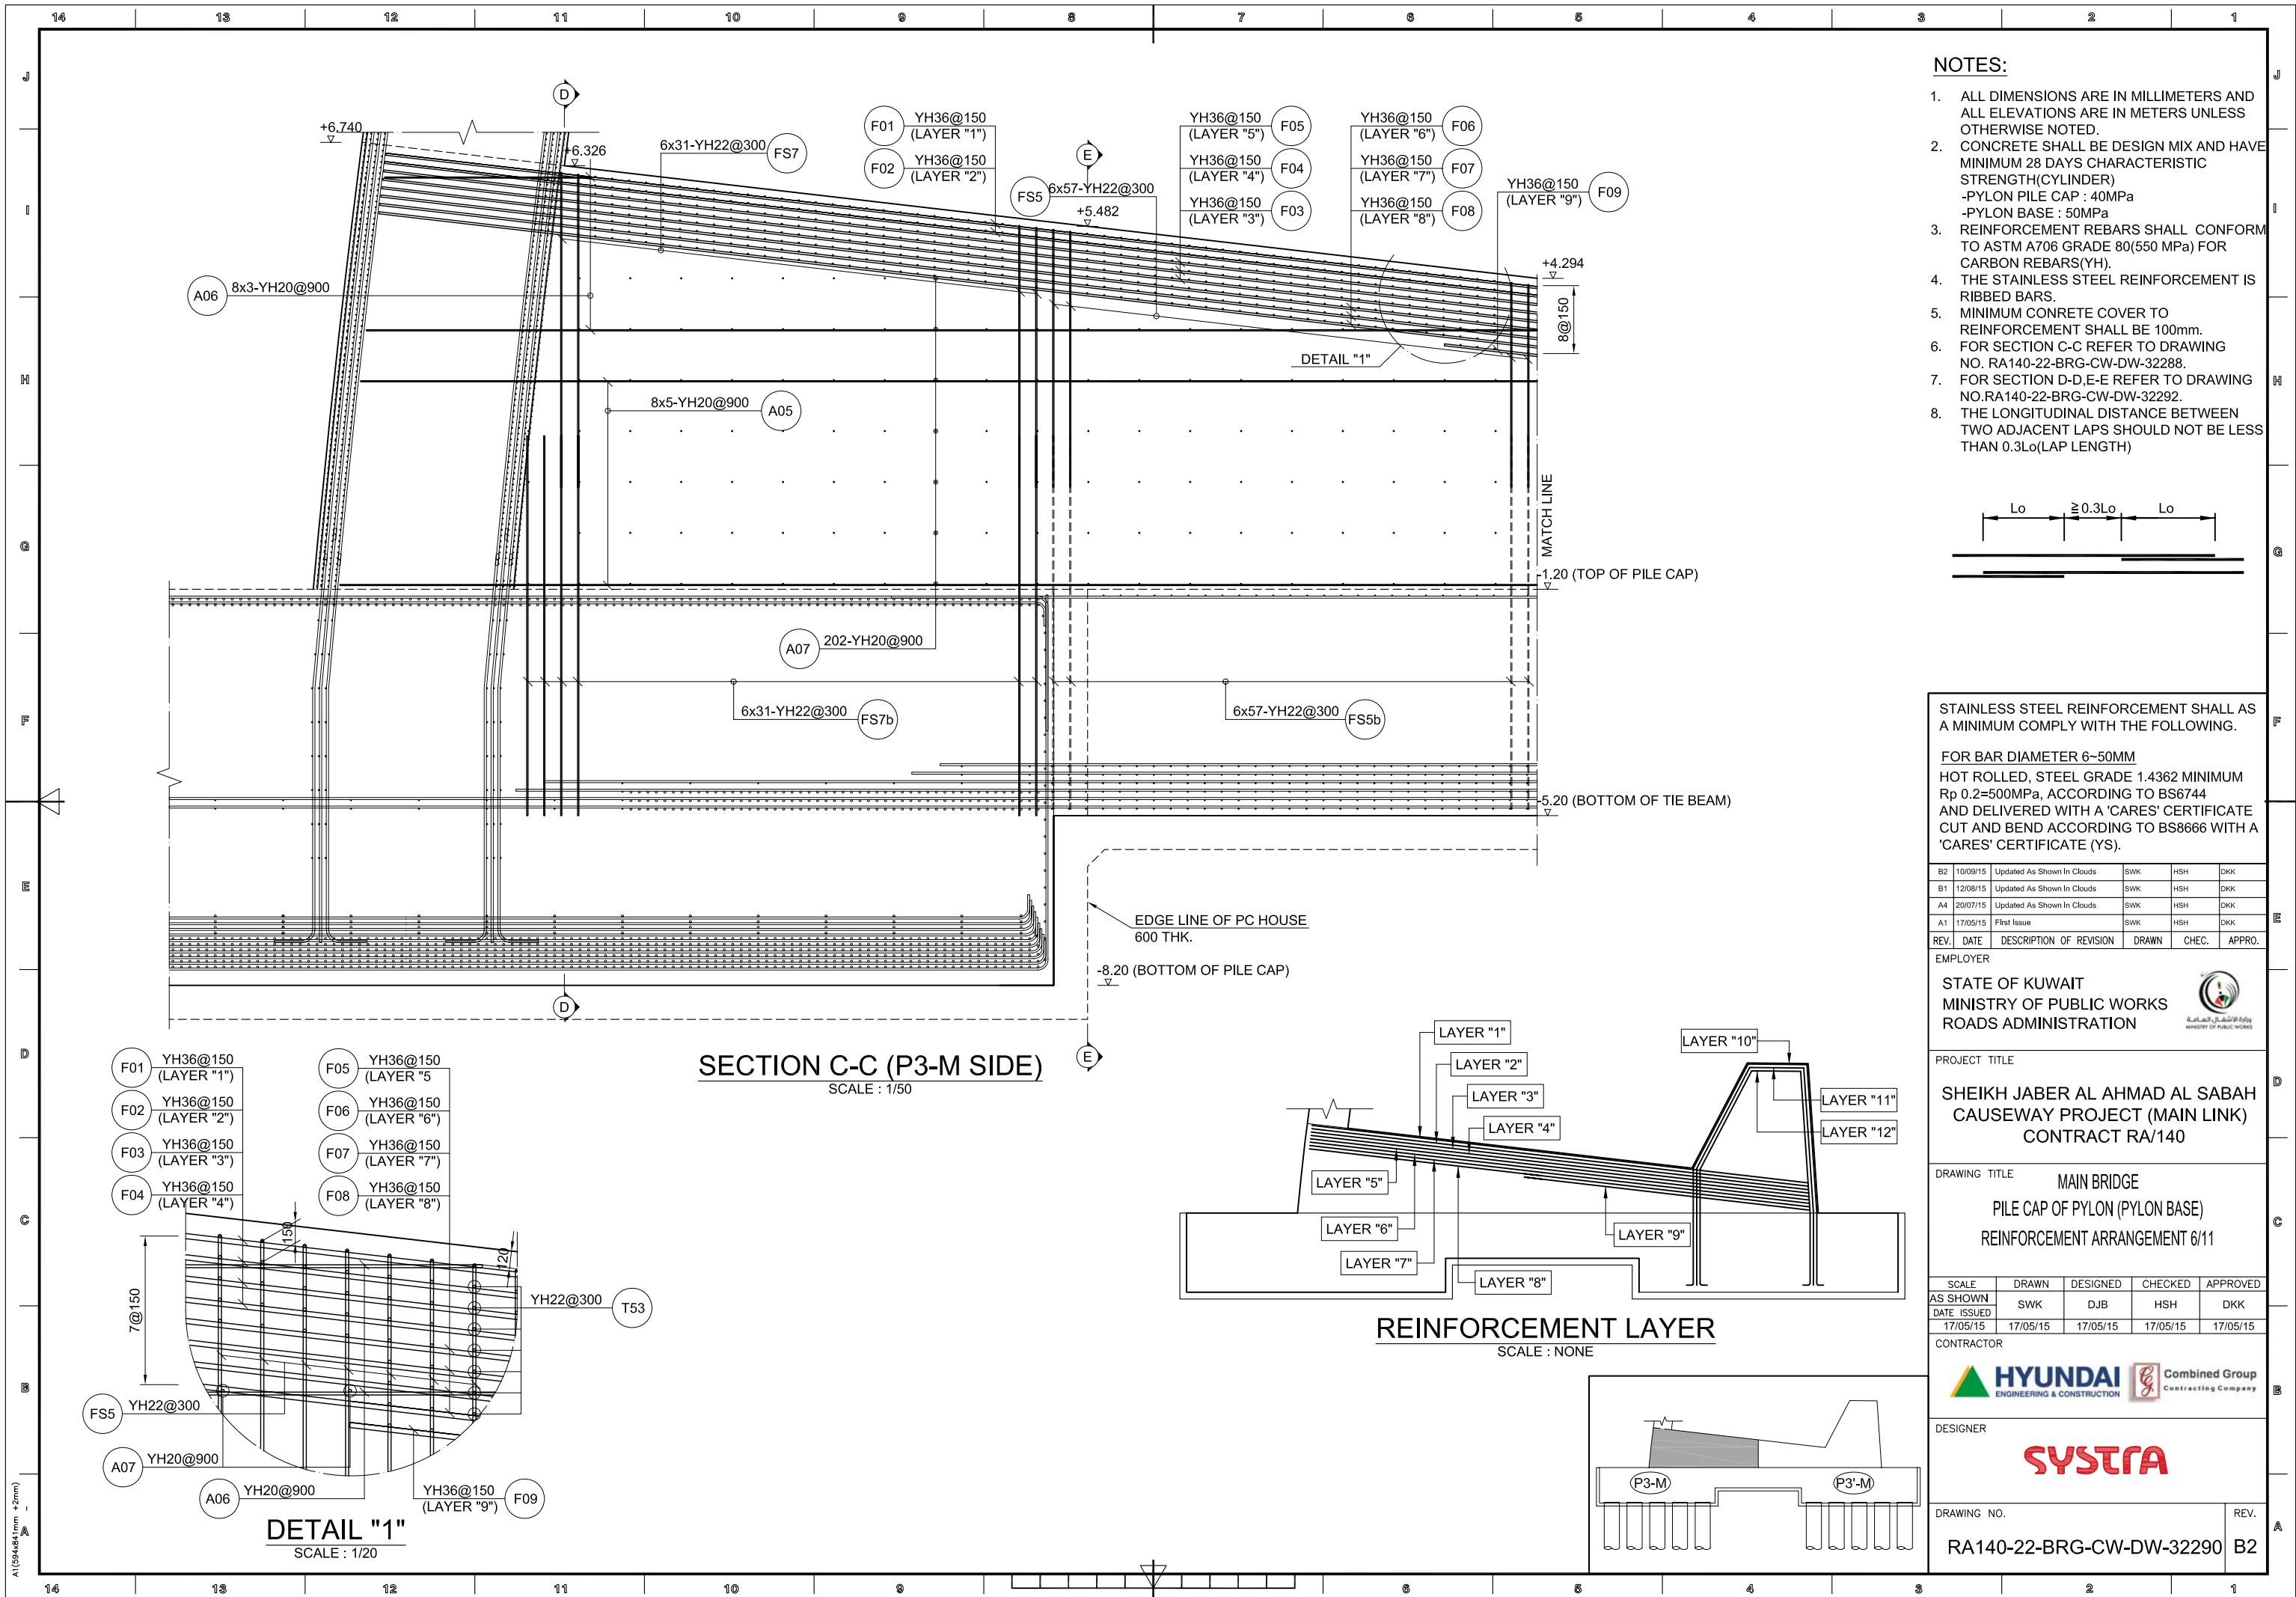

- NOTES:**
- ALL DIMENSIONS ARE IN MILLIMETERS AND ALL ELEVATIONS ARE IN METERS UNLESS OTHERWISE NOTED.
 - CONCRETE SHALL BE DESIGN MIX AND HAVE MINIMUM 28 DAYS CHARACTERISTIC STRENGTH(CYLINDER)
-PYLON PILE CAP : 40MPa
-PYLON BASE : 50MPa
 - REINFORCEMENT REBARS SHALL CONFORM TO ASTM A706 GRADE 80(550 MPa) FOR CARBON REBARS(YH).
 - THE STAINLESS STEEL REINFORCEMENT IS RIBBED BARS.
 - MINIMUM CONCRETE COVER TO REINFORCEMENT SHALL BE 100mm.
 - FOR SECTION C-C REFER TO DRAWING NO. RA140-22-BRG-CW-DW-32288.
 - FOR SECTION D-D,E-E REFER TO DRAWING NO.RA140-22-BRG-CW-DW-32292.
 - THE LONGITUDINAL DISTANCE BETWEEN TWO ADJACENT LAPS SHOULD NOT BE LESS THAN 0.3Lo(LAP LENGTH)

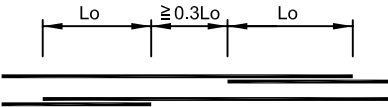

STAINLESS STEEL REINFORCEMENT SHALL AS A MINIMUM COMPLY WITH THE FOLLOWING.

FOR BAR DIAMETER 6~50MM
HOT ROLLED, STEEL GRADE 1.4362 MINIMUM Rp 0.2=500MPa, ACCORDING TO BS6744 AND DELIVERED WITH A 'CARES' CERTIFICATE CUT AND BEND ACCORDING TO BS8666 WITH A 'CARES' CERTIFICATE (YS).

B2	10/09/15	Updated As Shown In Clouds	SWK	HSK	DKK
B1	12/08/15	Updated As Shown In Clouds	SWK	HSK	DKK
A4	20/07/15	Updated As Shown In Clouds	SWK	HSK	DKK
A1	17/05/15	First Issue	SWK	HSK	DKK
REV.	DATE	DESCRIPTION OF REVISION	DRAWN	CHEC.	APPRO.

EMPLOYER
STATE OF KUWAIT
MINISTRY OF PUBLIC WORKS
ROADS ADMINISTRATION

PROJECT TITLE
SHEIKH JABER AL AHMAD AL SABAH
CAUSEWAY PROJECT (MAIN LINK)
CONTRACT RA/140


DRAWING TITLE
MAIN BRIDGE
PILE CAP OF PYLON (PYLON BASE)
REINFORCEMENT ARRANGEMENT 6/11

SCALE	DRAWN	DESIGNED	CHECKED	APPROVED
AS SHOWN	SWK	DJB	HSK	DKK
DATE ISSUED	17/05/15	17/05/15	17/05/15	17/05/15

CONTRACTOR
HYUNDAI ENGINEERING & CONSTRUCTION
Combined Group Contracting Company


DESIGNER
SYSTRA

DRAWING NO.
RA140-22-BRG-CW-DW-32290
REV.
B2

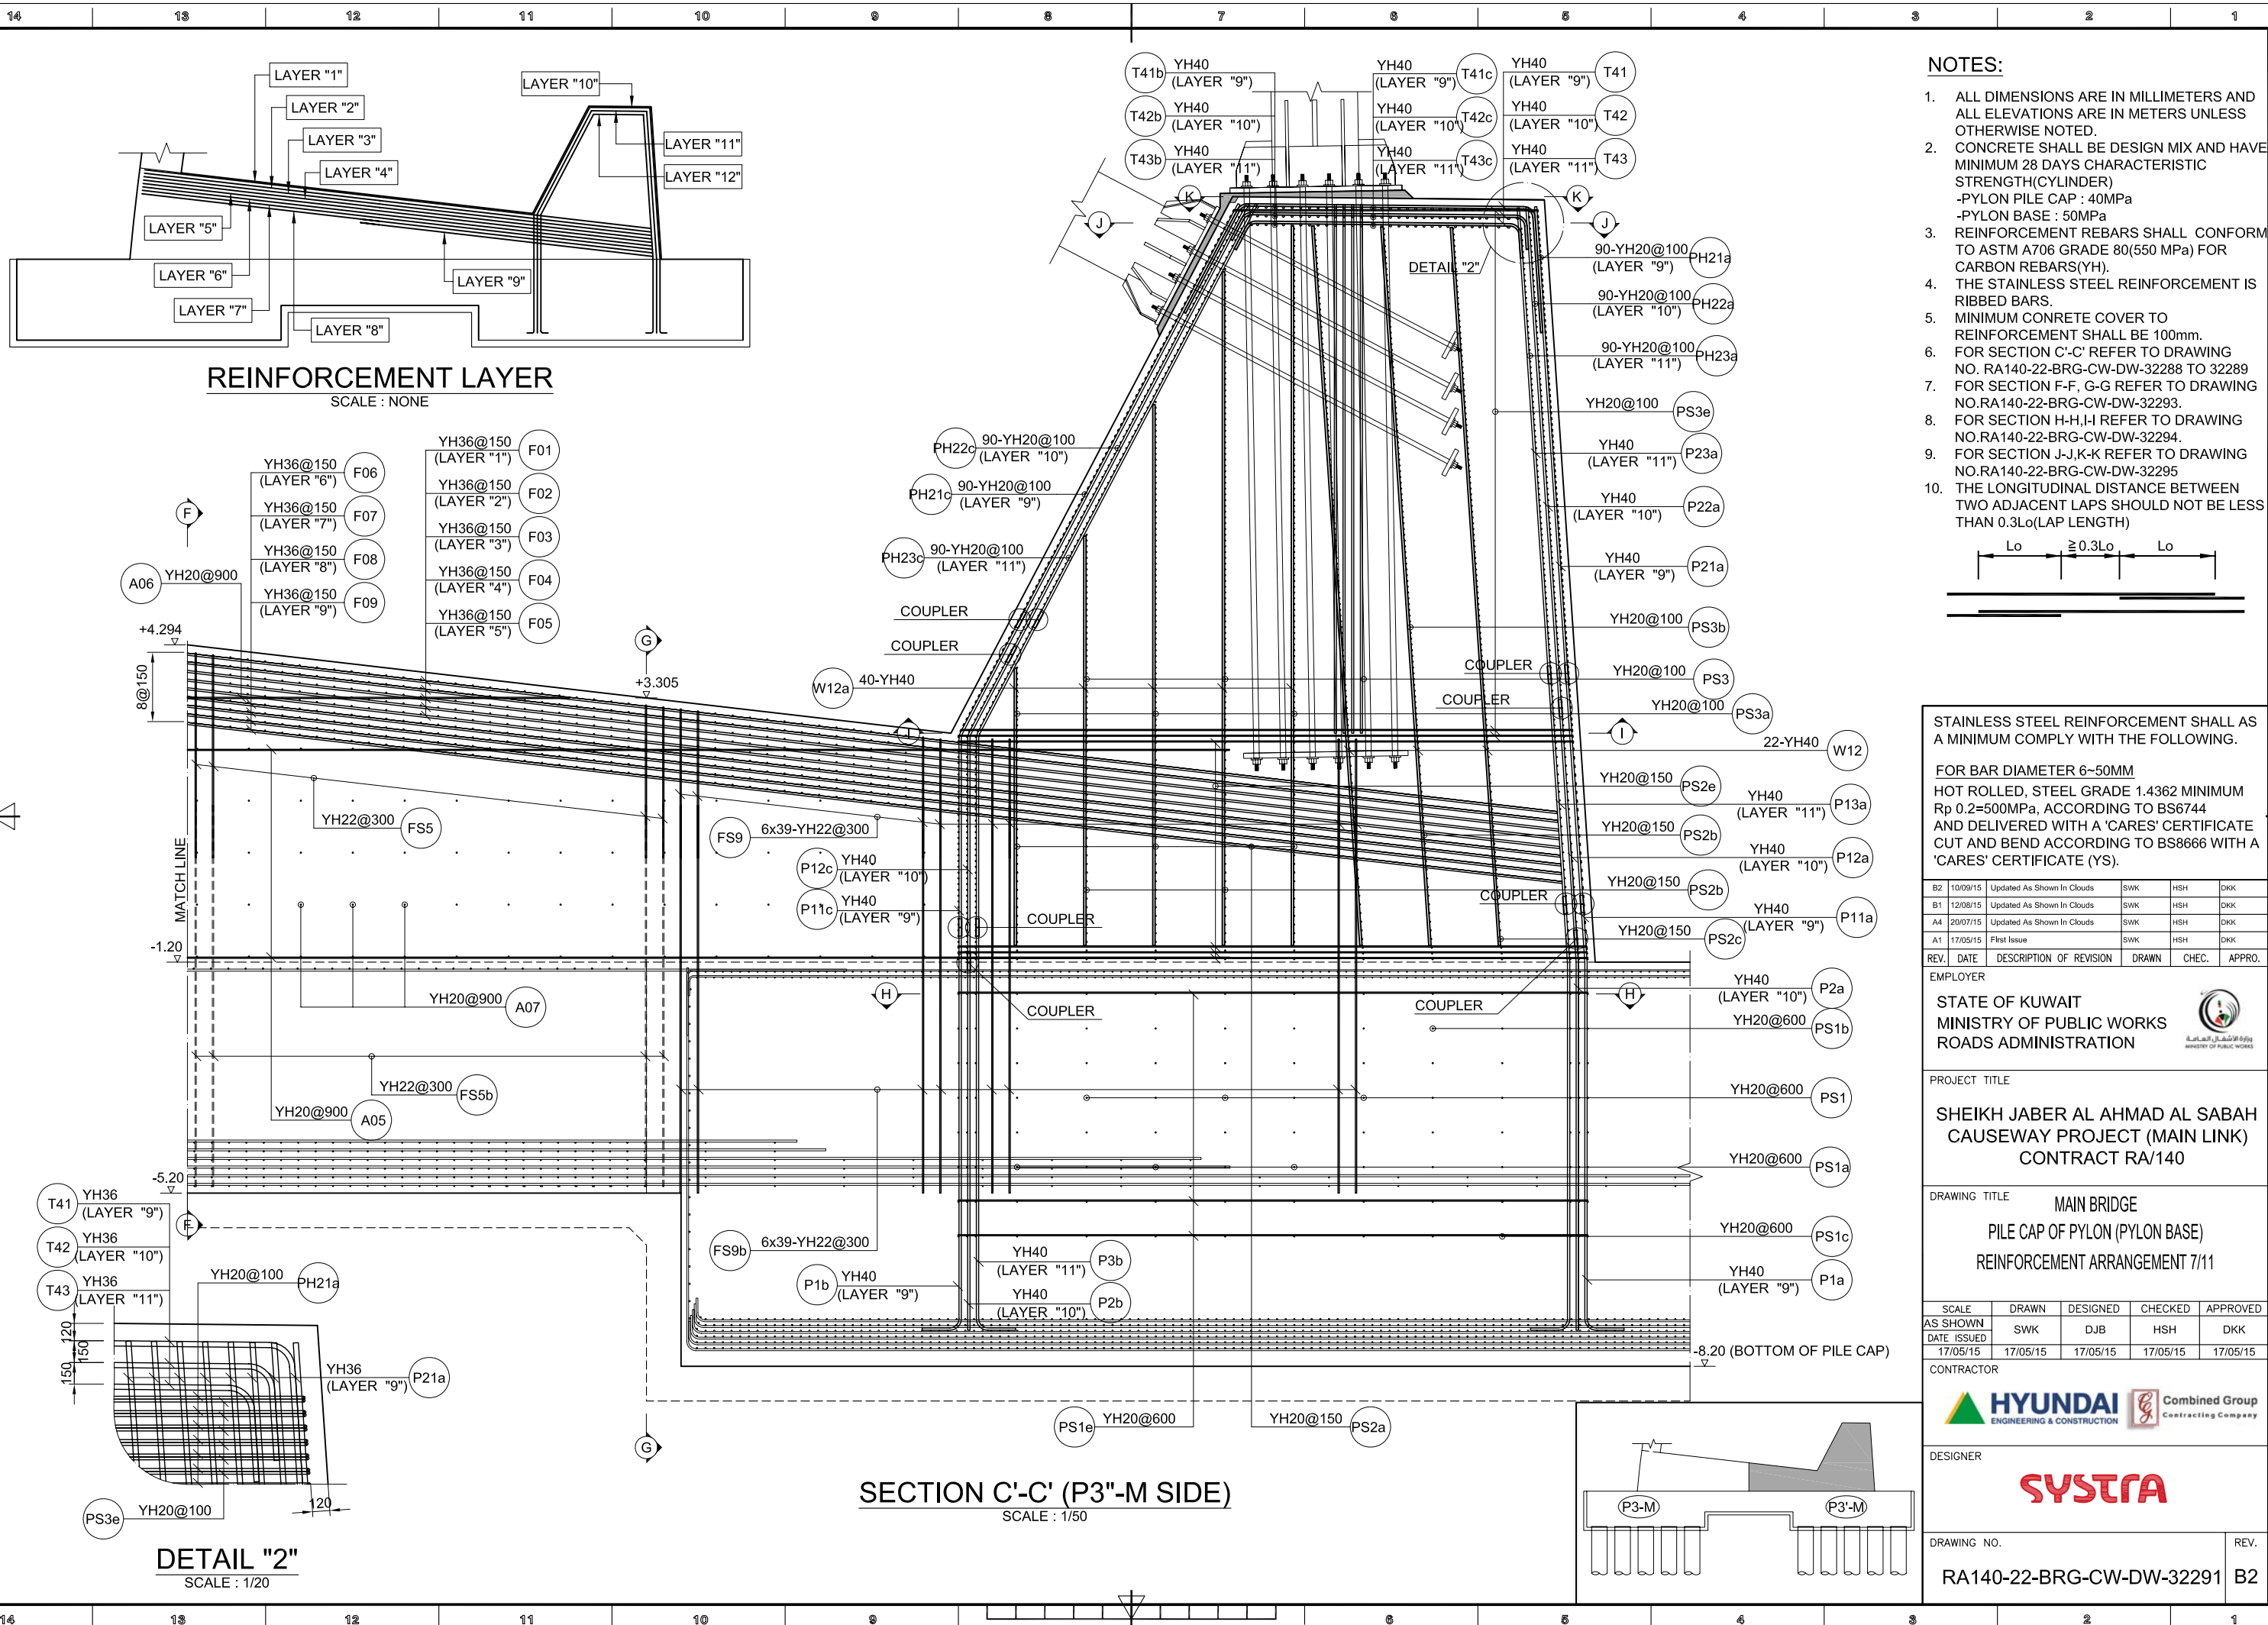

NOTES:

- ALL DIMENSIONS ARE IN MILLIMETERS AND ALL ELEVATIONS ARE IN METERS UNLESS OTHERWISE NOTED.
- CONCRETE SHALL BE DESIGN MIX AND HAVE MINIMUM 28 DAYS CHARACTERISTIC STRENGTH(CYLINDER)
-PYLON PILE CAP : 40MPa
-PYLON BASE : 50MPa
- REINFORCEMENT REBARS SHALL CONFORM TO ASTM A706 GRADE 80(550 MPa) FOR CARBON REBARS(YH).
- THE STAINLESS STEEL REINFORCEMENT IS RIBBED BARS.
- MINIMUM CONCRETE COVER TO REINFORCEMENT SHALL BE 100mm.
- FOR SECTION C'-C' REFER TO DRAWING NO. RA140-22-BRG-CW-DW-32288 TO 32289
- FOR SECTION F-F, G-G REFER TO DRAWING NO.RA140-22-BRG-CW-DW-32293.
- FOR SECTION H-H,I-I REFER TO DRAWING NO.RA140-22-BRG-CW-DW-32294.
- FOR SECTION J-J,K-K REFER TO DRAWING NO.RA140-22-BRG-CW-DW-32295
- THE LONGITUDINAL DISTANCE BETWEEN TWO ADJACENT LAPS SHOULD NOT BE LESS THAN 0.3Lo(LAP LENGTH)

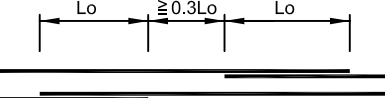

STAINLESS STEEL REINFORCEMENT SHALL AS A MINIMUM COMPLY WITH THE FOLLOWING.

FOR BAR DIAMETER 6~50MM
HOT ROLLED, STEEL GRADE 1.4362 MINIMUM Rp 0.2=500MPa, ACCORDING TO BS6744 AND DELIVERED WITH A 'CARES' CERTIFICATE CUT AND BEND ACCORDING TO BS8666 WITH A 'CARES' CERTIFICATE (YS).

B2	10/09/15	Updated As Shown In Clouds	SWK	HSK	DKK
B1	12/08/15	Updated As Shown In Clouds	SWK	HSK	DKK
A4	20/07/15	Updated As Shown In Clouds	SWK	HSK	DKK
A1	17/05/15	First Issue	SWK	HSK	DKK
REV.	DATE	DESCRIPTION OF REVISION	DRAWN	CHEC.	APPRO.

EMPLOYER

STATE OF KUWAIT
MINISTRY OF PUBLIC WORKS
ROADS ADMINISTRATION



PROJECT TITLE

SHEIKH JABER AL AHMAD AL SABAH
CAUSEWAY PROJECT (MAIN LINK)
CONTRACT RA/140

DRAWING TITLE

MAIN BRIDGE
PILE CAP OF PYLON (PYLON BASE)
REINFORCEMENT ARRANGEMENT 7/11

SCALE	DRAWN	DESIGNED	CHECKED	APPROVED
AS SHOWN	SWK	DJB	HSK	DKK
DATE ISSUED	17/05/15	17/05/15	17/05/15	17/05/15

CONTRACTOR



DESIGNER


SYSTRA

DRAWING NO.


RA140-22-BRG-CW-DW-32291 B2

REV.

A

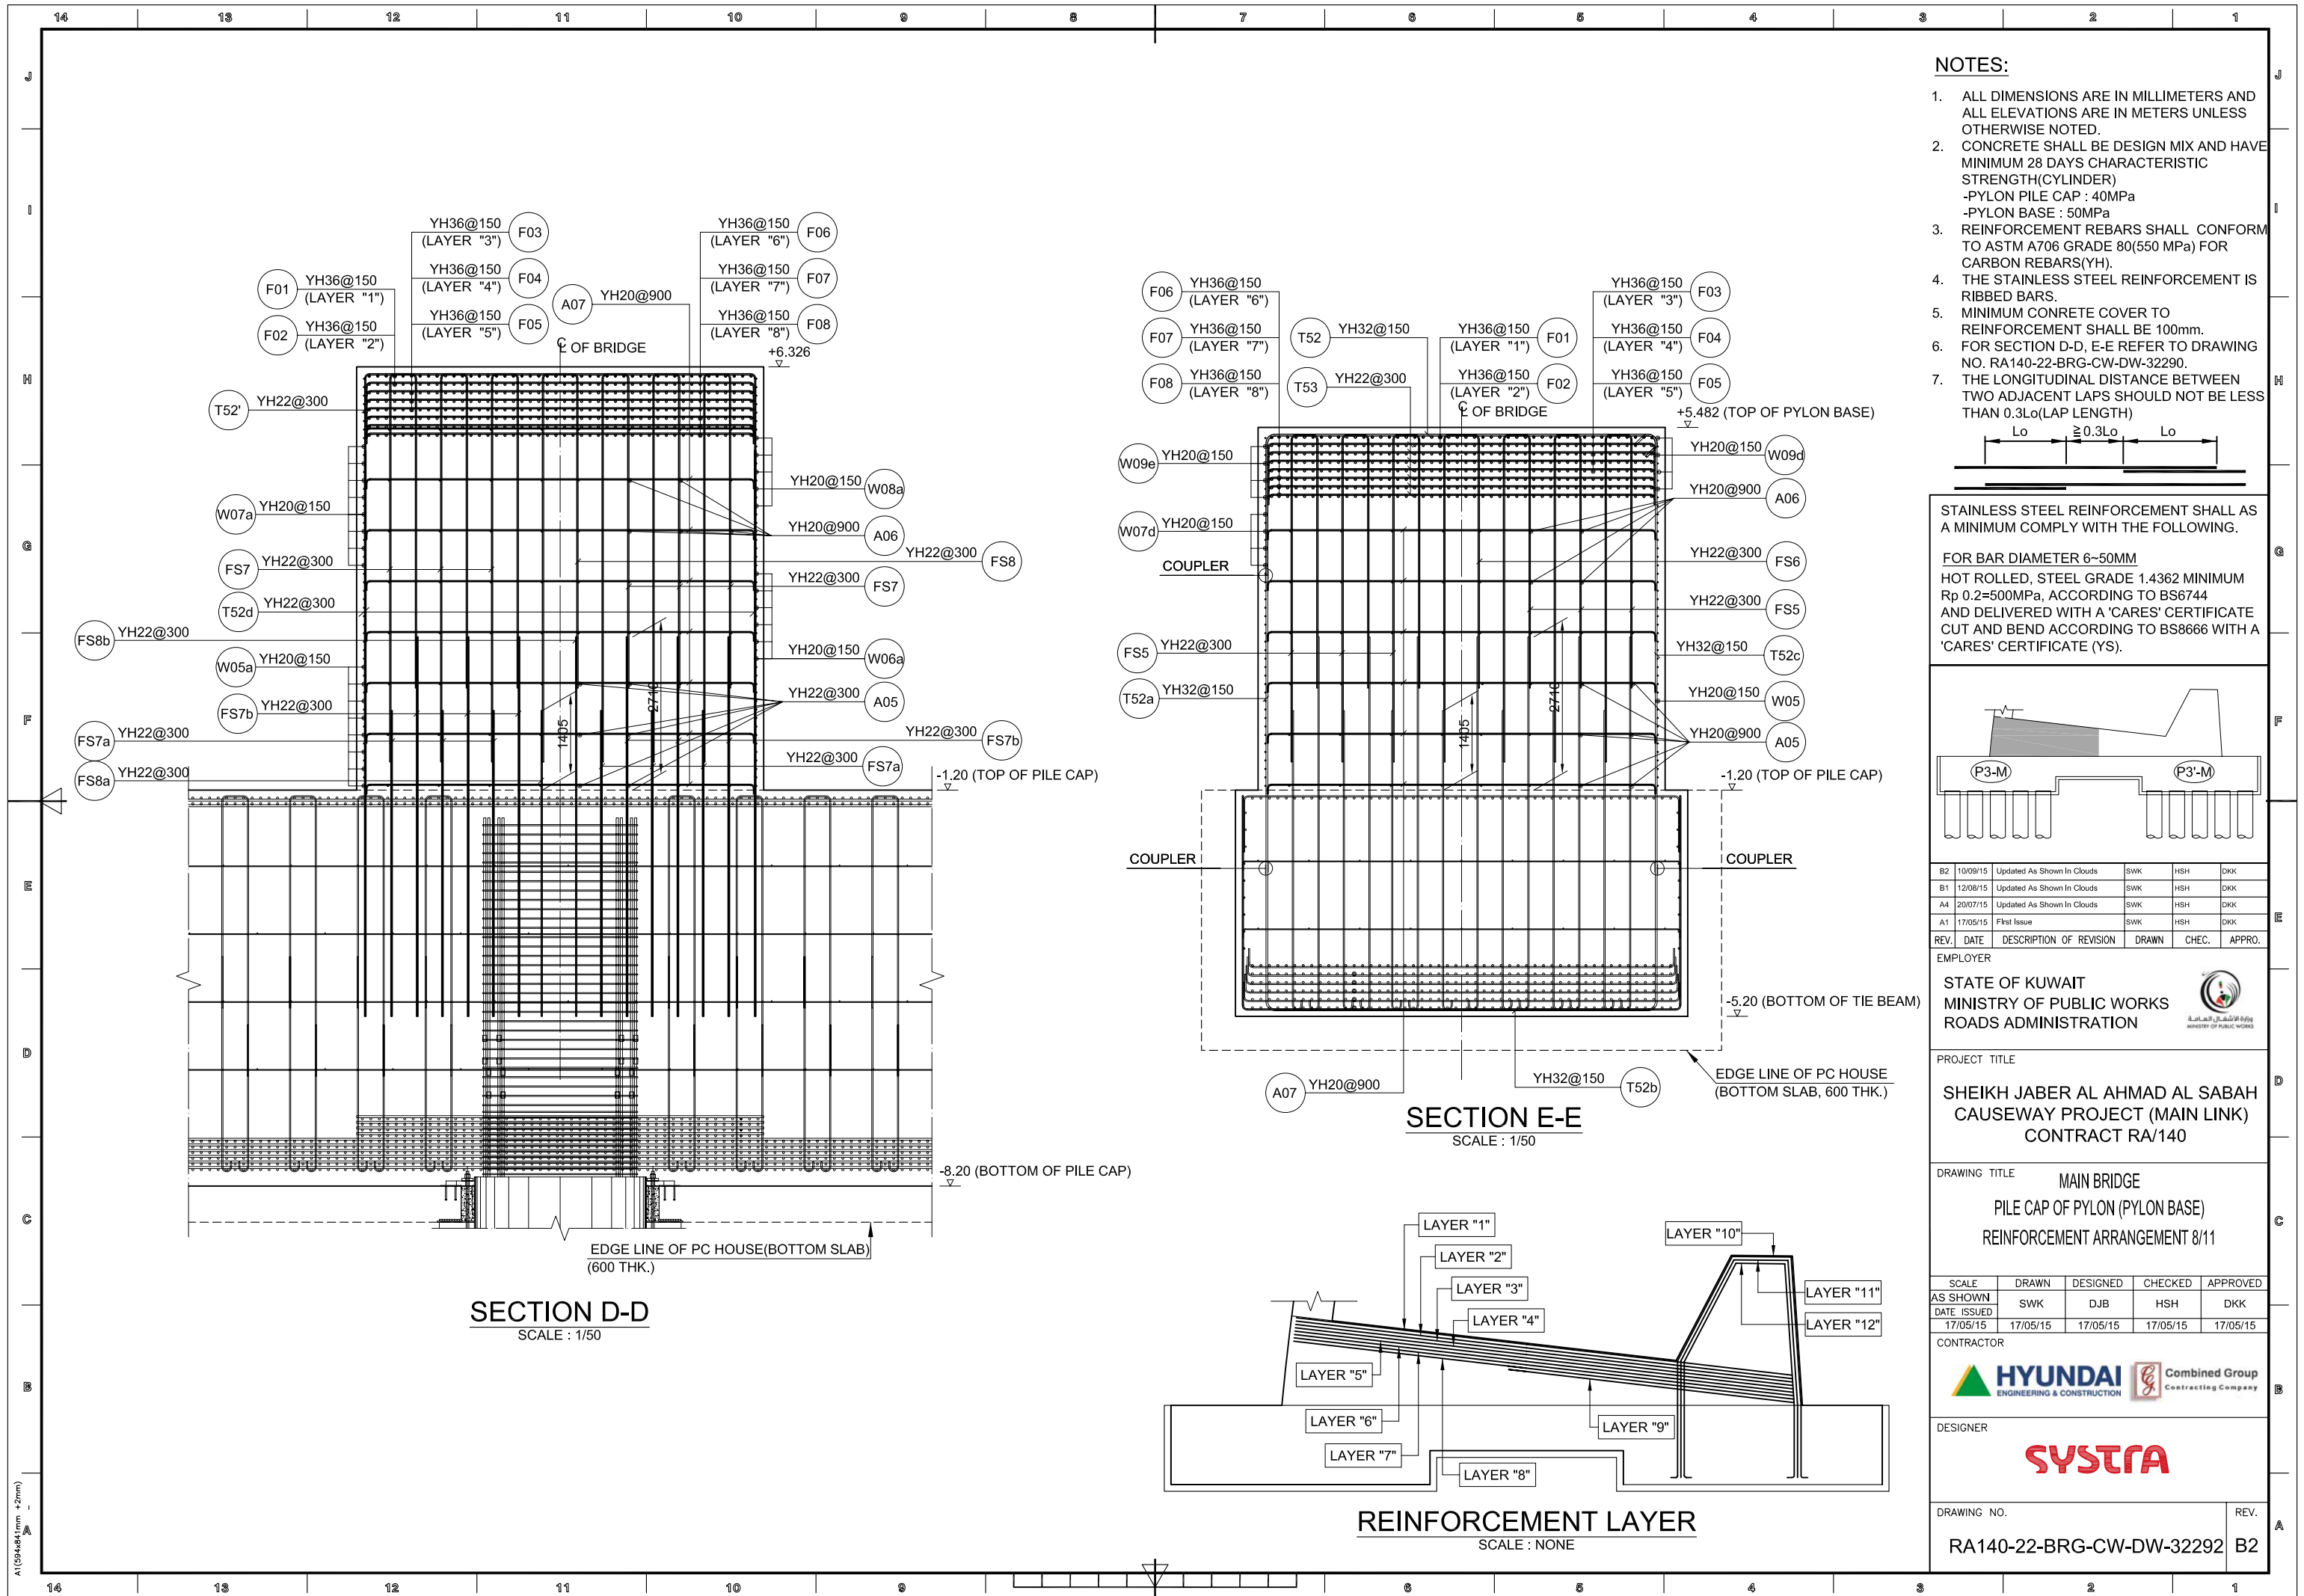


- NOTES:**
- ALL DIMENSIONS ARE IN MILLIMETERS AND ALL ELEVATIONS ARE IN METERS UNLESS OTHERWISE NOTED.
 - CONCRETE SHALL BE DESIGN MIX AND HAVE MINIMUM 28 DAYS CHARACTERISTIC STRENGTH(CYLINDER)
-PYLON PILE CAP : 40MPa
-PYLON BASE : 50MPa
 - REINFORCEMENT REBARS SHALL CONFORM TO ASTM A706 GRADE 80(550 MPa) FOR CARBON REBARS(YH).
 - THE STAINLESS STEEL REINFORCEMENT IS RIBBED BARS.
 - MINIMUM CONCRETE COVER TO REINFORCEMENT SHALL BE 100mm.
 - FOR SECTION D-D, E-E REFER TO DRAWING NO. RA140-22-BRG-CW-DW-32290.
 - THE LONGITUDINAL DISTANCE BETWEEN TWO ADJACENT LAPS SHOULD NOT BE LESS THAN 0.3Lo(LAP LENGTH)

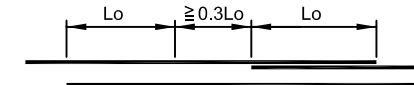

STAINLESS STEEL REINFORCEMENT SHALL AS A MINIMUM COMPLY WITH THE FOLLOWING.

FOR BAR DIAMETER 6-50MM
HOT ROLLED, STEEL GRADE 1.4362 MINIMUM Rp 0.2=500MPa, ACCORDING TO BS6744 AND DELIVERED WITH A 'CARES' CERTIFICATE CUT AND BEND ACCORDING TO BS8666 WITH A 'CARES' CERTIFICATE (YS).

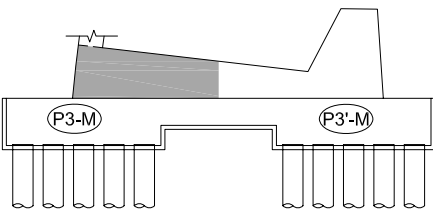

B2	10/09/15	Updated As Shown In Clouds	SWK	HSK	DKK
B1	12/08/15	Updated As Shown In Clouds	SWK	HSK	DKK
A4	20/07/15	Updated As Shown In Clouds	SWK	HSK	DKK
A1	17/05/15	First Issue	SWK	HSK	DKK
REV.	DATE	DESCRIPTION OF REVISION	DRAWN	CHEC.	APPRO.

EMPLOYER
STATE OF KUWAIT
MINISTRY OF PUBLIC WORKS
ROADS ADMINISTRATION

PROJECT TITLE
SHEIKH JABER AL AHMAD AL SABAH CAUSEWAY PROJECT (MAIN LINK)
CONTRACT RA/140

DRAWING TITLE
MAIN BRIDGE
PILE CAP OF PYLON (PYLON BASE)
REINFORCEMENT ARRANGEMENT 8/11


SCALE	DRAWN	DESIGNED	CHECKED	APPROVED
AS SHOWN	SWK	DJB	HSK	DKK
DATE ISSUED	17/05/15	17/05/15	17/05/15	17/05/15

CONTRACTOR
HYUNDAI ENGINEERING & CONSTRUCTION
Combined Group Contracting Company

DESIGNER
SYSTRA


DRAWING NO.
RA140-22-BRG-CW-DW-32292

REV.
B2

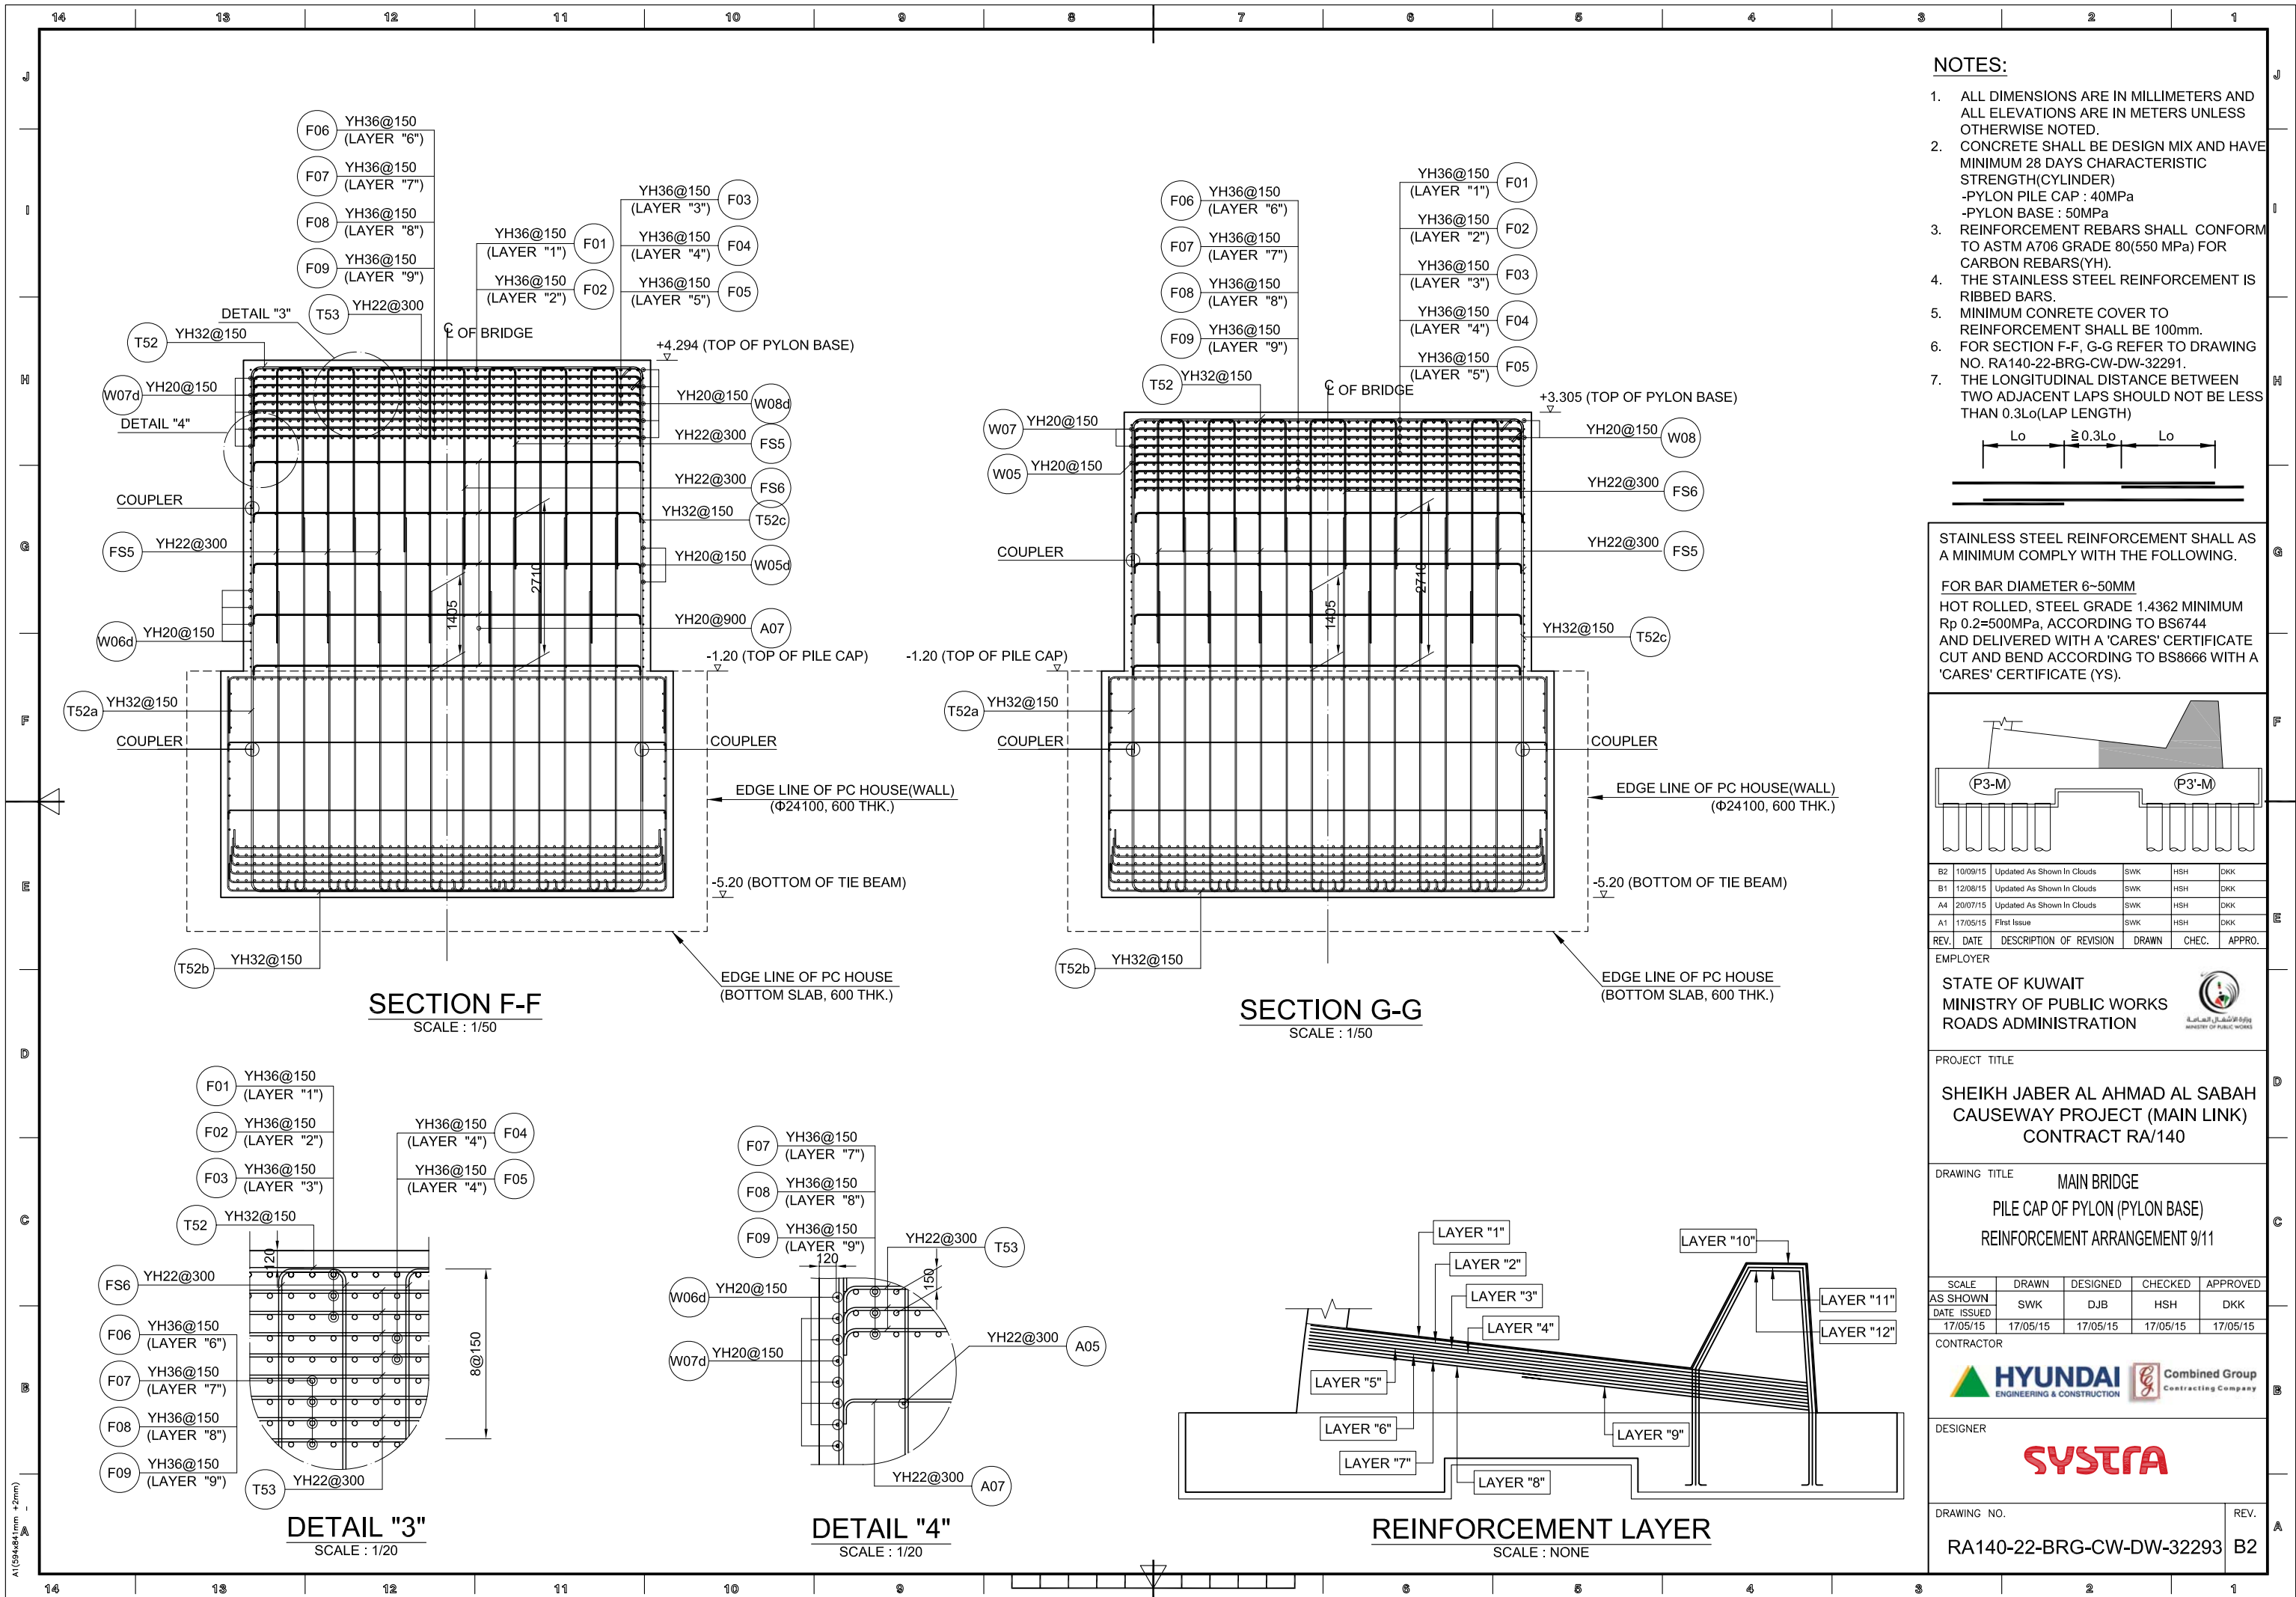


NOTES:

- ALL DIMENSIONS ARE IN MILLIMETERS AND ALL ELEVATIONS ARE IN METERS UNLESS OTHERWISE NOTED.
- CONCRETE SHALL BE DESIGN MIX AND HAVE MINIMUM 28 DAYS CHARACTERISTIC STRENGTH(CYLINDER)
-PYLON PILE CAP : 40MPa
-PYLON BASE : 50MPa
- REINFORCEMENT REBARS SHALL CONFORM TO ASTM A706 GRADE 80(550 MPa) FOR CARBON REBARS(YH).
- THE STAINLESS STEEL REINFORCEMENT IS RIBBED BARS.
- MINIMUM CONCRETE COVER TO REINFORCEMENT SHALL BE 100mm.
- FOR SECTION F-F, G-G REFER TO DRAWING NO. RA140-22-BRG-CW-DW-32291.
- THE LONGITUDINAL DISTANCE BETWEEN TWO ADJACENT LAPS SHOULD NOT BE LESS THAN 0.3Lo(LAP LENGTH)

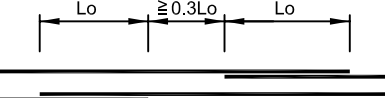

STAINLESS STEEL REINFORCEMENT SHALL AS A MINIMUM COMPLY WITH THE FOLLOWING.

FOR BAR DIAMETER 6-50MM
HOT ROLLED, STEEL GRADE 1.4362 MINIMUM
Rp 0.2=500MPa, ACCORDING TO BS6744
AND DELIVERED WITH A 'CARES' CERTIFICATE
CUT AND BEND ACCORDING TO BS8666 WITH A 'CARES' CERTIFICATE (YS).

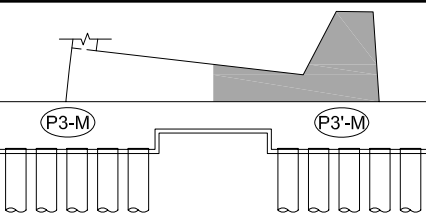

B2	10/09/15	Updated As Shown In Clouds	SWK	HSK	DKK
B1	12/08/15	Updated As Shown In Clouds	SWK	HSK	DKK
A4	20/07/15	Updated As Shown In Clouds	SWK	HSK	DKK
A1	17/05/15	First Issue	SWK	HSK	DKK
REV.	DATE	DESCRIPTION OF REVISION	DRAWN	CHEC.	APPRO.

EMPLOYER

STATE OF KUWAIT
MINISTRY OF PUBLIC WORKS
ROADS ADMINISTRATION



PROJECT TITLE

SHEIKH JABER AL AHMAD AL SABAH
CAUSEWAY PROJECT (MAIN LINK)
CONTRACT RA/140

DRAWING TITLE

MAIN BRIDGE
PILE CAP OF PYLON (PYLON BASE)
REINFORCEMENT ARRANGEMENT 9/11

SCALE	DRAWN	DESIGNED	CHECKED	APPROVED
AS SHOWN	SWK	DJB	HSK	DKK
DATE ISSUED	17/05/15	17/05/15	17/05/15	17/05/15

CONTRACTOR



DESIGNER


SYSTRA

DRAWING NO.

RA140-22-BRG-CW-DW-32293


REV.

B2

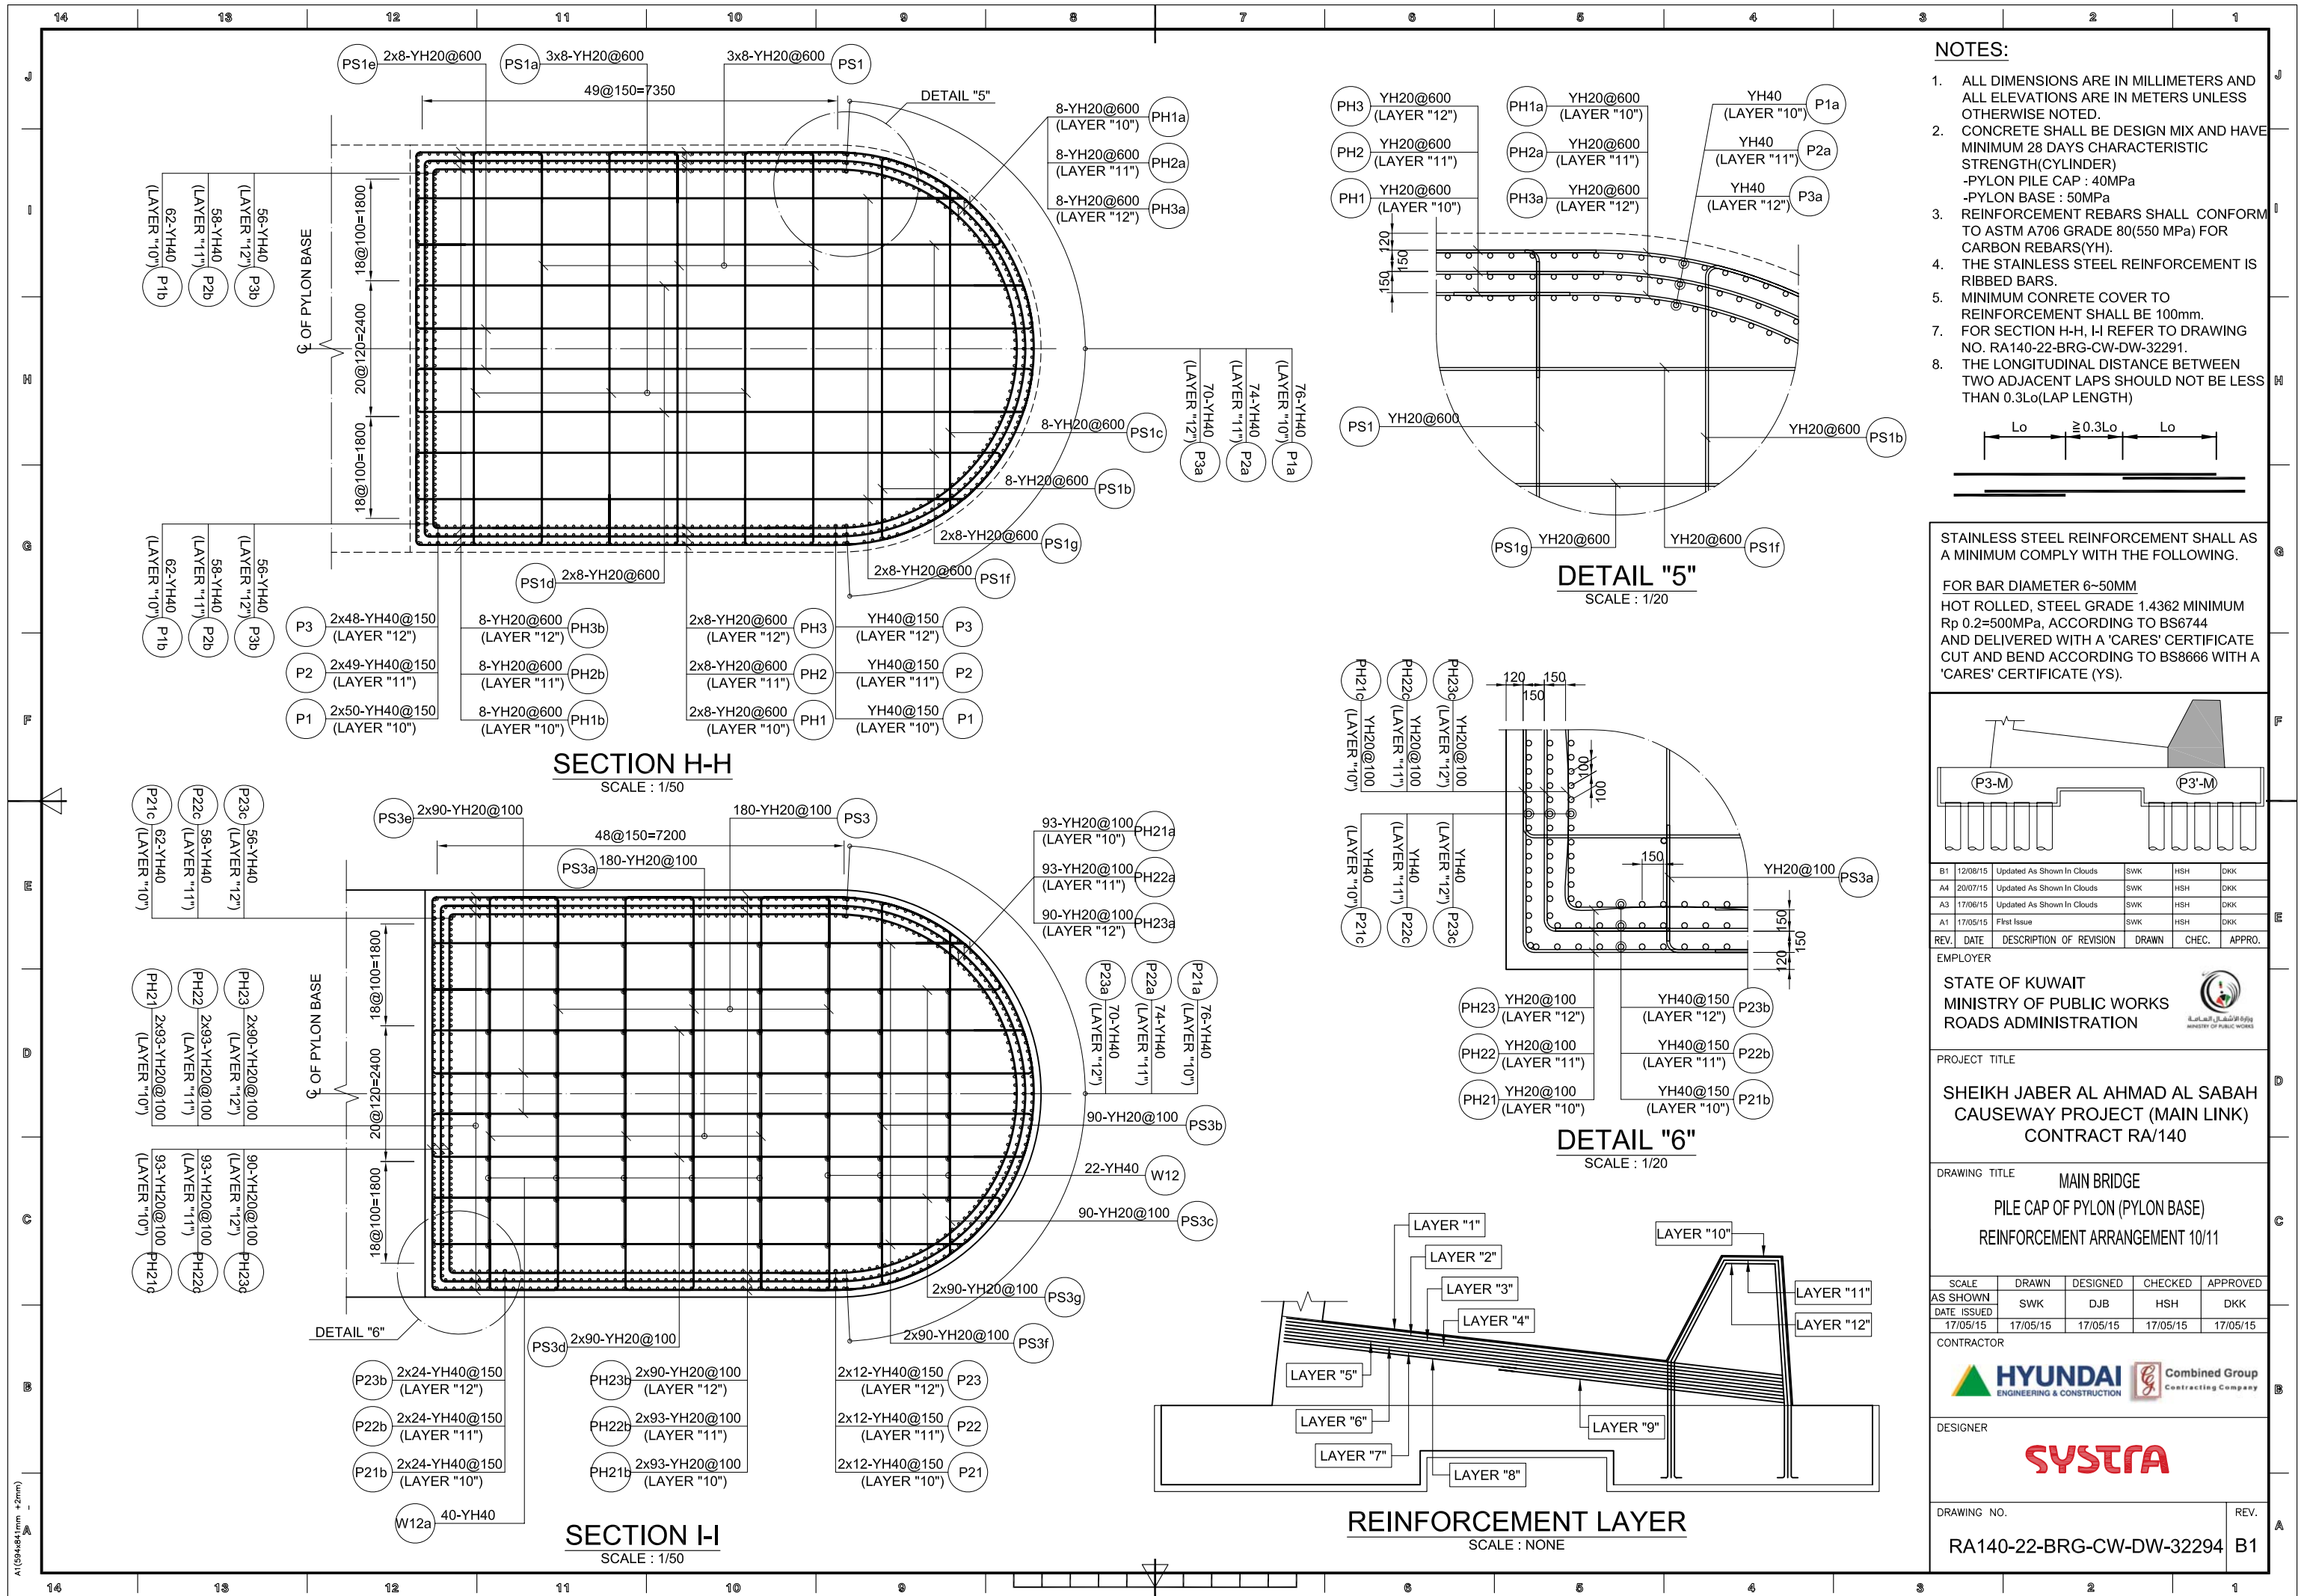


NOTES:

- ALL DIMENSIONS ARE IN MILLIMETERS AND ALL ELEVATIONS ARE IN METERS UNLESS OTHERWISE NOTED.
- CONCRETE SHALL BE DESIGN MIX AND HAVE MINIMUM 28 DAYS CHARACTERISTIC STRENGTH(CYLINDER)
-PYLON PILE CAP : 40MPa
-PYLON BASE : 50MPa
- REINFORCEMENT REBARS SHALL CONFORM TO ASTM A706 GRADE 80(550 MPa) FOR CARBON REBARS(YH).
- THE STAINLESS STEEL REINFORCEMENT IS RIBBED BARS.
- MINIMUM CONCRETE COVER TO REINFORCEMENT SHALL BE 100mm.
- FOR SECTION H-H, I-I REFER TO DRAWING NO. RA140-22-BRG-CW-DW-32291.
- THE LONGITUDINAL DISTANCE BETWEEN TWO ADJACENT LAPS SHOULD NOT BE LESS THAN 0.3Lo(LAP LENGTH)

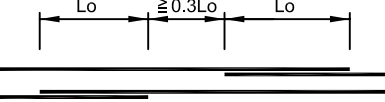

STAINLESS STEEL REINFORCEMENT SHALL AS A MINIMUM COMPLY WITH THE FOLLOWING.

FOR BAR DIAMETER 6-50MM
HOT ROLLED, STEEL GRADE 1.4362 MINIMUM
Rp 0.2=500MPa, ACCORDING TO BS6744
AND DELIVERED WITH A 'CARES' CERTIFICATE
CUT AND BEND ACCORDING TO BS8666 WITH A
'CARES' CERTIFICATE (YS).

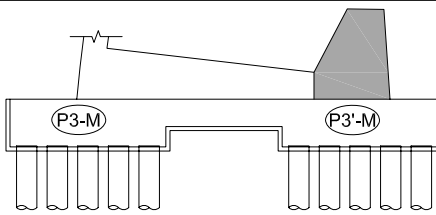

B1	12/08/15	Updated As Shown In Clouds	SWK	HSK	DKK
A4	20/07/15	Updated As Shown In Clouds	SWK	HSK	DKK
A3	17/06/15	Updated As Shown In Clouds	SWK	HSK	DKK
A1	17/05/15	First Issue	SWK	HSK	DKK

REV. DATE DESCRIPTION OF REVISION DRAWN CHCK. APPRO.

EMPLOYER

STATE OF KUWAIT
MINISTRY OF PUBLIC WORKS
ROADS ADMINISTRATION

PROJECT TITLE

SHEIKH JABER AL AHMAD AL SABAH
CAUSEWAY PROJECT (MAIN LINK)
CONTRACT RA/140

DRAWING TITLE

MAIN BRIDGE
PILE CAP OF PYLON (PYLON BASE)
REINFORCEMENT ARRANGEMENT 10/11

SCALE	DRAWN	DESIGNED	CHECKED	APPROVED
AS SHOWN	SWK	DJB	HSK	DKK
DATE ISSUED	17/05/15	17/05/15	17/05/15	17/05/15

CONTRACTOR

HYUNDAI ENGINEERING & CONSTRUCTION
Combined Group Contracting Company


DESIGNER

SYSTRA

DRAWING NO.


RA140-22-BRG-CW-DW-32294 B1

REV.

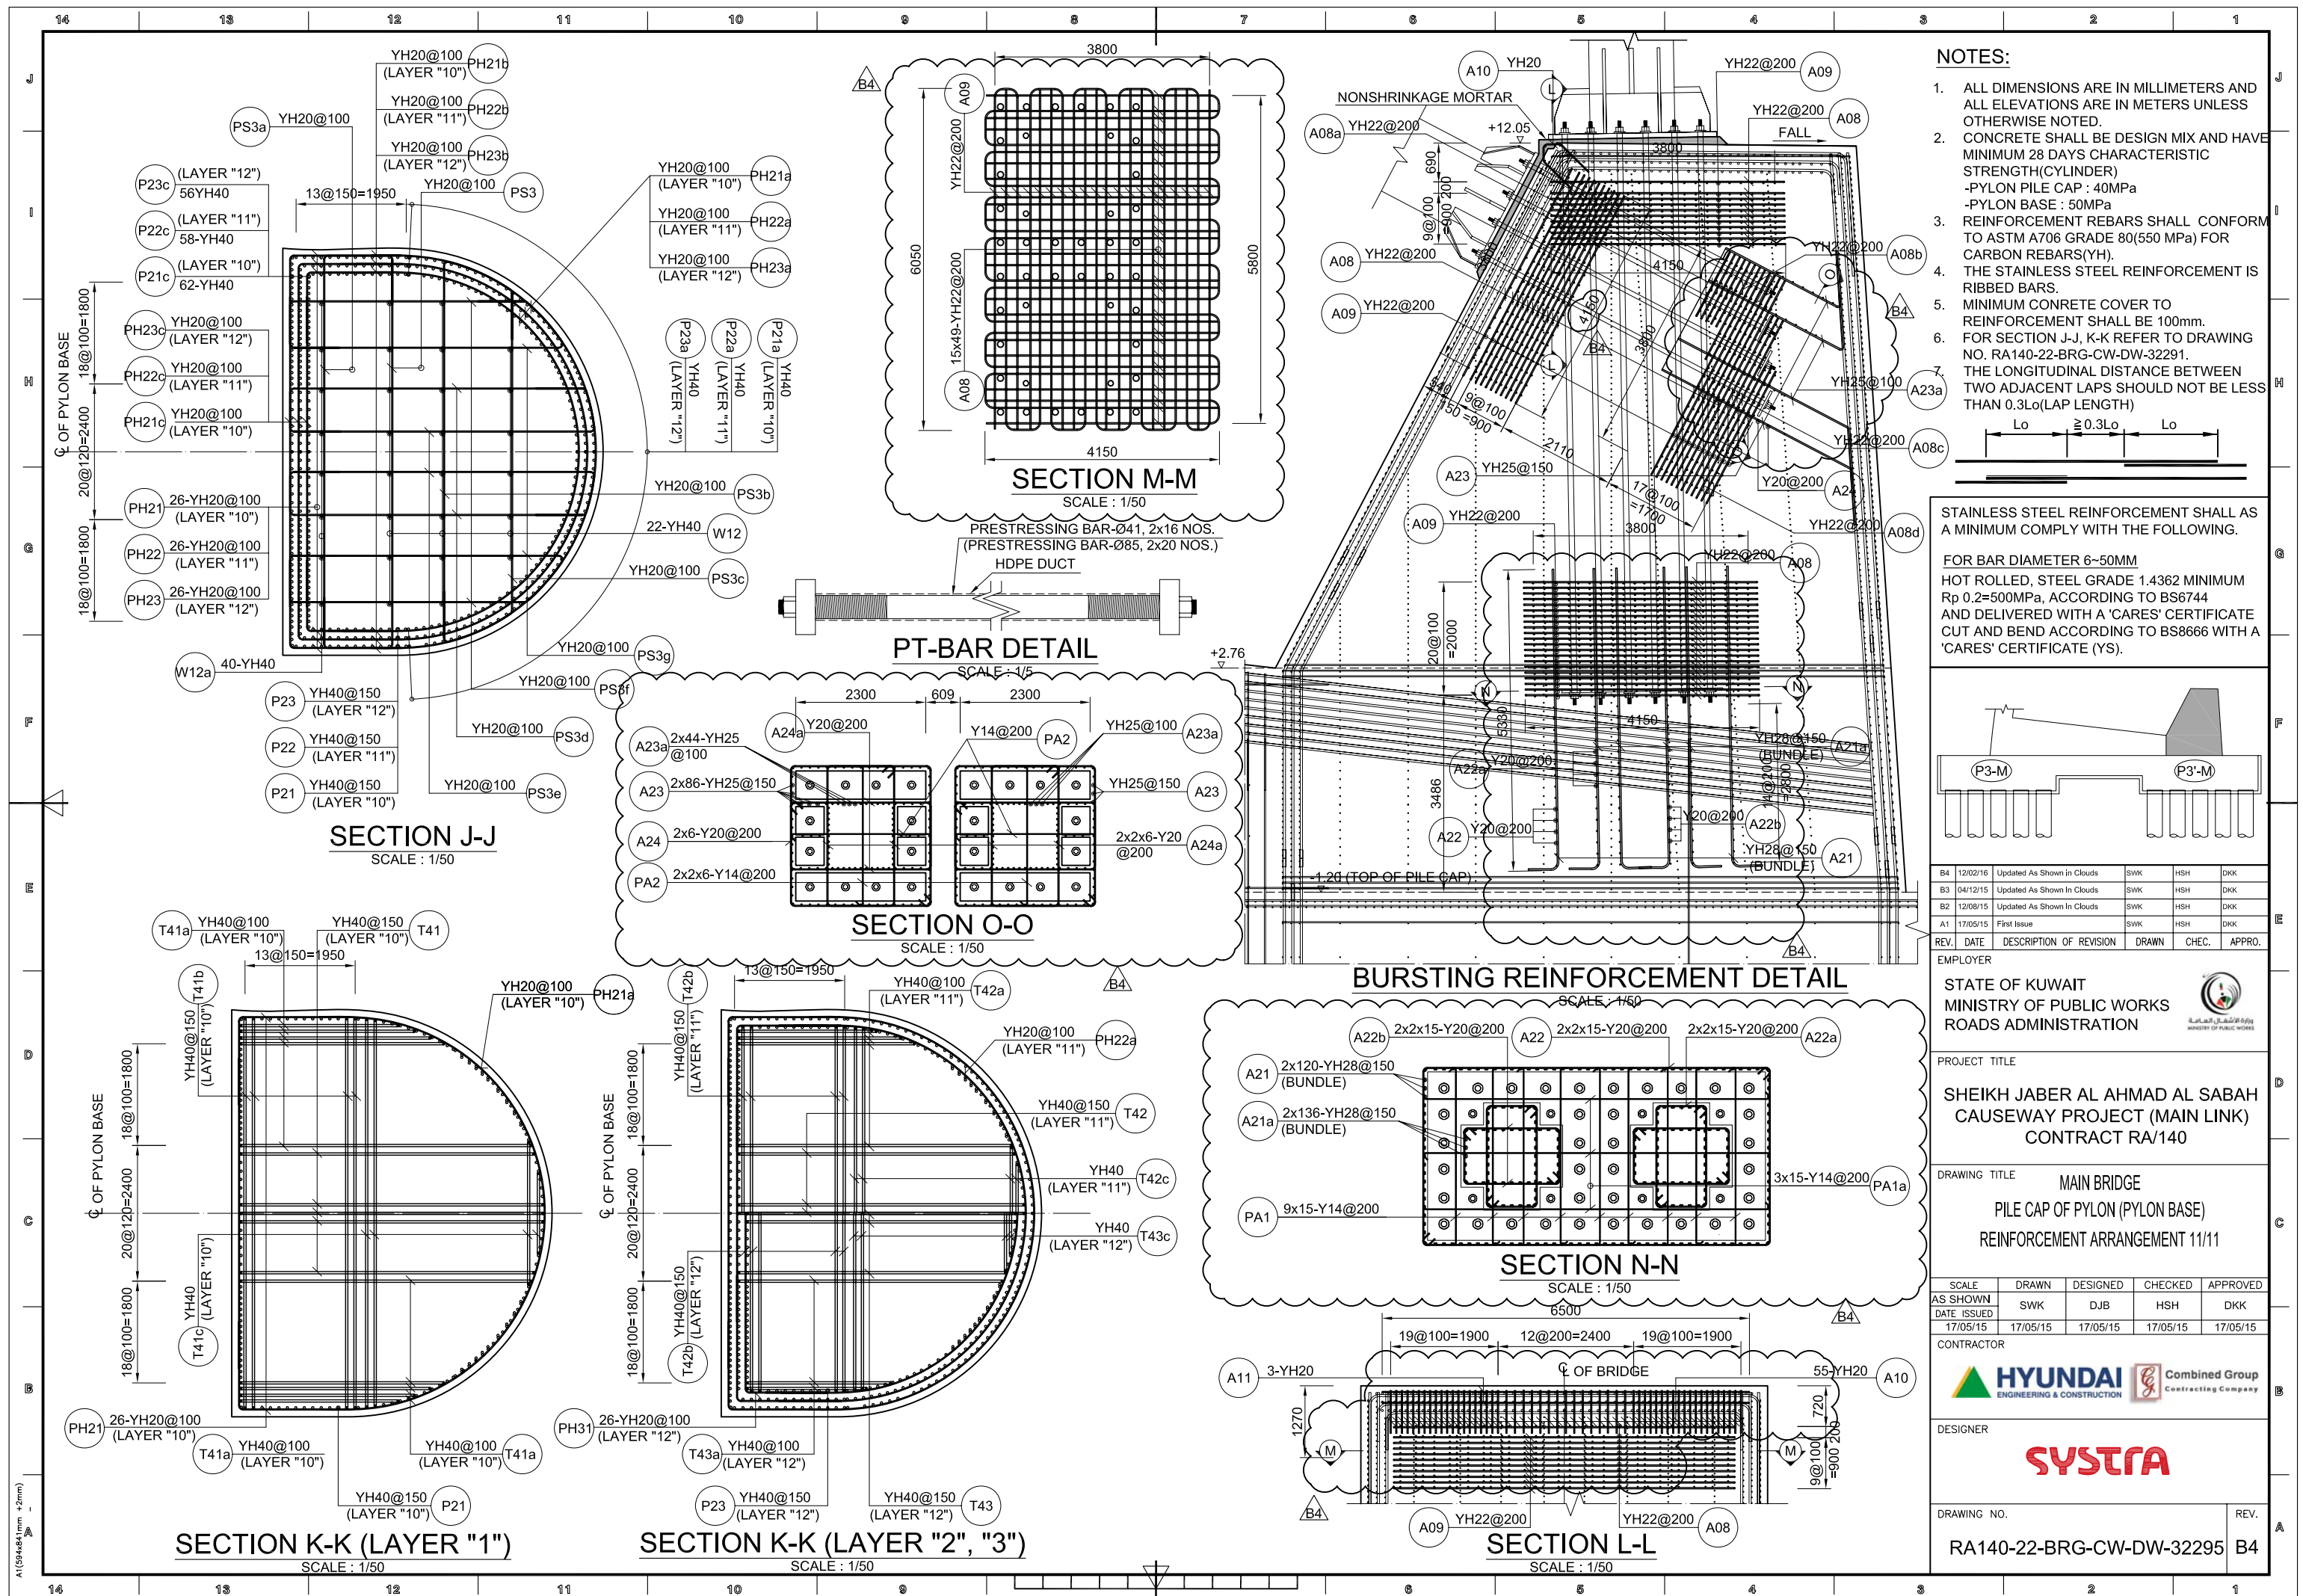


NOTES:

1. ALL DIMENSIONS ARE IN MILLIMETERS AND ALL ELEVATIONS ARE IN METERS UNLESS OTHERWISE NOTED.
2. CONCRETE SHALL BE DESIGN MIX AND HAVE MINIMUM 28 DAYS CHARACTERISTIC STRENGTH(CYLINDER)
-PYLON PILE CAP : 40MPa
-PYLON BASE : 50MPa
3. REINFORCEMENT REBARS SHALL CONFORM TO ASTM A706 GRADE 80(550 MPa) FOR CARBON REBARS(YH).
4. THE STAINLESS STEEL REINFORCEMENT IS RIBBED BARS.
5. MINIMUM CONCRETE COVER TO REINFORCEMENT SHALL BE 100mm.
6. FOR SECTION J-J, K-K REFER TO DRAWING NO. RA140-22-BRG-CW-DW-32291.
7. THE LONGITUDINAL DISTANCE BETWEEN TWO ADJACENT LAPS SHOULD NOT BE LESS THAN 0.3Lo(LAP LENGTH)

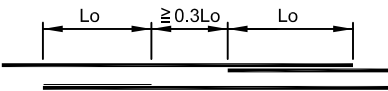

STAINLESS STEEL REINFORCEMENT SHALL AS A MINIMUM COMPLY WITH THE FOLLOWING.

FOR BAR DIAMETER 6-50MM
HOT ROLLED, STEEL GRADE 1.4362 MINIMUM
Rp 0.2=500MPa, ACCORDING TO BS6744
AND DELIVERED WITH A 'CARES' CERTIFICATE
CUT AND BEND ACCORDING TO BS8666 WITH A
'CARES' CERTIFICATE (YS).

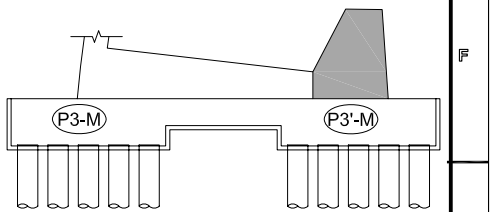

B4	12/02/16	Updated As Shown In Clouds	SWK	HSK	DKK
B3	04/12/15	Updated As Shown In Clouds	SWK	HSK	DKK
B2	12/08/15	Updated As Shown In Clouds	SWK	HSK	DKK
A1	17/05/15	First Issue	SWK	HSK	DKK
REV.	DATE	DESCRIPTION OF REVISION	DRAWN	CHEC.	APPRO.

EMPLOYER
STATE OF KUWAIT
MINISTRY OF PUBLIC WORKS
ROADS ADMINISTRATION

PROJECT TITLE
SHEIKH JABER AL AHMAD AL SABAH
CAUSEWAY PROJECT (MAIN LINK)
CONTRACT RA/140


DRAWING TITLE
MAIN BRIDGE
PILE CAP OF PYLON (PYLON BASE)
REINFORCEMENT ARRANGEMENT 11/11

SCALE	DRAWN	DESIGNED	CHECKED	APPROVED
AS SHOWN	SWK	DJB	HSK	DKK
DATE ISSUED	17/05/15	17/05/15	17/05/15	17/05/15

CONTRACTOR
HYUNDAI ENGINEERING & CONSTRUCTION
Combined Group Contracting Company

DESIGNER
SYSTRA

DRAWING NO.
RA140-22-BRG-CW-DW-32295
REV.
B4

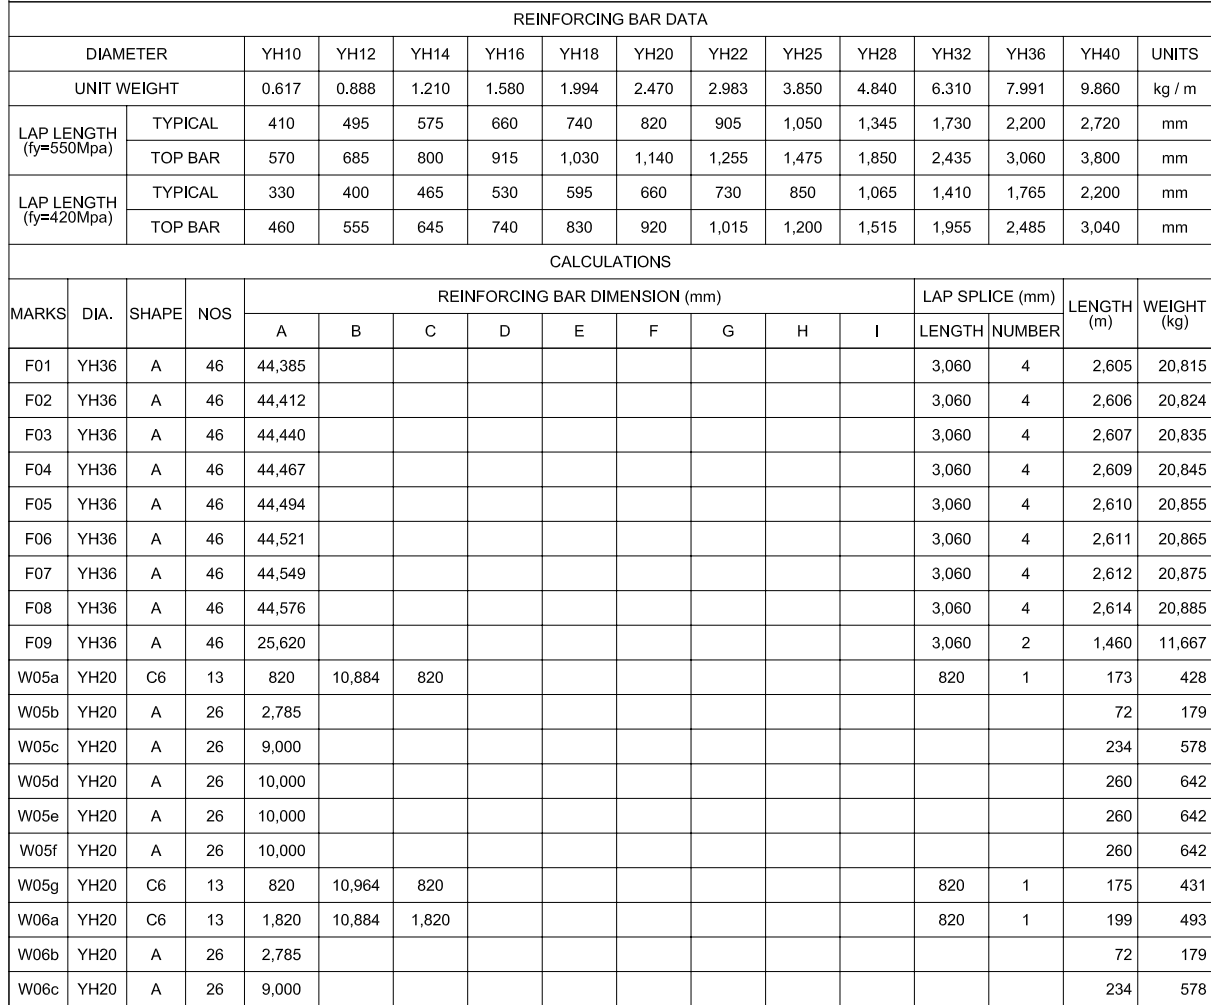


MARKS	DIA.	SHAPE	NOS	REINFORCING BAR DIMENSION (mm)									LAP SPLICE (mm)		LENGTH (m)	WEIGHT (kg)
				A	B	C	D	E	F	G	H	I	LENGTH	NUMBER		
W06d	YH20	A	26	10,000											260	642
W06e	YH20	A	26	10,000											260	642
W06f	YH20	A	26	8,000											208	514
W06g	YH20	C6	13	1,820	10,964	1,820							820	1	201	495
W07a	YH20	C6	12	820	10,884	820							820	1	160	396
W07b	YH20	A	22	2,397											53	130
W07c	YH20	A	16	9,000											144	356
W07d	YH20	A	8	10,000											80	198
W07e	YH20	A	2	10,000											20	49
W08a	YH20	C6	11	1,820	10,884	1,820							820	1	169	417
W08b	YH20	A	20	2,397											48	118
W08c	YH20	A	14	9,000											126	311
W08d	YH20	A	6	10,000											60	148
W09a	YH20	A	2	1,889											4	9
W09b	YH20	A	6	4,499											27	67
W09c	YH20	A	6	4,813											29	71
W09d	YH20	A	8	5,699											46	113
W09e	YH20	A	8	5,393											43	107
W09f	YH20	A	6	5,588											34	83
W09g	YH20	A	6	5,286											32	78
W09h	YH20	A	2	1,294											3	6
A05	YH20	A	40	37,439									820	3	1,596	3,942
A06	YH20	A	24	15,740									820	1	397	982
A07	YH20	C	202	100	6,896	100									1,433	3,540
T52	YH32	E6	116	6,928	384	2,500	339	192							1,200	7,571
T52'	YH22	C	70	2,500	6,938	2,500									836	2,493
T52d	YH22	A	62	9,565											593	1,769
T52e	YH22	A	78	6,769											528	1,575
T53	YH22	C	763	100	6,894	100									5,413	16,146
FS5	YH22	C	342	3,607	454	4,912									3,069	9,154
FS6	YH22	C	57	3,607	545	4,912									517	1,541
FS7	YH22	C	186	5,100	454	6,405									2,224	6,635
FS7a	YH22	A	186	5,405											1,005	2,999
FS7b	YH22	A	186	6,710											1,248	3,723
FS8	YH22	C	31	5,100	654	6,405							905	1	405	1,208
FS8a	YH22	A	31	5,405											168	500
FS8b	YH22	A	31	6,710											208	620
FS9	YH22	C	234	2,340	454	3,645									1,506	4,494
FS9a	YH22	A	234	5,405											1,265	3,773
FS9b	YH22	A	234	6,710											1,570	4,684
FS10	YH22	C	39	2,340	654	3,645									259	772
FS10a	YH22	A	39	5,405											211	629
FS10b	YH22	A	39	6,710											262	781
T41	YH36	C	15	2,200	5,346	2,200									146	1,168
T41a	YH36	C	44	2,200	4,045	2,200									372	2,969
T41b	YH36	C	14	2,200	6,924	2,200									159	1,267
T41c	YH36	C	22	2,200	4,346	2,200									192	1,538
T42	YH36	C	15	500	5,046	500									91	725
T42a	YH36	C	42	500	3,745	500									199	1,592
T42b	YH36	C	14	500	6,624	500									107	853
T42c	YH36	C	22	500	4,046	500									111	887
T43	YH36	C	15	500	4,746	500									86	689
T43a	YH36	C	40	500	3,445	500									178	1,421
T43b	YH36	C	14	500	6,324	500									103	819
T43c	YH36	C	22	500	3,746	500									104	834

B2	04/12/15	Updated As Shown In Clouds	SWK	HSB	DKK
B1	12/08/15	Updated As Shown In Clouds	SWK	HSB	DKK
A4	20/07/15	Updated As Shown In Clouds	SWK	HSB	DKK
A1	17/05/15	First Issue	SWK	HSB	DKK
REV.	DATE	DESCRIPTION OF REVISION	DRAWN	CHEC.	APPRO.

EMPLOYER

STATE OF KUWAIT
MINISTRY OF PUBLIC WORKS
ROADS ADMINISTRATION


وزارة الأشغال العامة
MINISTRY OF PUBLIC WORKS

PROJECT TITLE
SHEIKH JABER AL AHMAD AL SABAH CAUSEWAY PROJECT (MAIN LINK) CONTRACT RA/140

DRAWING TITLE	MAIN BRIDGE PILE CAP OF PYLON (PYLON BASE) BAR LIST 1/2
---------------	---

SCALE	DRAWN	DESIGNED	CHECKED	APPROVED
AS SHOWN	SWK	DJB	HSH	DKK
DATE ISSUED				
17/05/15	17/05/15	17/05/15	17/05/15	17/05/15

CONTRACTOR

 **HYUNDAI**
ENGINEERING & CONSTRUCTION

 **Combined Group**
Contracting Company

DESIGNER





SYSTRA

DRAWING NO.	REV.
RA140-22-BRG-CW-BS-32296	B2





QUANTITY TABLE OF REINFORCING BAR 1/2

SCALE : NONE

[illegible]

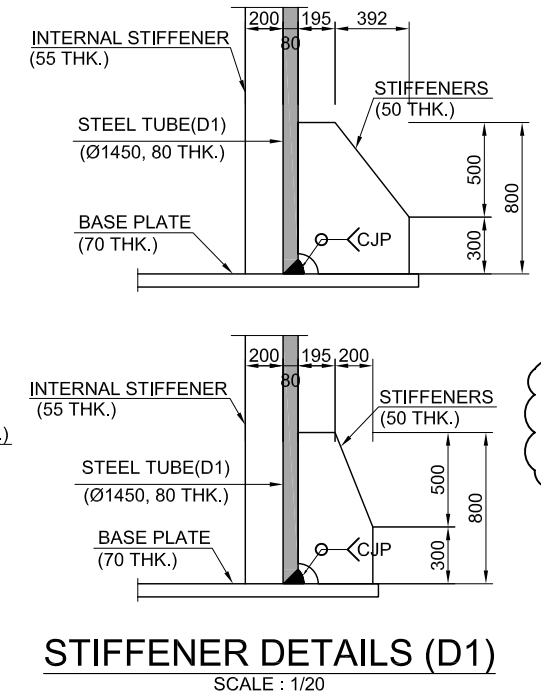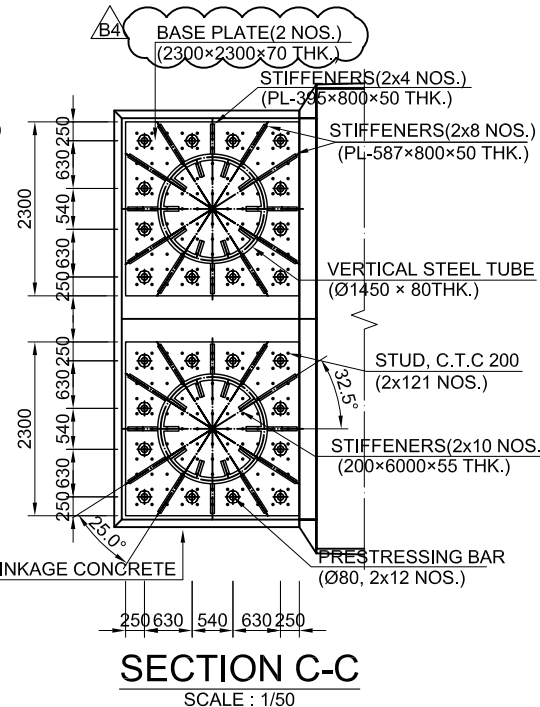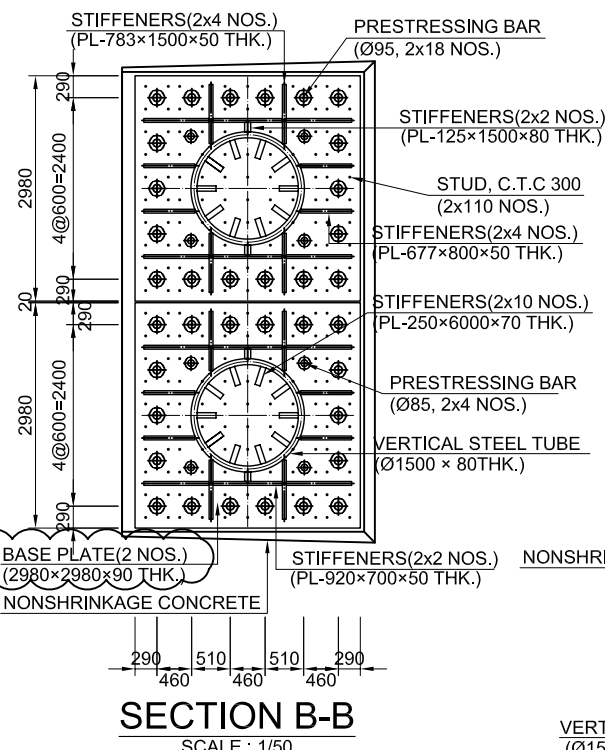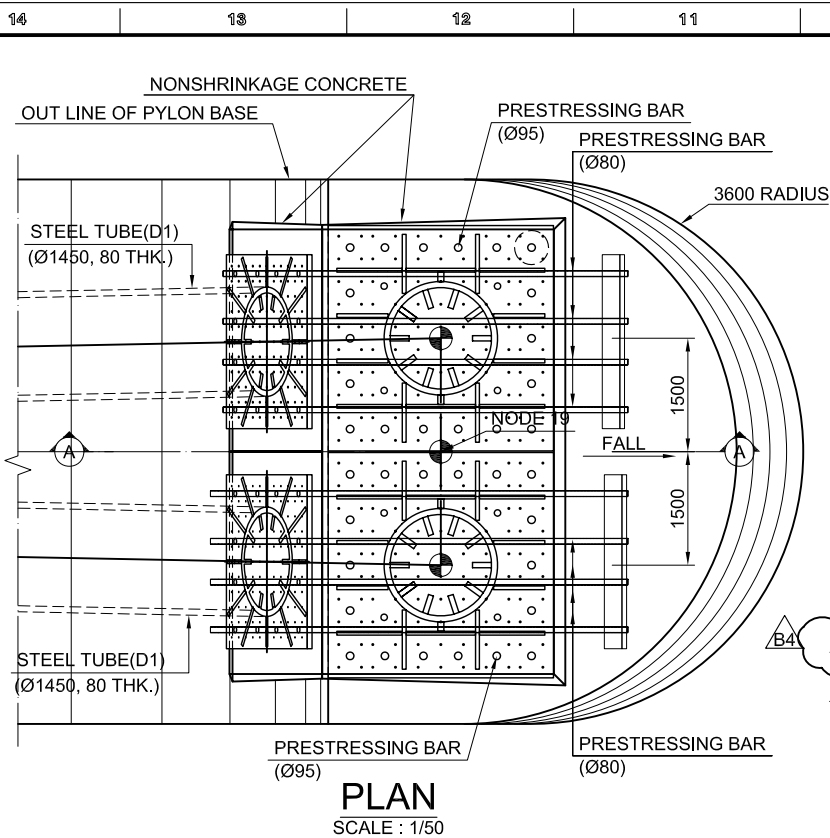

- NOTES:**
- ALL DIMENSIONS ARE IN MILLIMETERS AND ALL ELEVATIONS ARE IN METERS UNLESS OTHERWISE NOTED.
 - CONCRETE SHALL BE DESIGN MIX AND HAVE MINIMUM 28 DAYS CHARACTERISTIC STRENGTH(CYLINDER)
-PYLON PILE CAP : 40MPa
-PYLON BASE : 50MPa
 - STEEL MATERIALS:
REBAR IS $f_y=520\text{MPa}$
STUD CONNECTOR IS ASTM A36/A36M ($F_y=250\text{MPa}$)
 - PRESTRESSING BARS: $f_{pu}=1200\text{MPa}$
 - STEEL TUBE:
V1' ~ V6' AND H1 ~ H3 REQUIRED TO USE Z35,
V7' ~ V8' AND H4 REQUIRED TO USE Z25
 - THE SIZE OF HOLE IN BASE PLATE SHALL BE MADE 10MM LARGER THAN THE DIAMETER OF PRESTRESSING BAR FOR PRESTRESSING BAR GOING THROUGH THE PLATE.

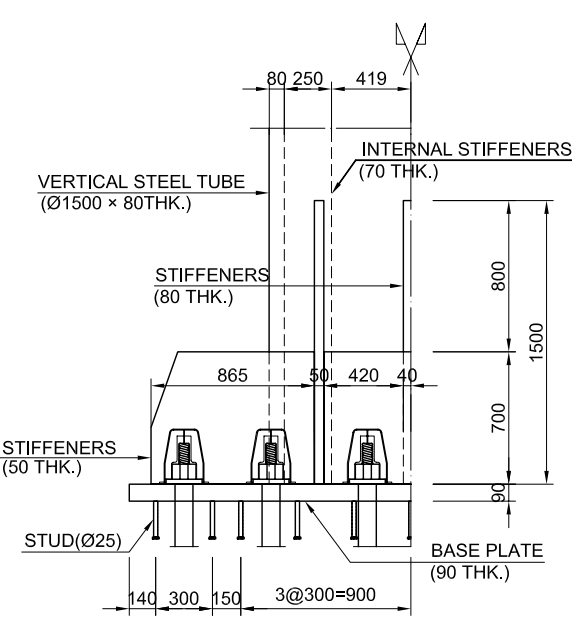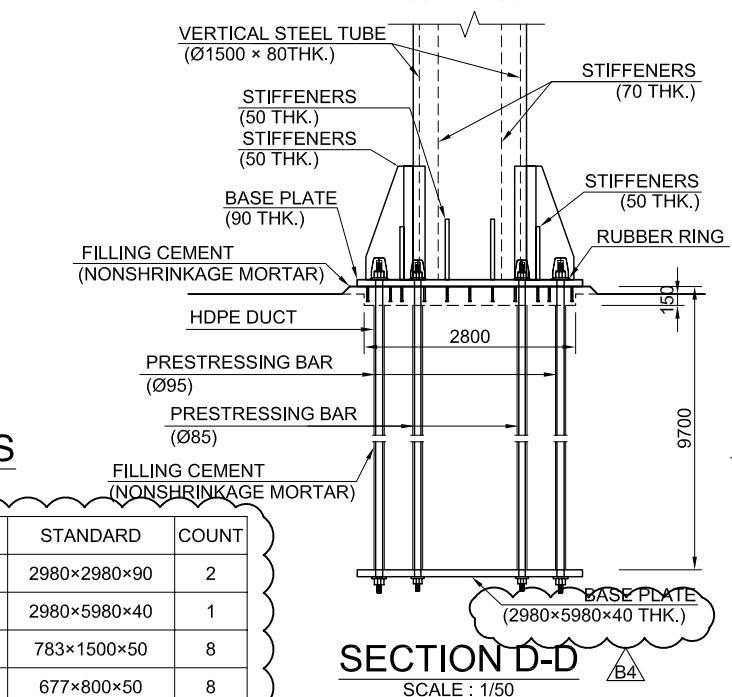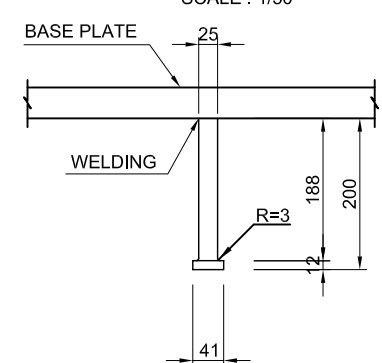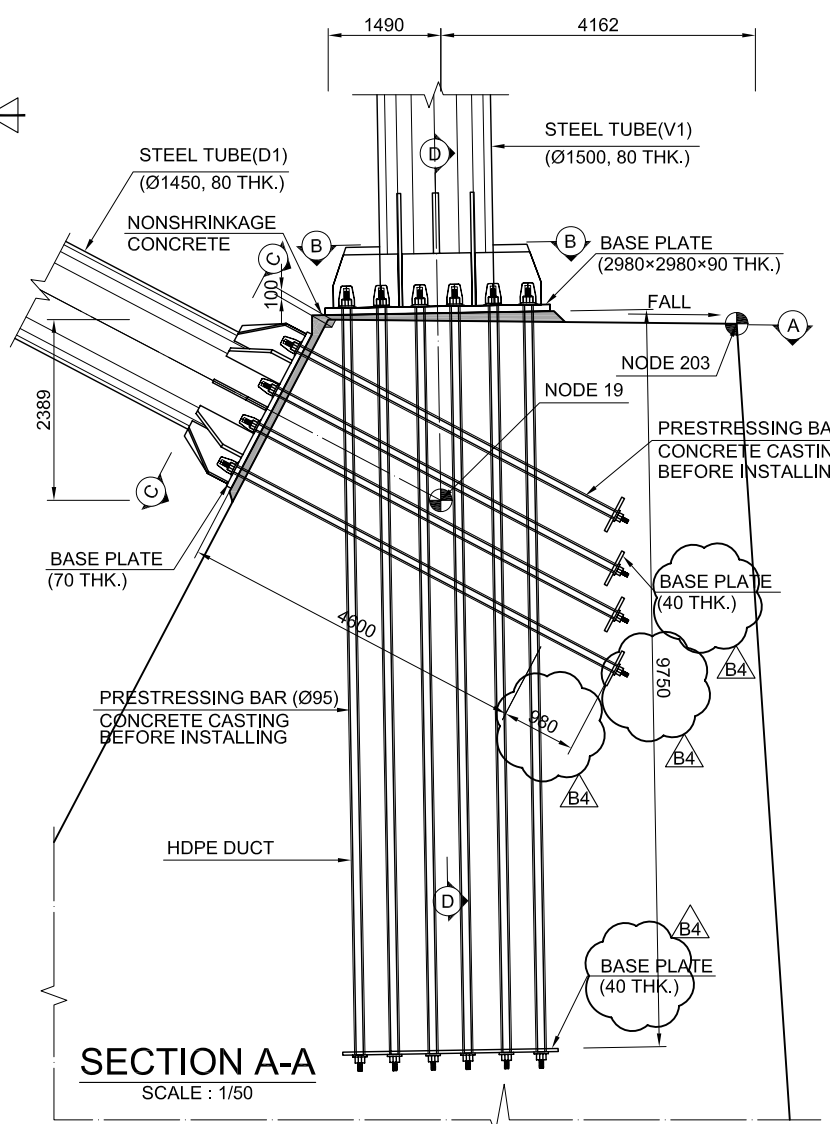


ID	UNITS	STANDARD	COUNT
V1	BASE PLATE	2980×2980×90	2
	BASE PLATE	2980×5980×40	1
	STIFFENERS	783×1500×50	8
	STIFFENERS	677×800×50	8
	STIFFENERS	920×700×50	4
	STIFFENERS	125×1500×80	4
	STIFFENERS	250×6,000×70	20
	PRESTRESSING BAR	@95	36
	PRESTRESSING BAR	@85	8
	STUD Ø25 L=200	C.T.C 300	220
D1	BASE PLATE	2,300×2,300×70	2
	BASE PLATE	500×2,300×40	4
	BASE PLATE	500×500×40	8
	STIFFENERS	587×800×50	16
	STIFFENERS	395×800×50	8
	STIFFENERS	200×6,000×55	20
	PRESTRESSING BAR	@80	24
	STUD Ø25 L=200	C.T.C 200	242

DIAMETER	Pu (kN)	Pjack (kN)
Ø95	8393	5875
Ø85	6709	4696
Ø80	5937	4156

- Pjack = 0.7 x Pu
(Pu : MINIMUM BREAKING LOAD)

JACKING FORCE
SCALE : NONE

QUANTITY TABLE OF STEEL
SCALE : NONE

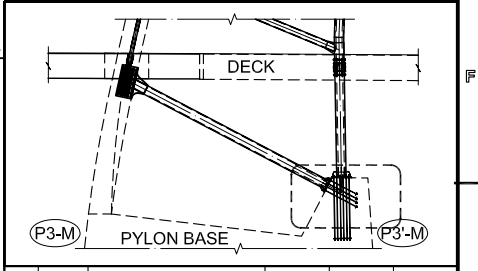

REV.	DATE	DESCRIPTION OF REVISION	DRAWN	CHEC.	APPRO.
B4	12/02/16	Updated As Shown In Clouds	SWK	HSK	DKK
B3	10/09/15	Updated As Shown In Clouds	SWK	HSK	DKK
B2	10/09/15	Updated As Shown In Clouds	SWK	HSK	DKK
A1	17/05/15	First Issue	SWK	HSK	DKK

EMPLOYER
STATE OF KUWAIT
MINISTRY OF PUBLIC WORKS
ROADS ADMINISTRATION

PROJECT TITLE
SHEIKH JABER AL AHMAD AL SABAH
CAUSEWAY PROJECT (MAIN LINK)
CONTRACT RA/140

DRAWING TITLE
MAIN BRIDGE
PILE CAP OF PYLON
ANCHORAGE DETAILS

SCALE	DRAWN	DESIGNED	CHECKED	APPROVED
AS SHOWN	SWK	DJB	HSK	DKK
DATE ISSUED	17/05/15	17/05/15	17/05/15	17/05/15

CONTRACTOR
HYUNDAI Engineering & Construction
Combined Group Contracting Company

DESIGNER
SYSTRA

DRAWING NO.
RA140-22-BRG-CW-DW-32299

REV.
B4